
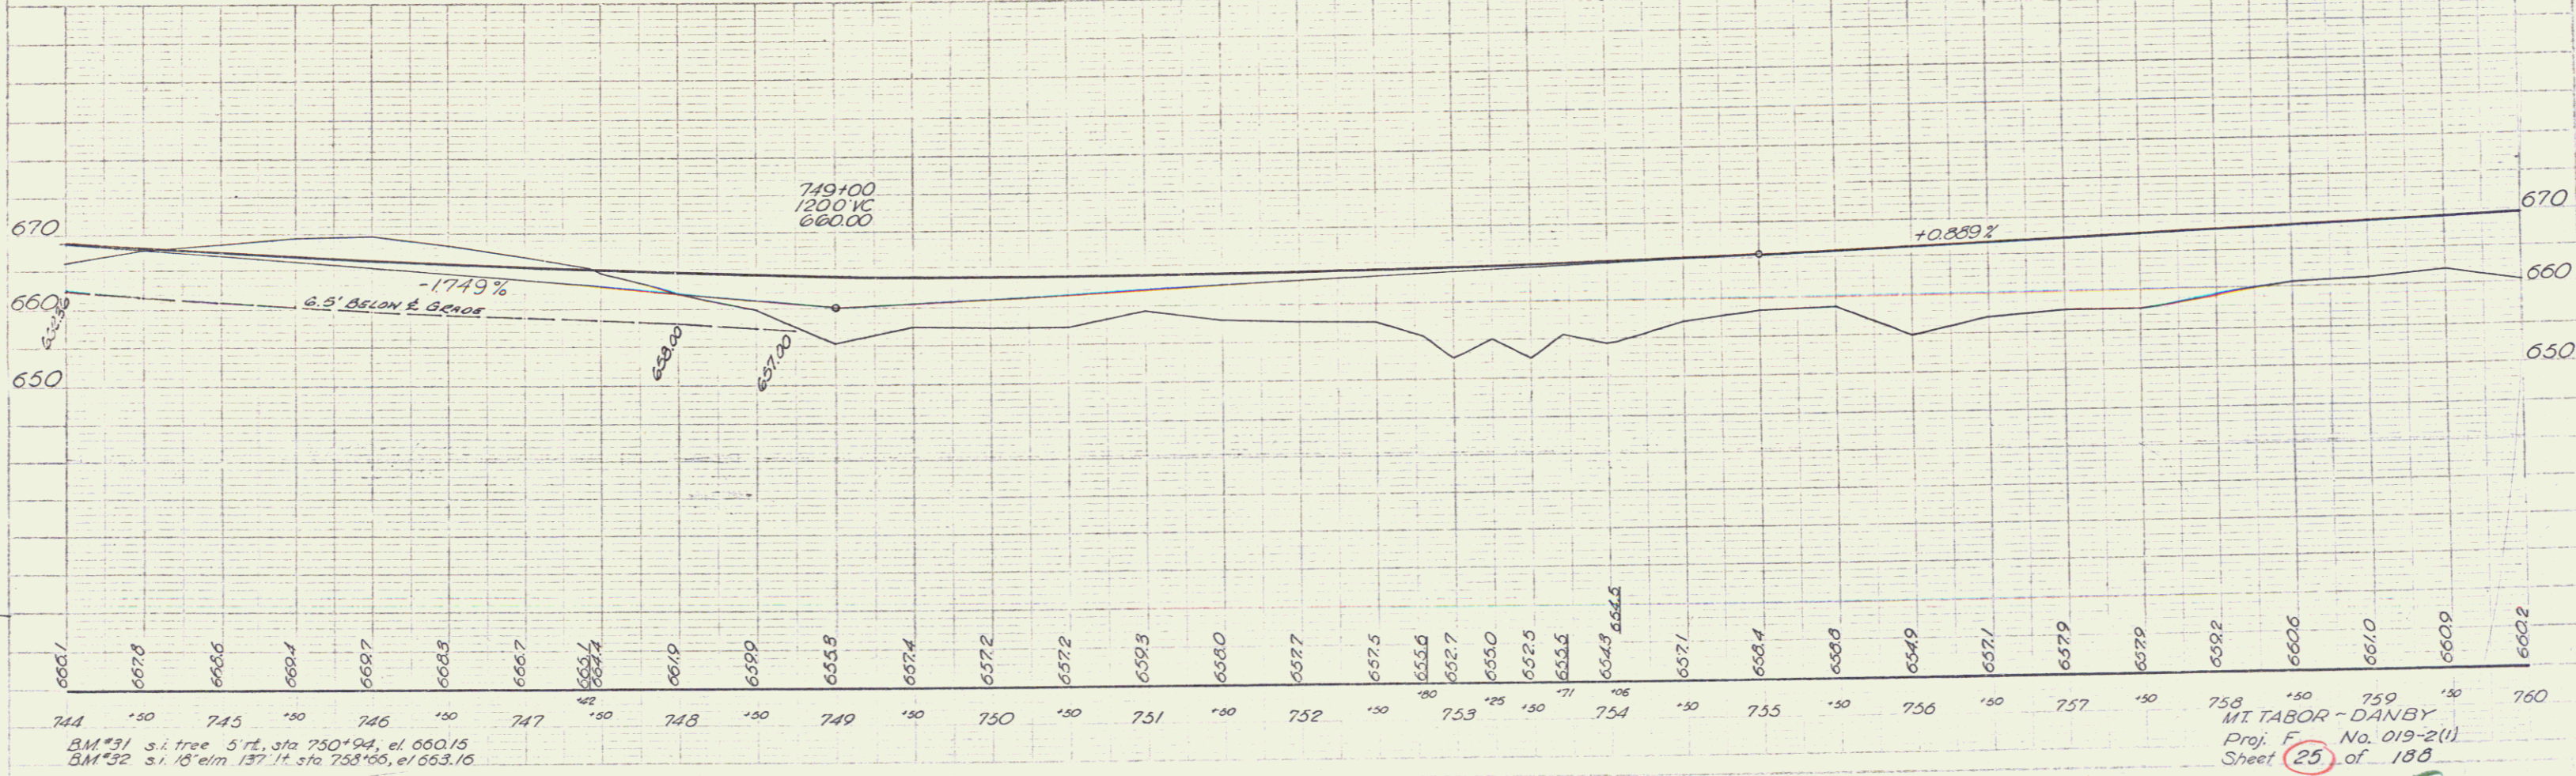


SHILOH
MILLER
1/24
1/75

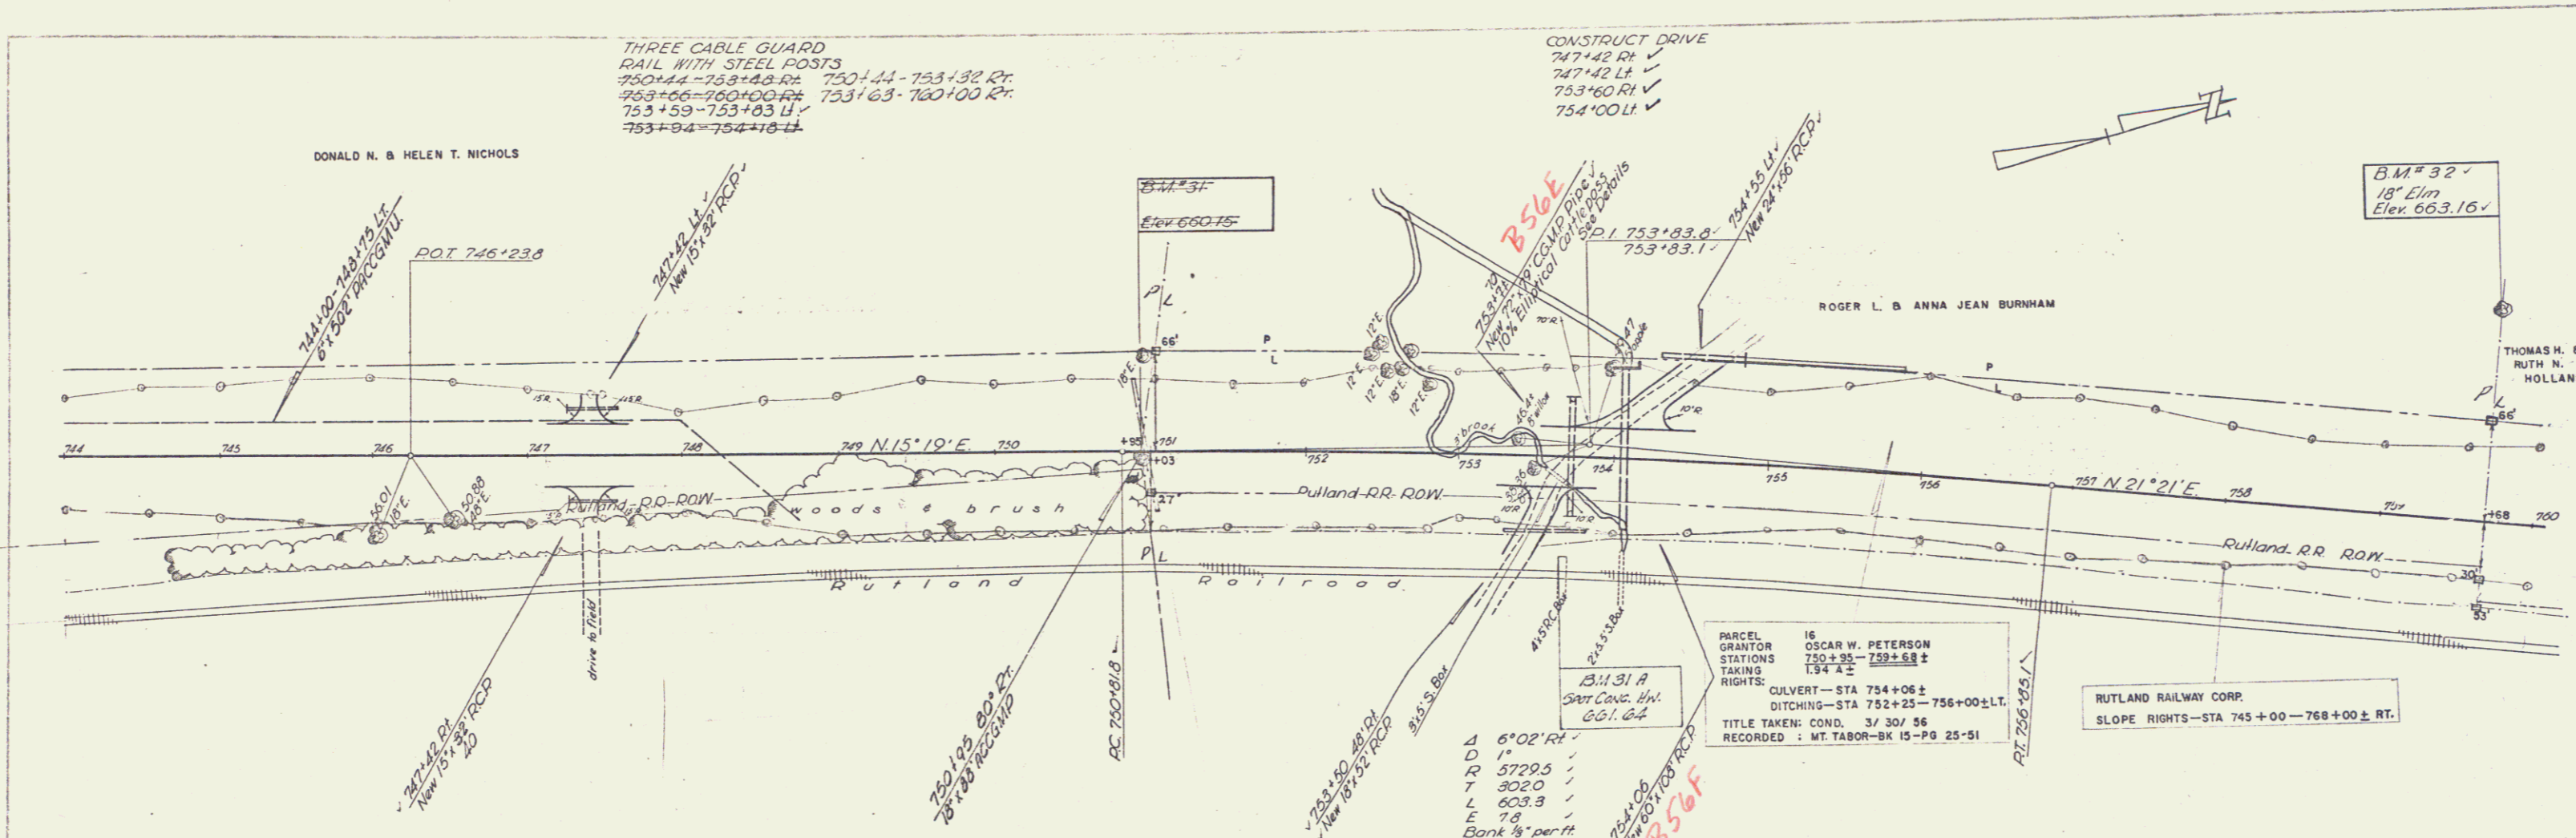

BM #31 s.i. tree 5 ft. sta 750+00, el. 660.15
 BM #32 s.i. 18" elm 137 ft. sta 753+00, el. 663.16

MT. TABOR - DANBY
 Proj. F No. 019-2(1)
 Sheet 25 of 188

15