
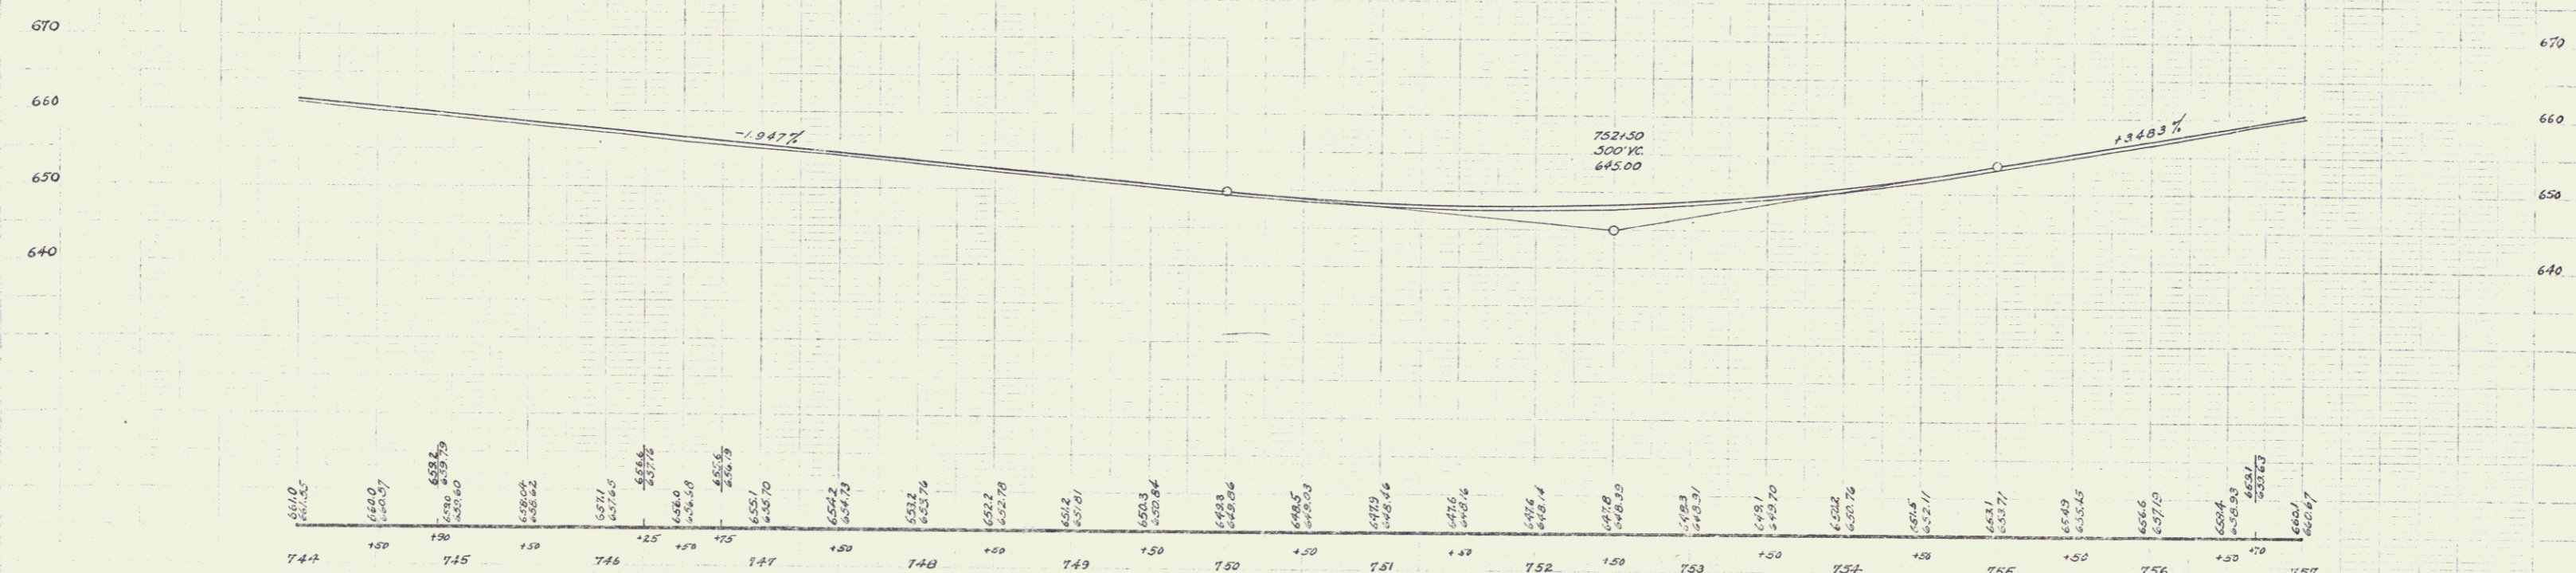


FED. ROAD DIST. NO.	STATE	FED. ROAD PROJ. NO.	FISCAL YEAR	SHEET NO.	TOTAL SHEETS
5	VT.	25-0	1937	6	8

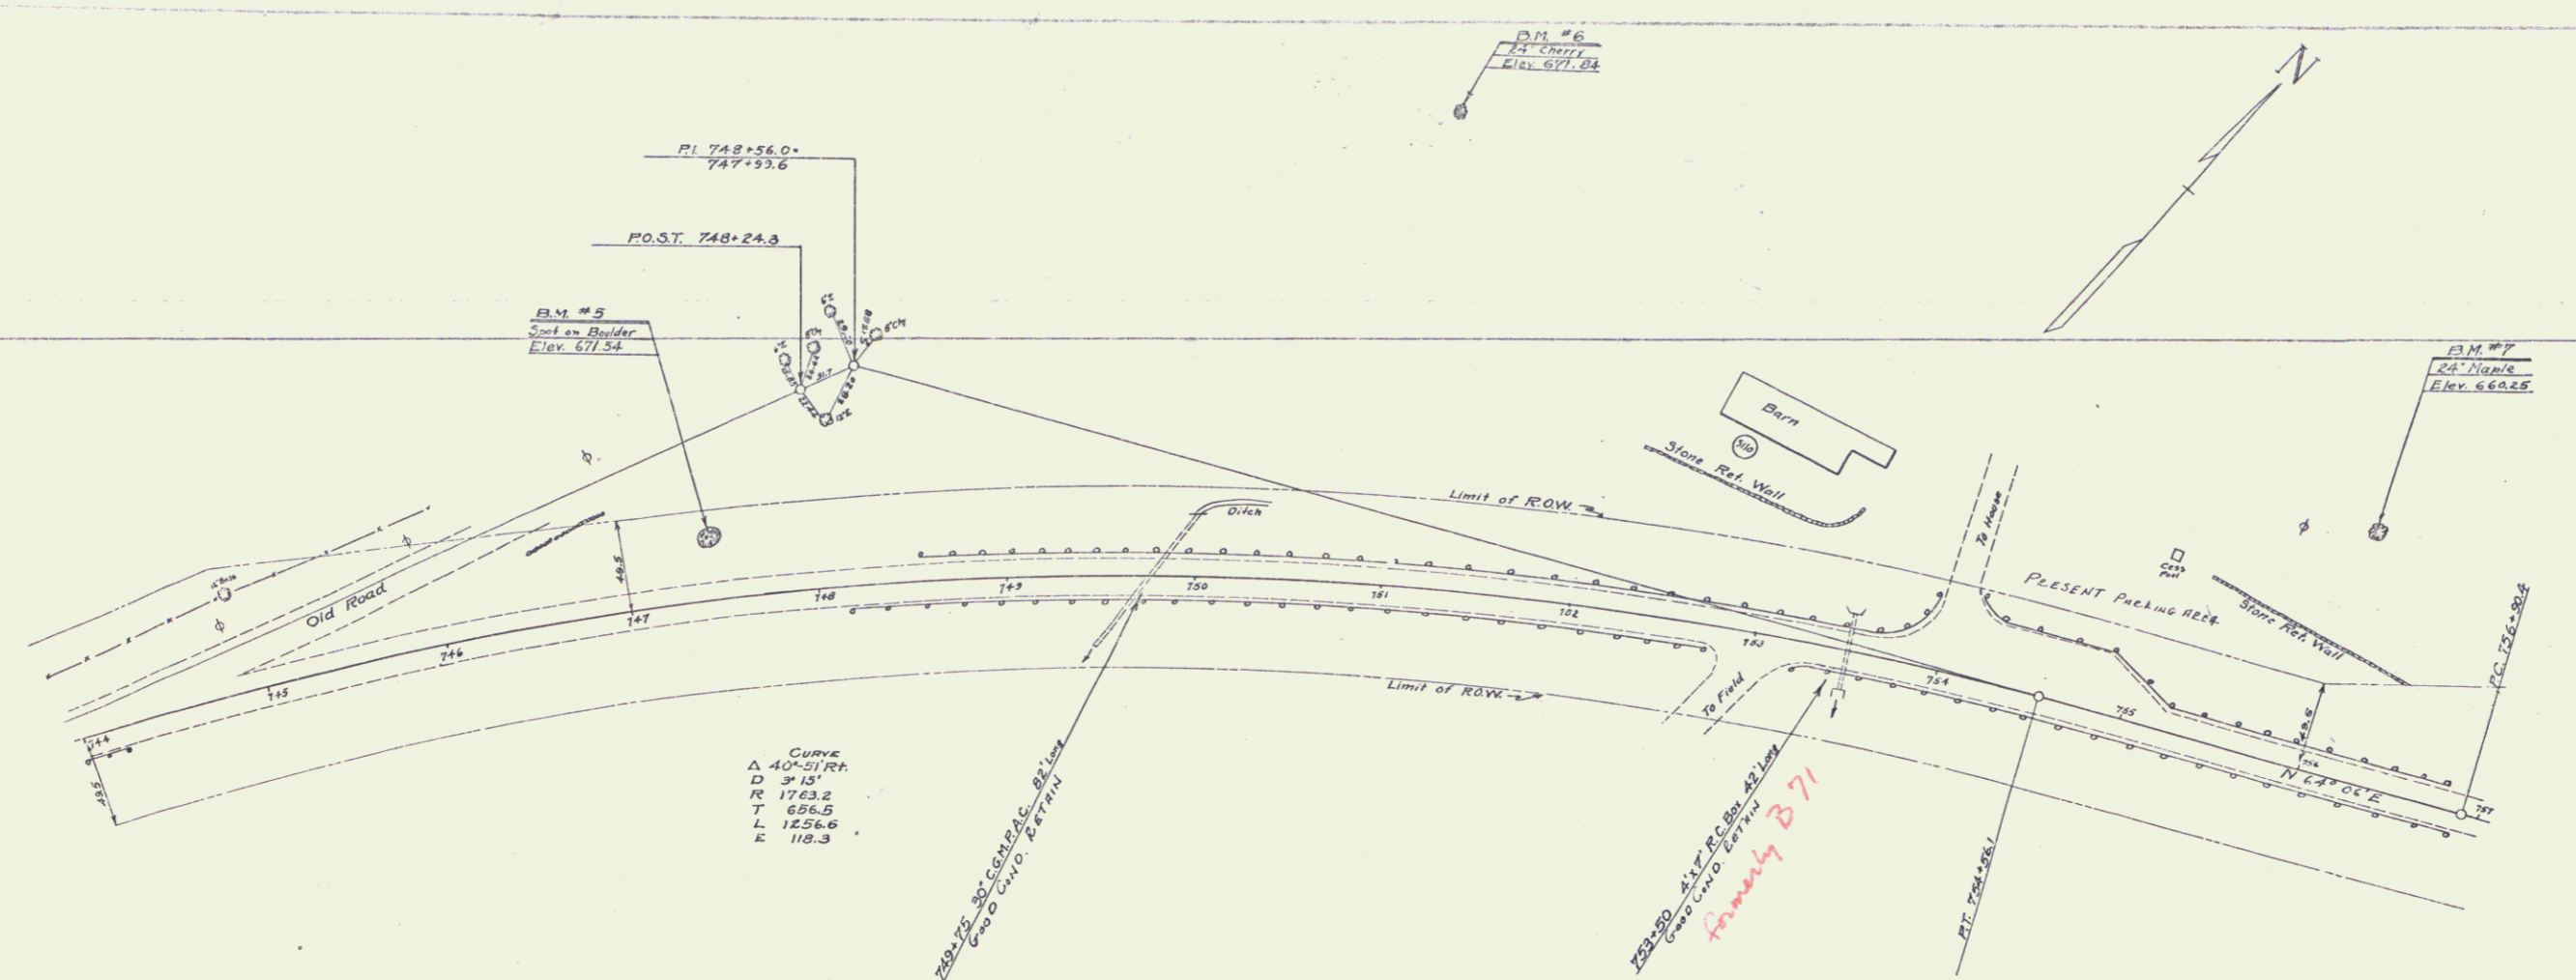

B.M. #5 PAINT SPOT ON BOULDER 29 FT. LT. OF STA. 747+46 ELEV. 671.54
 B.M. #6 SPIKE IN ROOT OF 24 CHERRY 253 FT. LT. OF STA. 751+16 ELEV. 671.84
 B.M. #7 SPIKE IN ROOT OF 24 MAPLE 134 FT. LT. OF STA. 756+00 ELEV. 662.25

SERIES FDP NO 75 D
 SHEET 6 OF 8