

INDEX OF SHEETS

SHEET NO. 1	TITLE PAGE
2	TYPICAL CROSS-SECTION OF IMPROVEMENT One Course Concrete Cur. 12' (Item 25)
3	BANKING AND WIDENING TABLES
4-5	PLAN AND PROFILE STA.
10	Standard Structure Sheet, 5-28 Drop Inlets
11	5-30 34" Underdrains & C&M Walls
12	5-31 Concrete Curb
13	5-40 Barricades, Lights, etc

Standard Structure Sheets approved by the Chief Engineer

5-28; July 11, 1933
 5-30; Aug 15, 1933
 5-31; July 23, 1934

FED. ROAD DIST. NO.	STATE	FED. AID PROJ. NO.	FISCAL YEAR	SHEET NO.	TOTAL SHEETS
9	Vt.	75C	1937	1	13

STATE OF VERMONT
 STATE HIGHWAY DEPARTMENT

PLAN AND PROFILE OF PROPOSED
 STATE HIGHWAY



FEDERAL AID PROJECT

TOWN OF WALLINGFORD Pin # 99R487

MANCHESTER — RUTLAND ROAD

FROM A POINT 1150 FT. SOUTH OF THE INTERSECTION OF THE TOWN ROAD TO THE DEPOT IN SOUTH WALLINGFORD VILLAGE NORTHERLY 1.339 MILES TO A POINT 7350 FT. SOUTH OF THE INTERSECTION OF THE TOWN ROAD TO EAST WALLINGFORD.

LENGTH OF PROJECT: 7072.0 FEET = 1.339 MILES

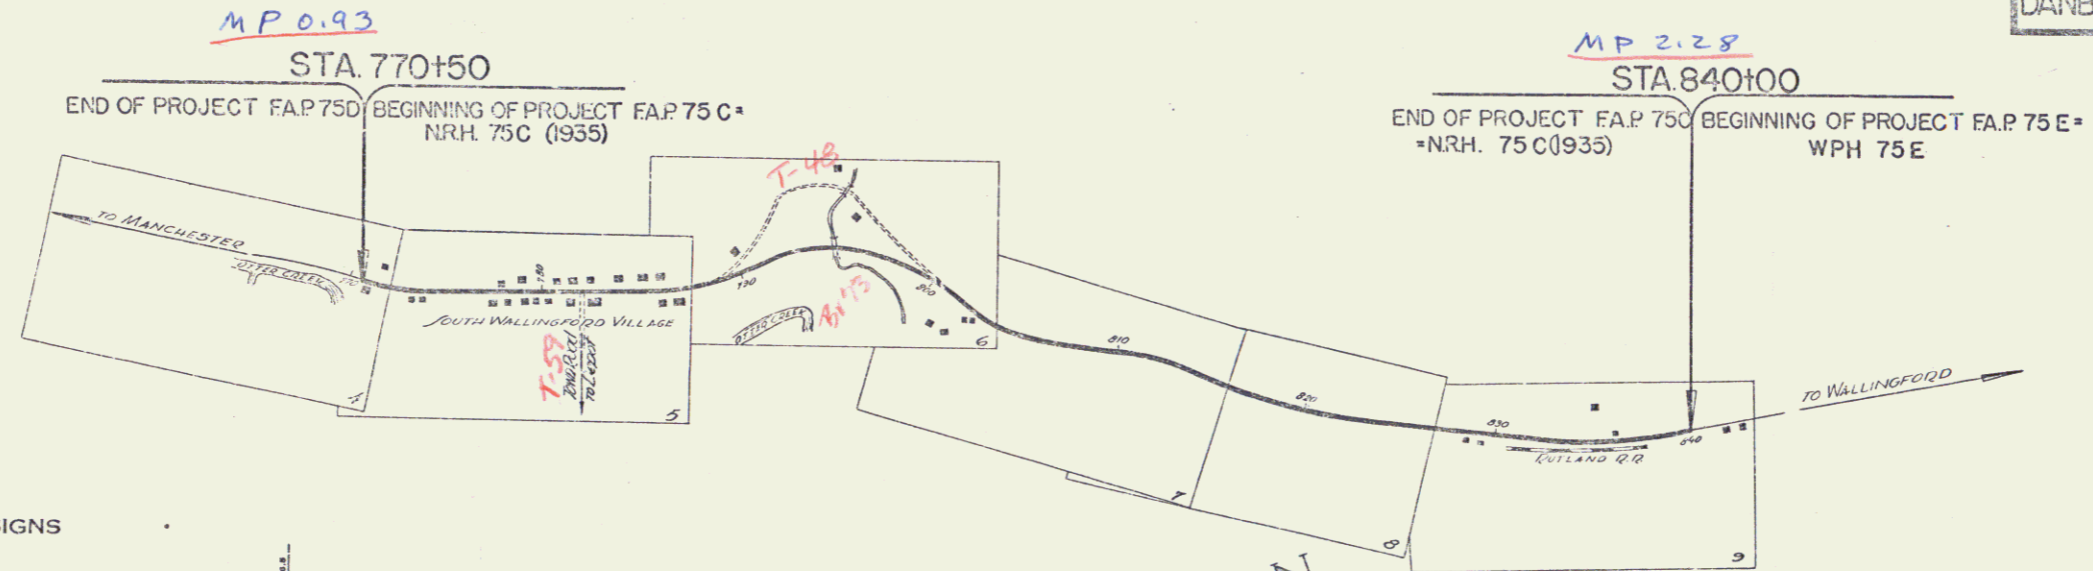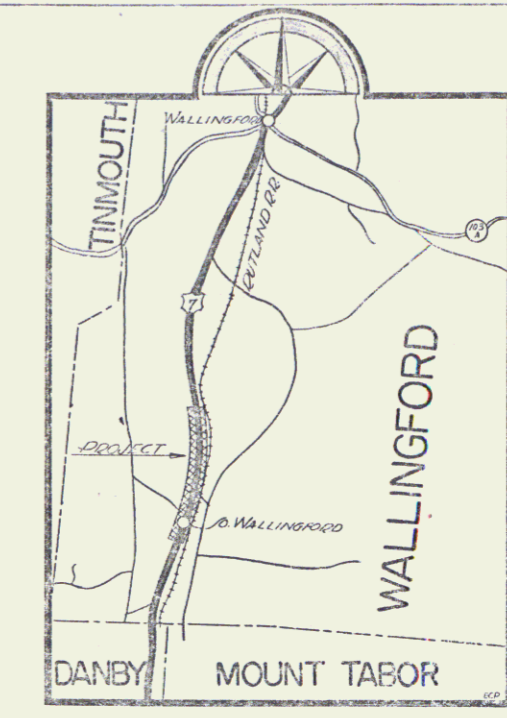

APPROVED: *H. H. Houghton*
 COMMISSIONER OF HIGHWAYS
 SUBMITTED BY ORDER OF THE STATE HIGHWAY BOARD

Rte. U.S. 7

CONVENTIONAL SIGNS


COUNTY LINE	-----
TOWN LINE	-----
FENCE LINE	-----
STONE WALL	-----
UNFENCED PROPERTY	-----
GUARD RAIL	-----
TRAVELLED WAY	-----
RAILROAD	-----
RETAINING WALL	-----
CENTER LINE	-----
SURVEY LINE	-----
CULVERT	-----
DROP INLET	-----
TROLLEY POLE	-----
POWER POLE	-----
TELEPHONE POLE	-----
TREES	-----
HEDGE	-----

GROUND ELEVATION	DATUM	LINE
GRADE ELEVATION	DATUM	LINE

CURVE DATA	
DEFLECTION ANGLE	Δ
DEGREE OF CURVE	D
RADIUS OF CURVE	R
TANGENT DISTANCE	T
LENGTH OF CURVE	L
EXTERNAL DISTANCE	E
POINT OF INTERSECTION	P. I.
POINT OF CURVE	P. C.
POINT OF TANGENT	P. T.
POINT ON TANGENT	P. O. T.

SCALES

TITLE	1" = 50'
TYPICAL	1" = 25'
PLAN	1" = 200'
PROFILE	1" = 20'
CROSS SECTIONS	1" = 5'

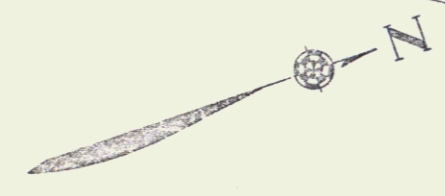

These plans are subject to revisions as may be required by the Bureau of Public Roads or the Commissioner of Highways. Construction is to be carried on in accordance with the plans and Standard Road & Bridge Specifications of 1930 including all subsequent amendments and such revised specifications and special provisions as may be submitted with the plans.

Project No. F.A.P. 75C / N.R.H. 75C

RECOMMENDED: [Signature]
 DISTRICT ENGINEER BUREAU OF PUBLIC ROADS

RECOMMENDED FOR APPROVAL: [Signature]
 CHIEF ENGINEER BUREAU OF PUBLIC ROADS

APPROVED: [Signature]
 DIRECTOR - BUREAU OF PUBLIC ROADS

SERIES F.A.P. NO. 75C FILED
 SHEET 1 OF 13