



N.R.H.
 75C 1934 B 47
 (1935)
 75C 1936 B 10

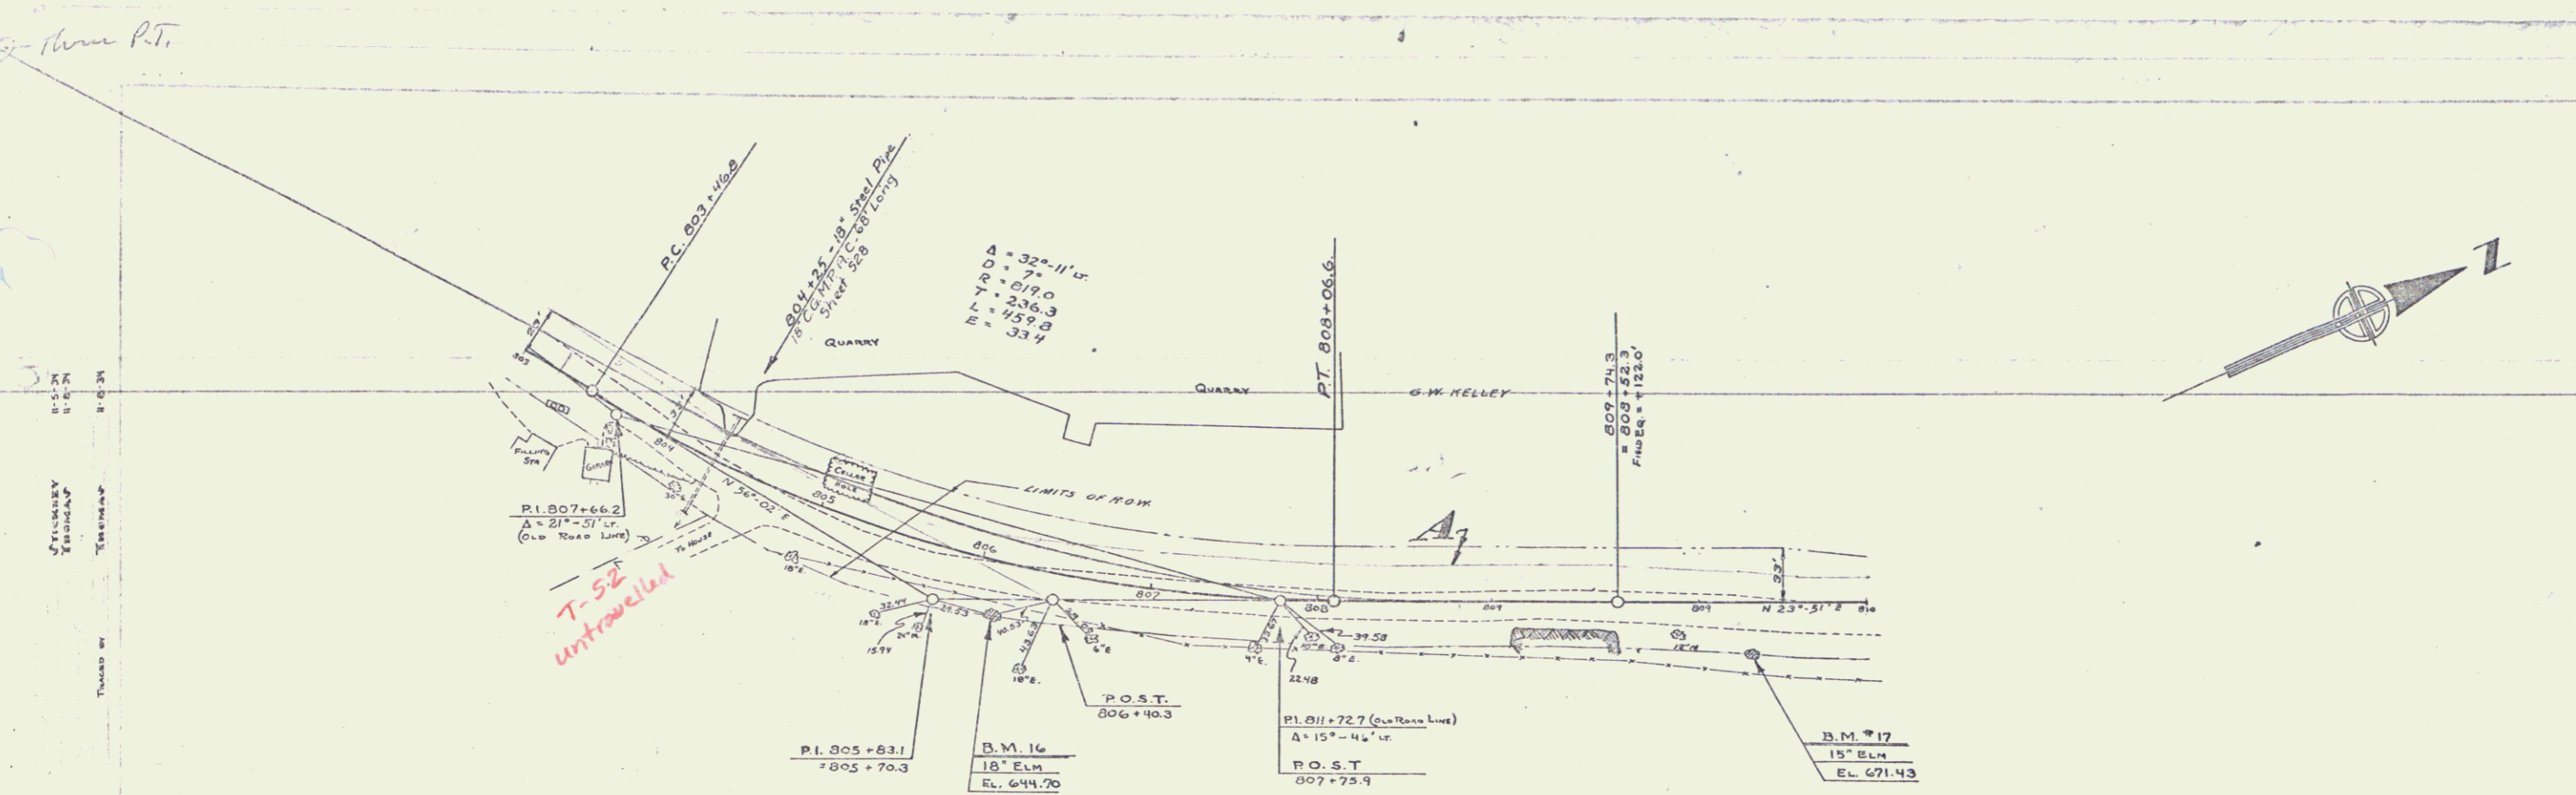

PARCEL	INSTRUMENT	DATE	GRANTOR	GRANTEE	RECORDED	REMARKS
A-B	M.D.	4-10-35	GEO. W. KELLEY	TOP V. 25	172	4-10-35 783130 & 002160

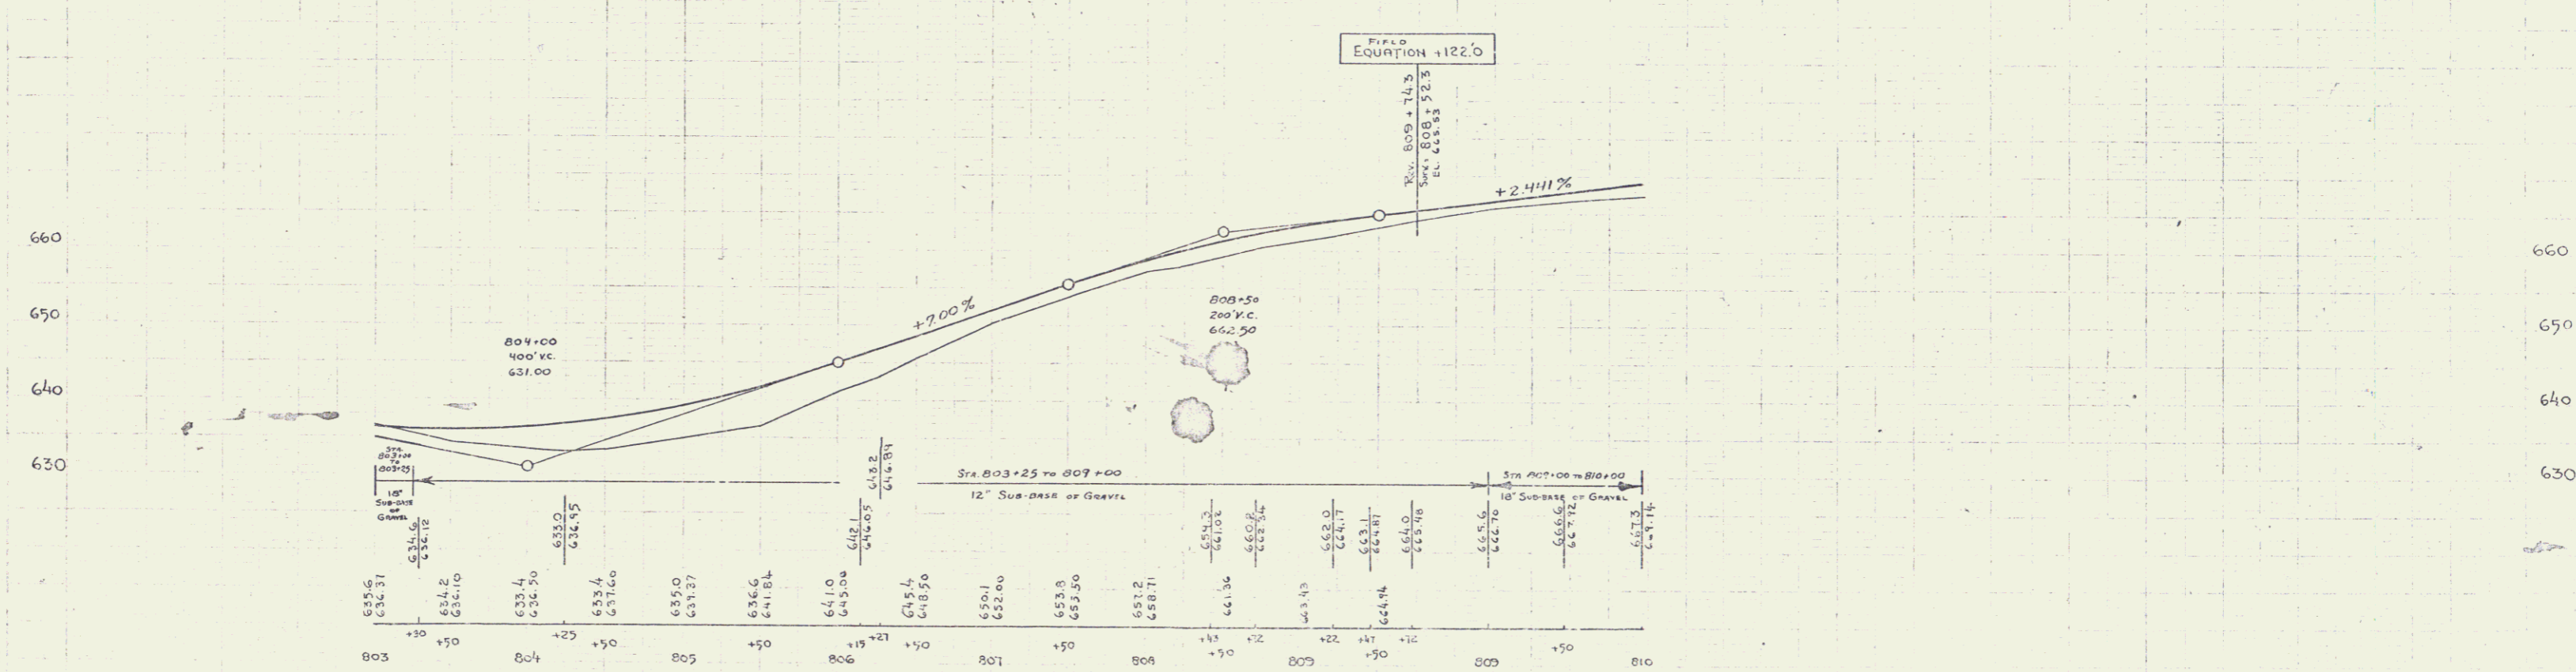

B.M. 16 - Spike in Root 16' Elm, 30' W. STA. 806+16 Elev. 644.70
 B.M. 17 - Spike in Root 15' Elm, 26' W. STA. 809+25 Elev. 671.43

Series N.R.H. No. 75C (1935)
 Street B of 47
 Series T.P. No. 75C
 Sheet B of 10