


PLAN
PROPOSED
DATE
BY
NO.

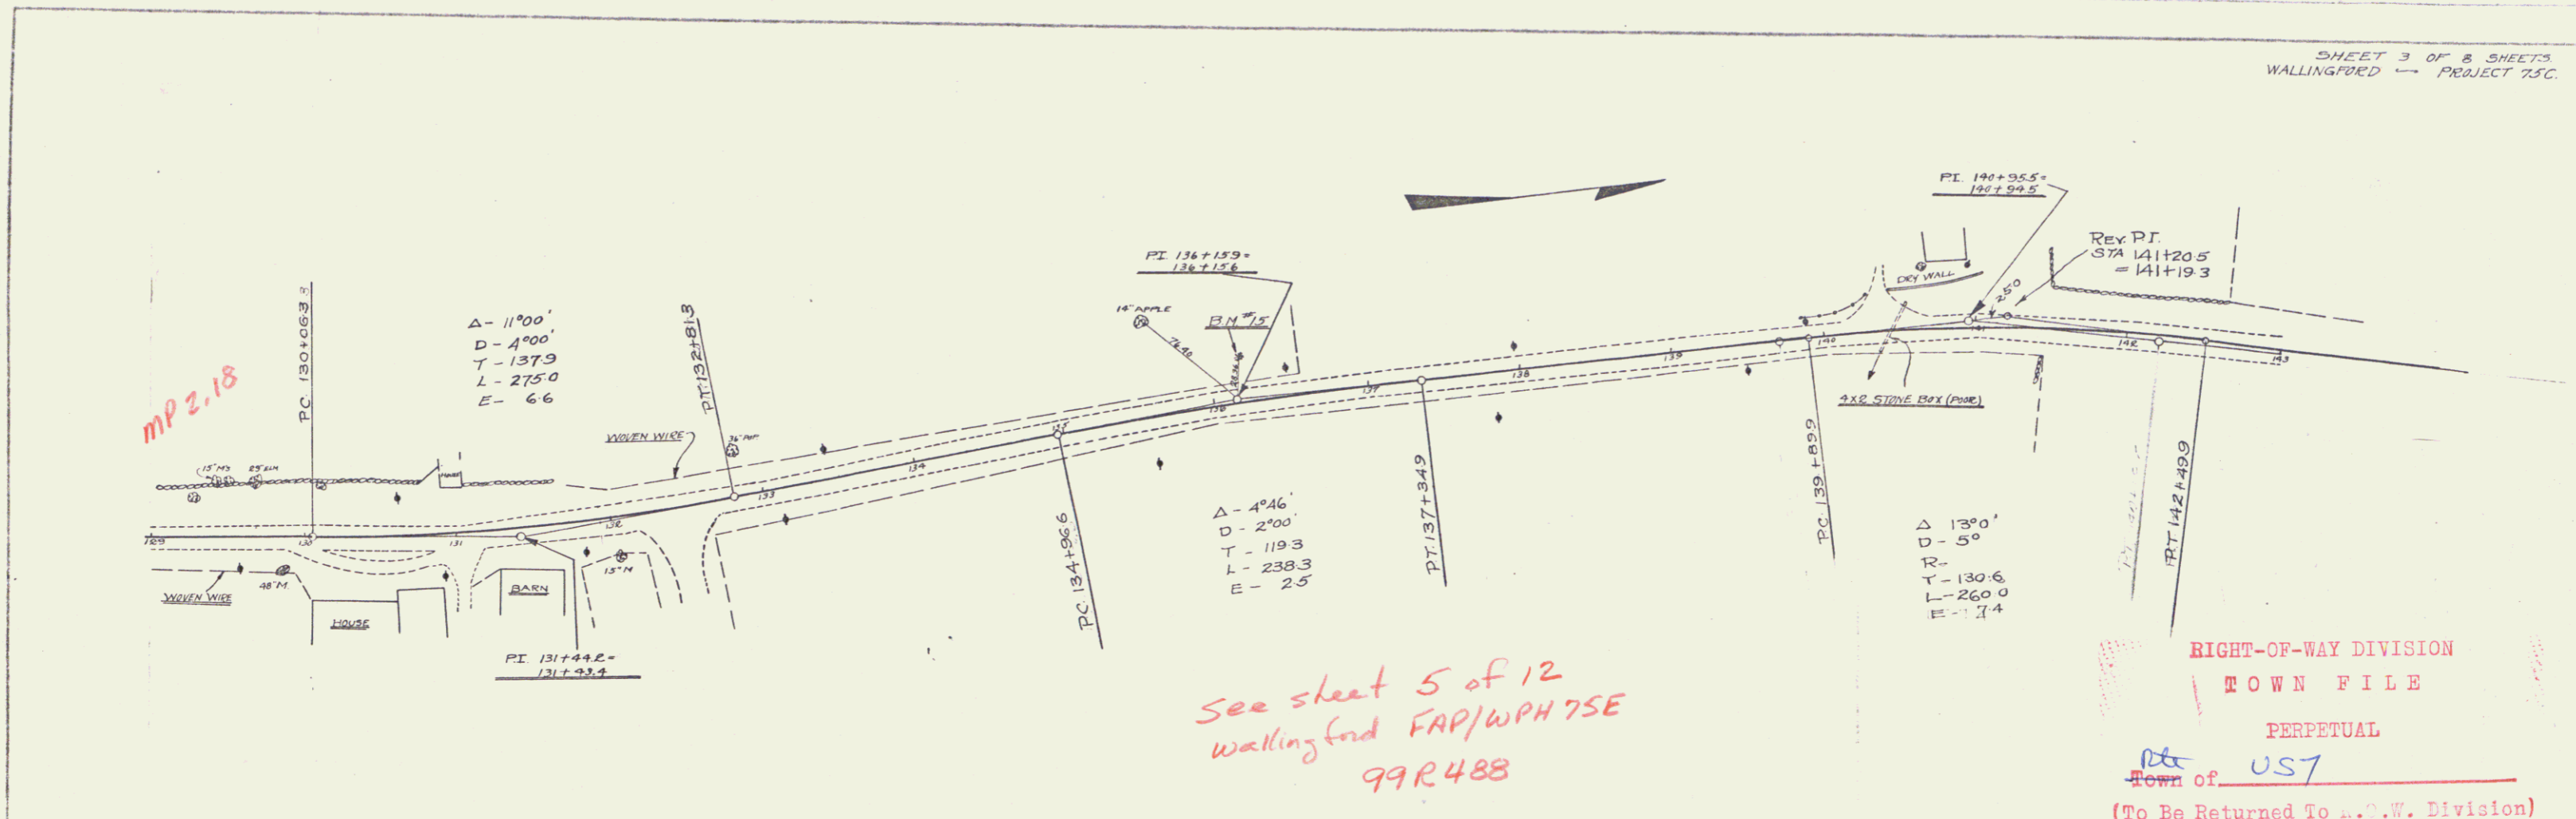

See sheet 5 of 12  
Wallingford FAP/WPH 75E  
99R488

RIGHT-OF-WAY DIVISION  
TOWN FILE  
PERPETUAL  
Town of US7  
(To Be Returned To R.O.W. Division)

