


See FAP 75E

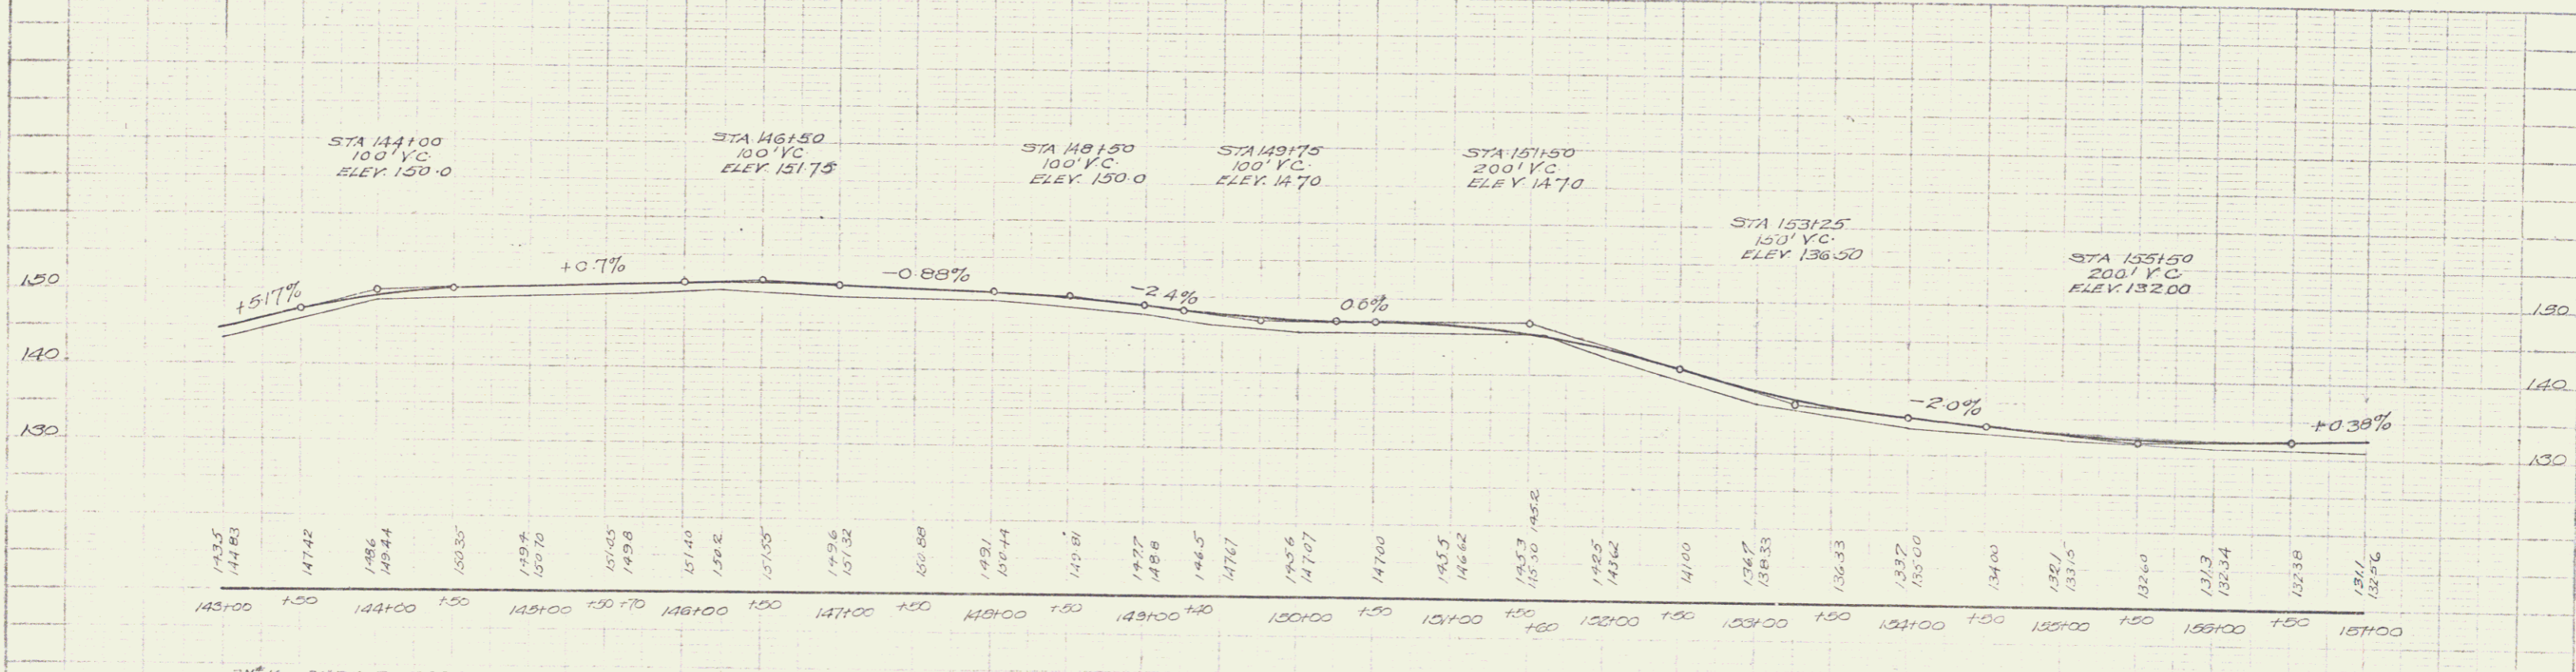

BM #16 30' E.L.M. RIGHT OF STA 148+25, ELEV. 149.29
BM #17 POWER POLE, RIGHT OF STA 155+67, ELEV. 132.23