

1	TITLE SHEET	101	F-2	GALVANIZED CHAIN LINK FENCE
2-4	TYPICAL SHEETS	102	F-3	ALUMINUM ALLOY CHAIN LINK FENCE
5	ALIGNMENT SHEET	103	G-1	STEEL BEAM GUARD RAIL
6-7	QUANTITY SHEET	104	G-3	THREE CABLE GUARD RAIL
8-11	DRAINAGE SHEETS	105	G-3A	DEAD END ANCHORAGE AT BRIDGE APPROACH
12-22	EARTHWORK SHEETS	106	G-4	STEEL MARKER POSTS AND PLANK GUARD RAIL
23-26	P.O.W. DETAIL SHEETS	107	G-5	CEDAR LOG GUARD RAIL
27-60	PLAN AND PROFILE SHEETS	108	J-1	PROJECT AND BOUNDARY MARKERS
61-62	20 SCALE OF REST AREAS	109	BLANK	
63-54	TRAFFIC SIGN SUMMARY SHEETS	110	DETAILS OF 2 LANE TO 4 LANE TRANSITION	
65	GUIDE SIGN AND DELINEATOR LOCATION SHEET	111	DETAILS OF 2 LANE TO 4 LANE TRANSITION	
66-67	SIGN AND DELINEATOR PLACEMENT SHEETS	112-115	DETAILS OF 10" ROUND PLATE PIPE AT STA. 185+75	
68	TRAFFIC SIGN, DESIGN AND DETAIL SHEET	116-118	DETAILS OF REINFORCED CONCRETE CATTLE PASS AT STA. 218+50	
69	A-61 DRILLING AND BLASTING	119-121	DETAILS OF REINFORCED CONCRETE CATTLE PASS AT STA. 332+00	
70	B-1 BANKING TABLES	122-144	BRIDGE SERIES 100	
71	B-5 TYPICAL SLOPE GRADING	145	SCB-30-65	
72	B-6 MUCK EXCAVATION	146-154	SCB-D1 THRU D9-65	
73	B-10 EMBANKMENT ON A SLOPE	155-156	SB-R1-64 SHEETS 1 & 2	
74	B-11 METHODS OF SLOPE STABILIZATION	157	SB-R2-65	
75	B-15 ENTRANCE AND EXIT TERMINALS	158-305	MAINLINE CROSS SECTION SHEETS	
76	B-16 TRIANGULAR ISLAND DESIGN	306-320	SIDELINE CROSS SECTION SHEETS	
77	B-17 DETAILS OF REST AREAS	321-328	CHANNEL CROSS SECTION SHEETS	
78	C-1 CURBS			
79	C-1A CURBS			
80	D-2 HEADWALLS AND UNDERDRAIN			
81	D-3 GUTTERS AND JUTE MATTING			
82	D-4 FLUSHING BASINS AND ELBOWS			
83	D-8 DROP INLETS			
84	D-10 DROP INLET TOPS			
85	D-11 DROP INLET GRATES			
86	D-13 CATCH BASINS			
87	D-16 DROP INLET GRATES			
88	D-17 VERTICAL RISERS			
89	E-1 BARRICADES, SIGNS AND LIGHTS			
90	E-12 U.S. ROUTE MARKERS			
91	E-13 STATE ROUTE MARKERS AND AUXILIARY MARKERS			
92	E-14 REGULATORY SIGNS			
93	E-15 REGULATORY SIGNS			
94	E-16 WARNING SIGNS			
95	E-17 GUIDE SIGNS			
96	E-18 GUIDE SIGNS			
97	E-19 STANDARD SIGN PLACEMENT			
98	E-20 DELINEATORS, HAZARD MARKERS			
99	E-21 GROUND MOUNTED SIGN SUPPORTS			
100	F-1 PROPERTY LINE FENCE WITH STEEL POSTS			

STATE OF VERMONT
DEPARTMENT OF HIGHWAYS


TOWNS OF WALLINGFORD AND CLARENDON
COUNTY OF RUTLAND

U.S. ROUTE 7 *Pin # 99R494*




MANCHESTER-RUTLAND ROAD

BEGINNING AT A POINT 0.338 MILE SOUTH OF THE WALLINGFORD-CLARENDON TOWN LINE AND EXTENDING NORTHERLY 3.650 MILES.
LENGTH OF ROADWAY 18,948.065 FEET = 3.589 MILES
LENGTH OF BRIDGE 32,350 FEET = 0.061 MILE
LENGTH OF PROJECT 19,271.565 FEET = 3.650 MILES

ADT (1966) 3170 - 3250
ADT (1986) 5120 - 5250
DHV (1986) 690 - 740
D 60%
T 6%
V 60 MPH

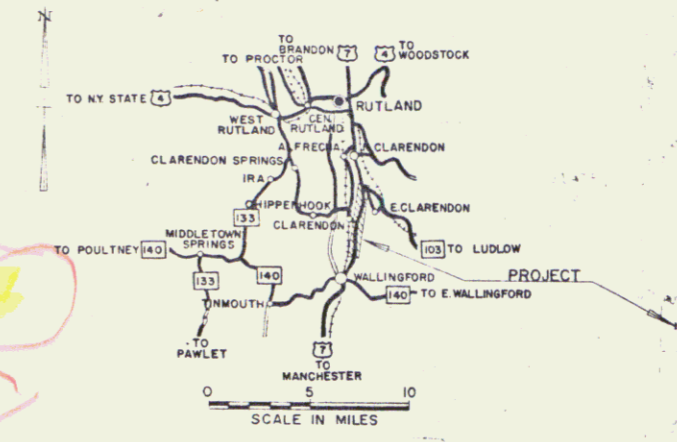

Handwritten: 11-7-8

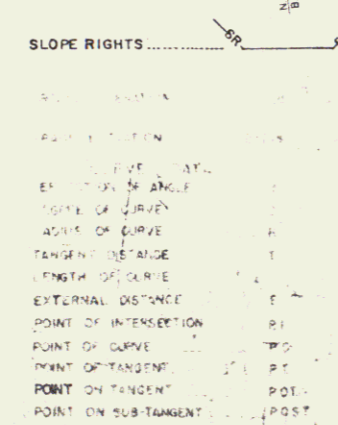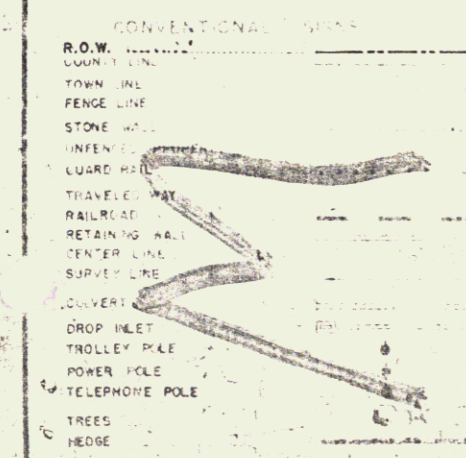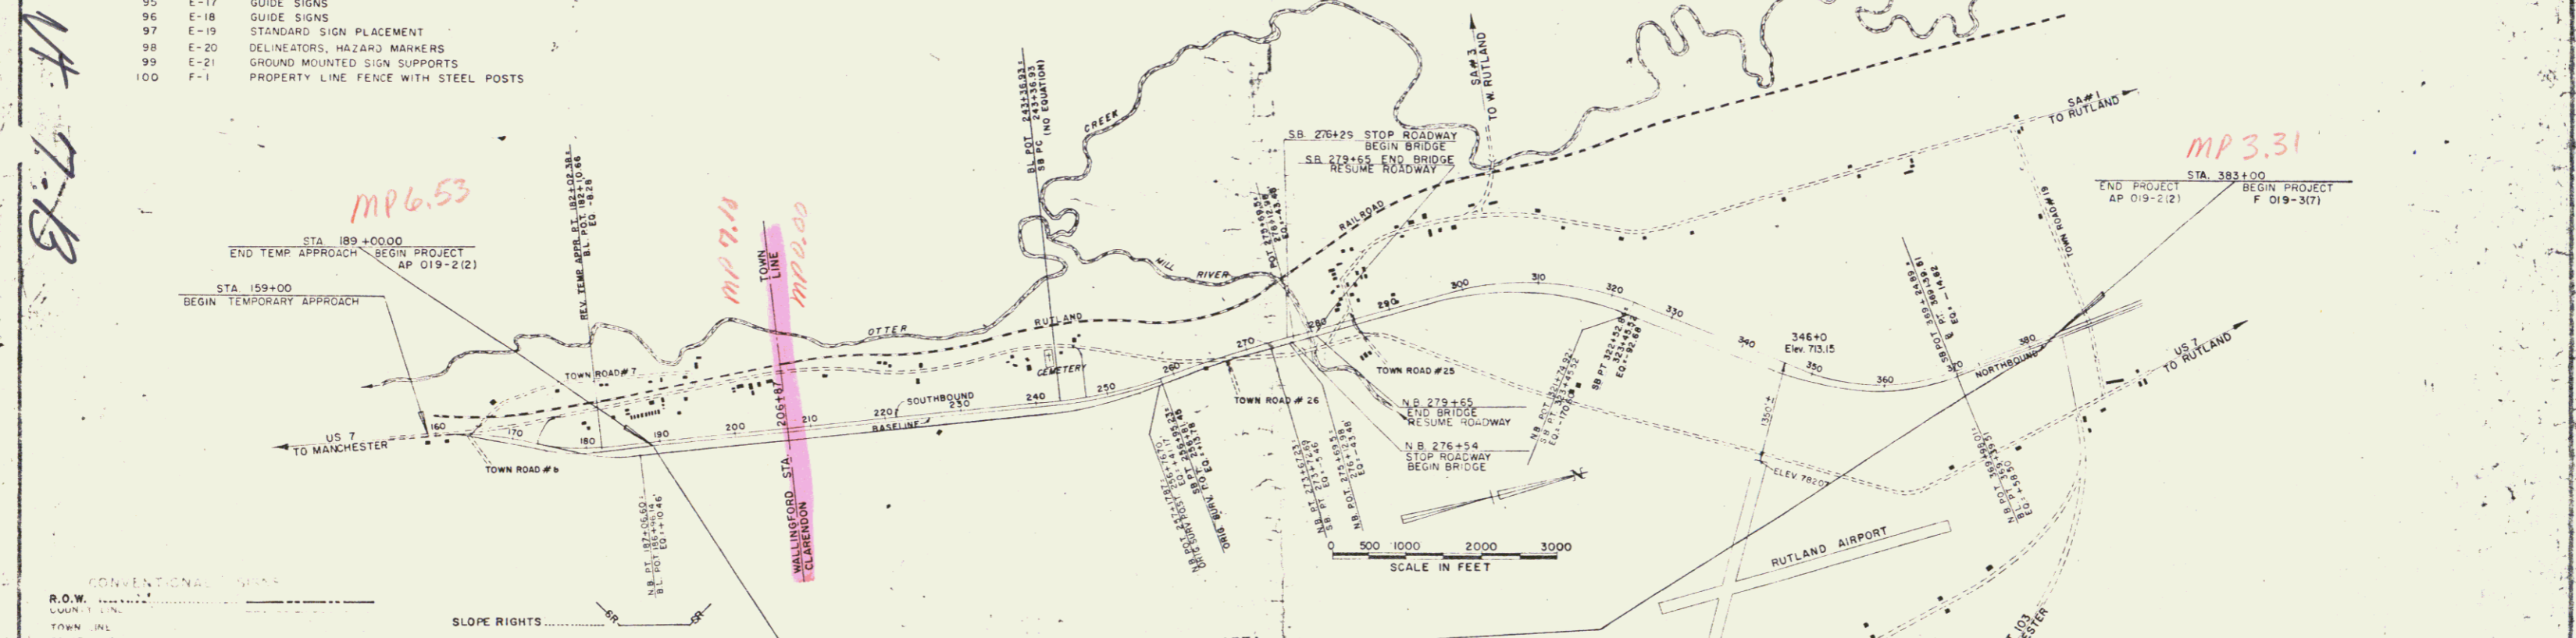

CONSTRUCTION AREA
U.S. ROUTE 7 & TOWN ROADS NOT IN
CONSTRUCTION AREA, EXCEPT FOR CROSSINGS

RIGHT-OF-WAY DIVISION
TOWN FILE
PERPETUAL

Town of _____
(To Be Returned To R.O.W. Division)

THESE PLANS ARE SUBJECT TO SUCH REVISIONS AS MAY BE
REQUIRED BY THE BUREAU OF PUBLIC ROADS OR THE DIVISION
OF HIGHWAYS.
CONSTRUCTION IS TO BE CARRIED ON IN ACCORDANCE WITH THESE
PLANS AND THE STANDARD SPECIFICATIONS FOR HIGHWAY AND BRIDGE
CONSTRUCTION DATED APRIL, 1964, AS APPROVED BY THE BUREAU OF
PUBLIC ROADS ON OCT. 12, 1964, INCLUDING ALL SUBSEQUENT
APPROVED REVISIONS AND SUCH REVISED SPECIFICATIONS AND
SPECIAL PROVISIONS AS ARE INCORPORATED IN THESE PLANS.

FEB 25 1980

DATE: 11/20/63	DATE: 11/14/63	DATE: 11/14/63	PROJECT: F 019-2(4)
SHEET: 1	SHEET: 2	SHEET: 3	SHEET: 4