


4.10.3
Tremblay
DATE: 11/15/79
BY: J. KELLEY
SCALE: 1" = 40'

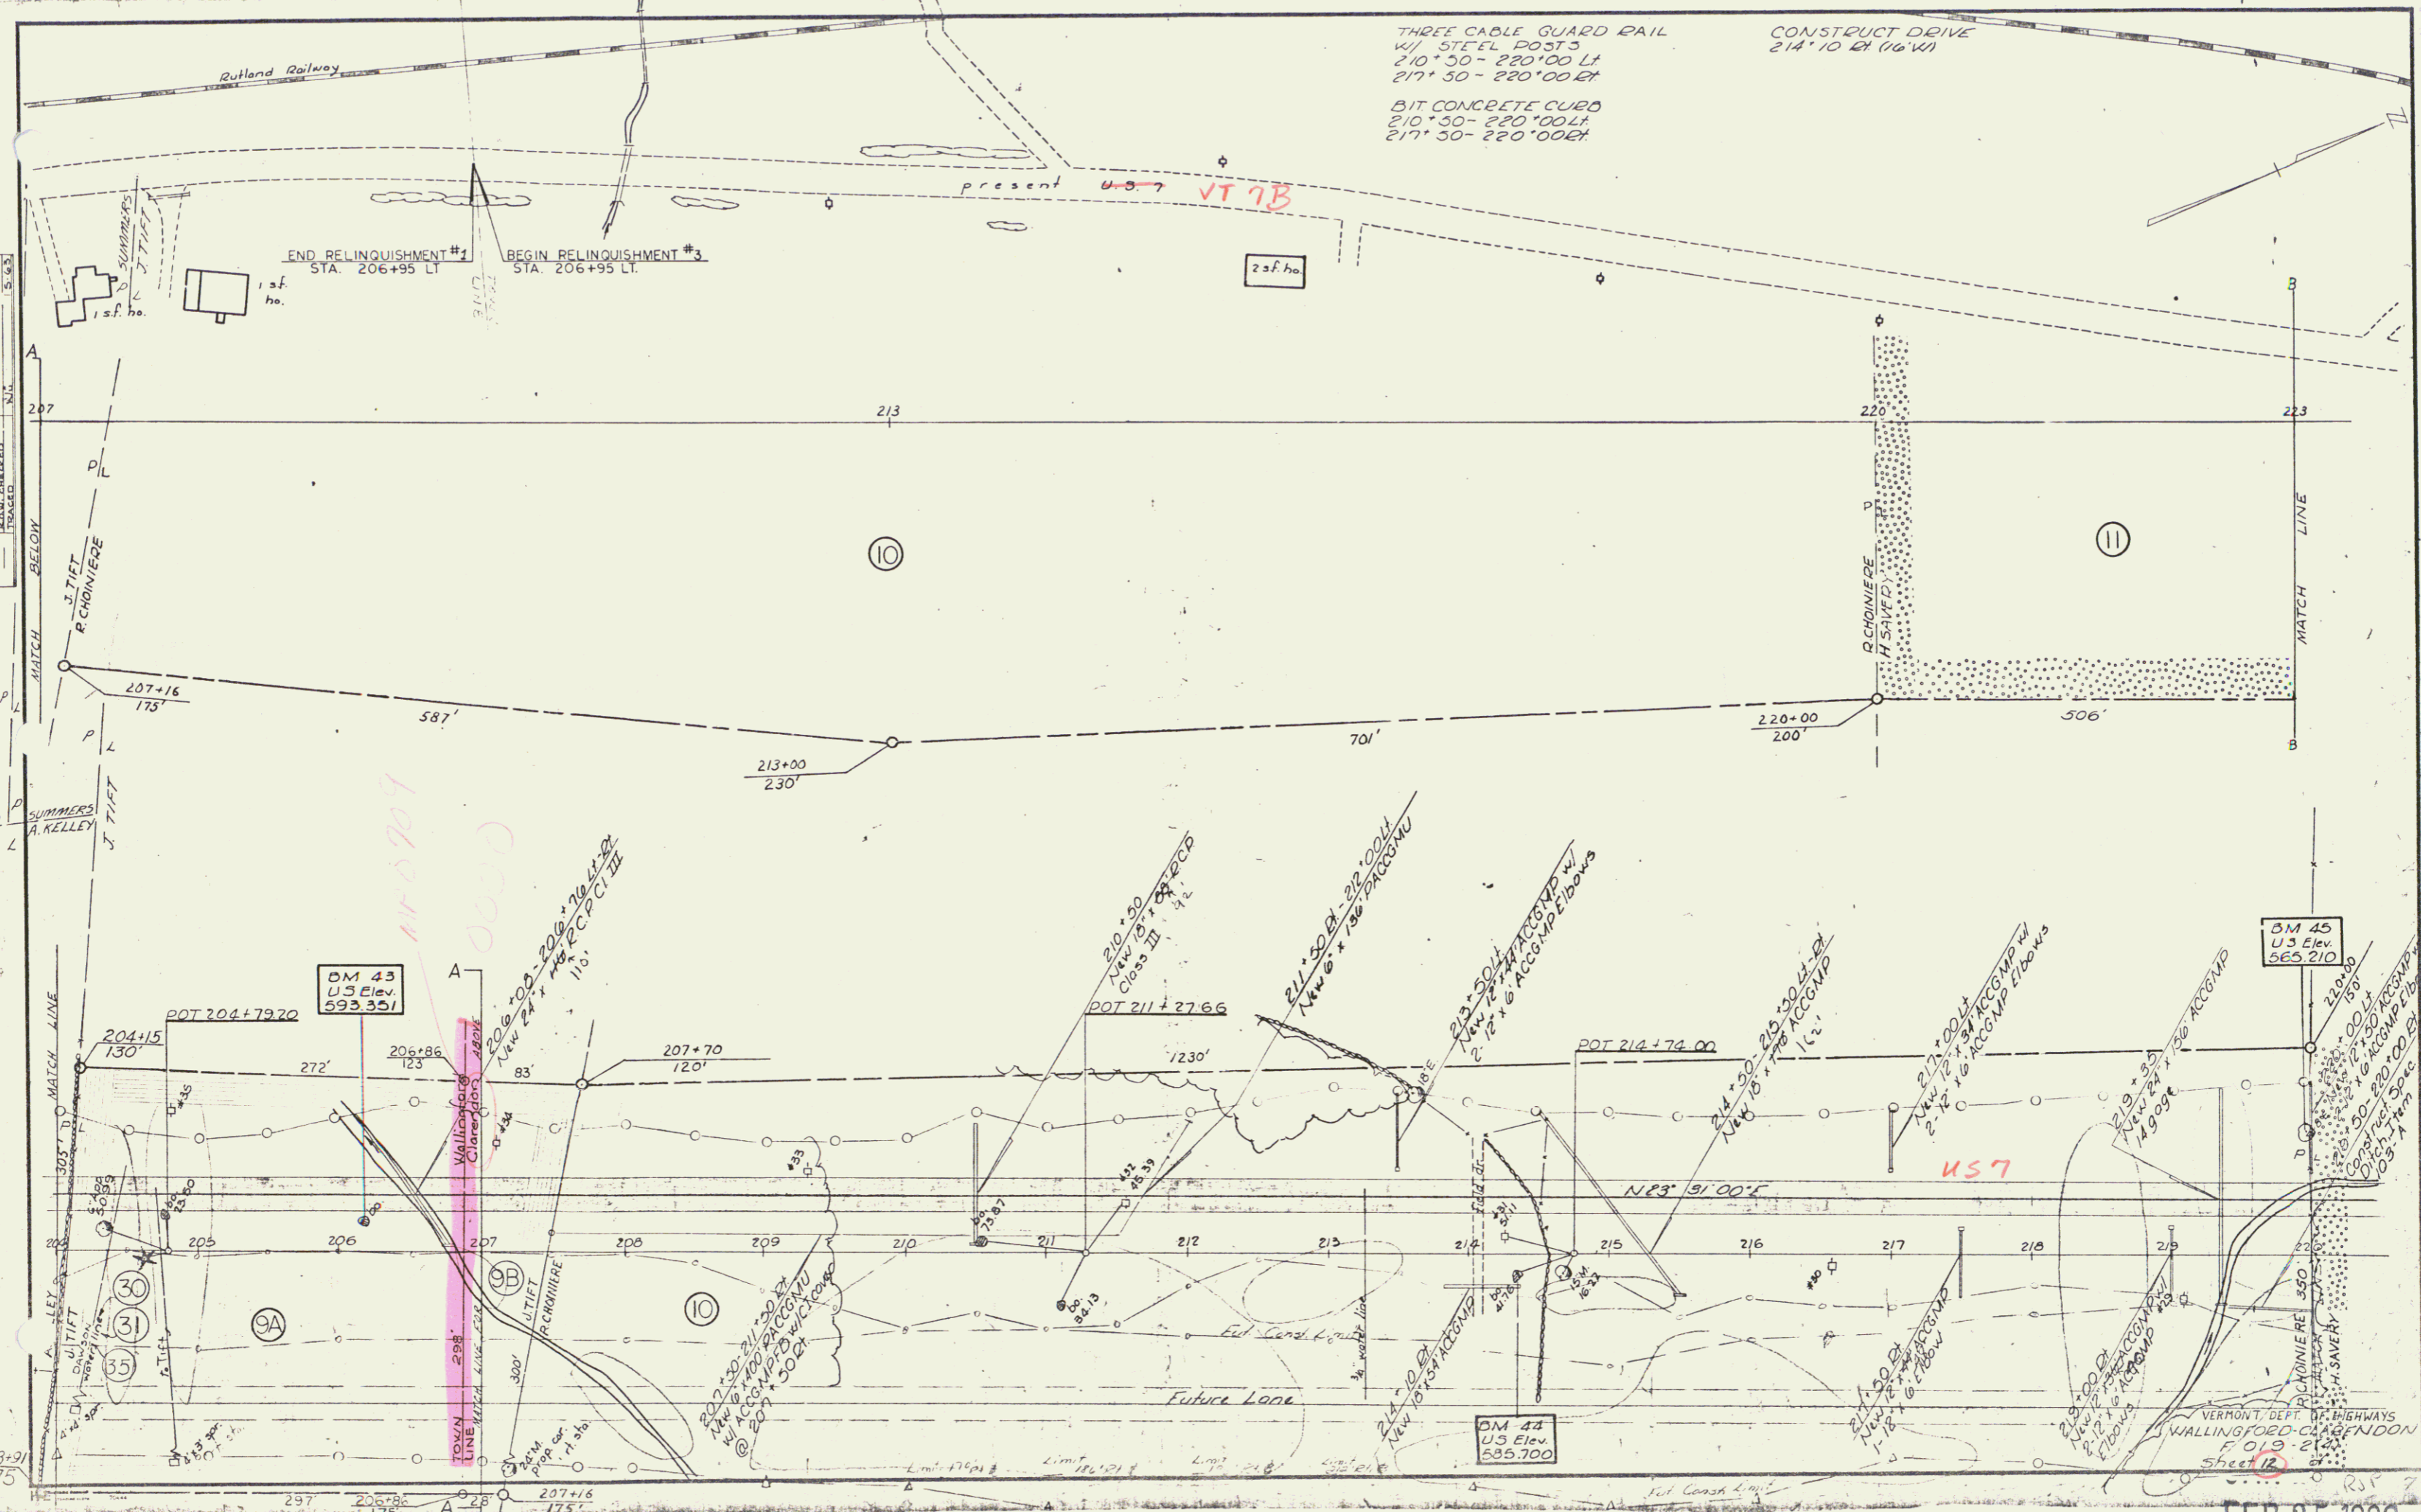

FEB 25 1980
6