


DATE: 1/11/80
BY: [illegible]
CHECKED: [illegible]
SCALE: 1" = 40'

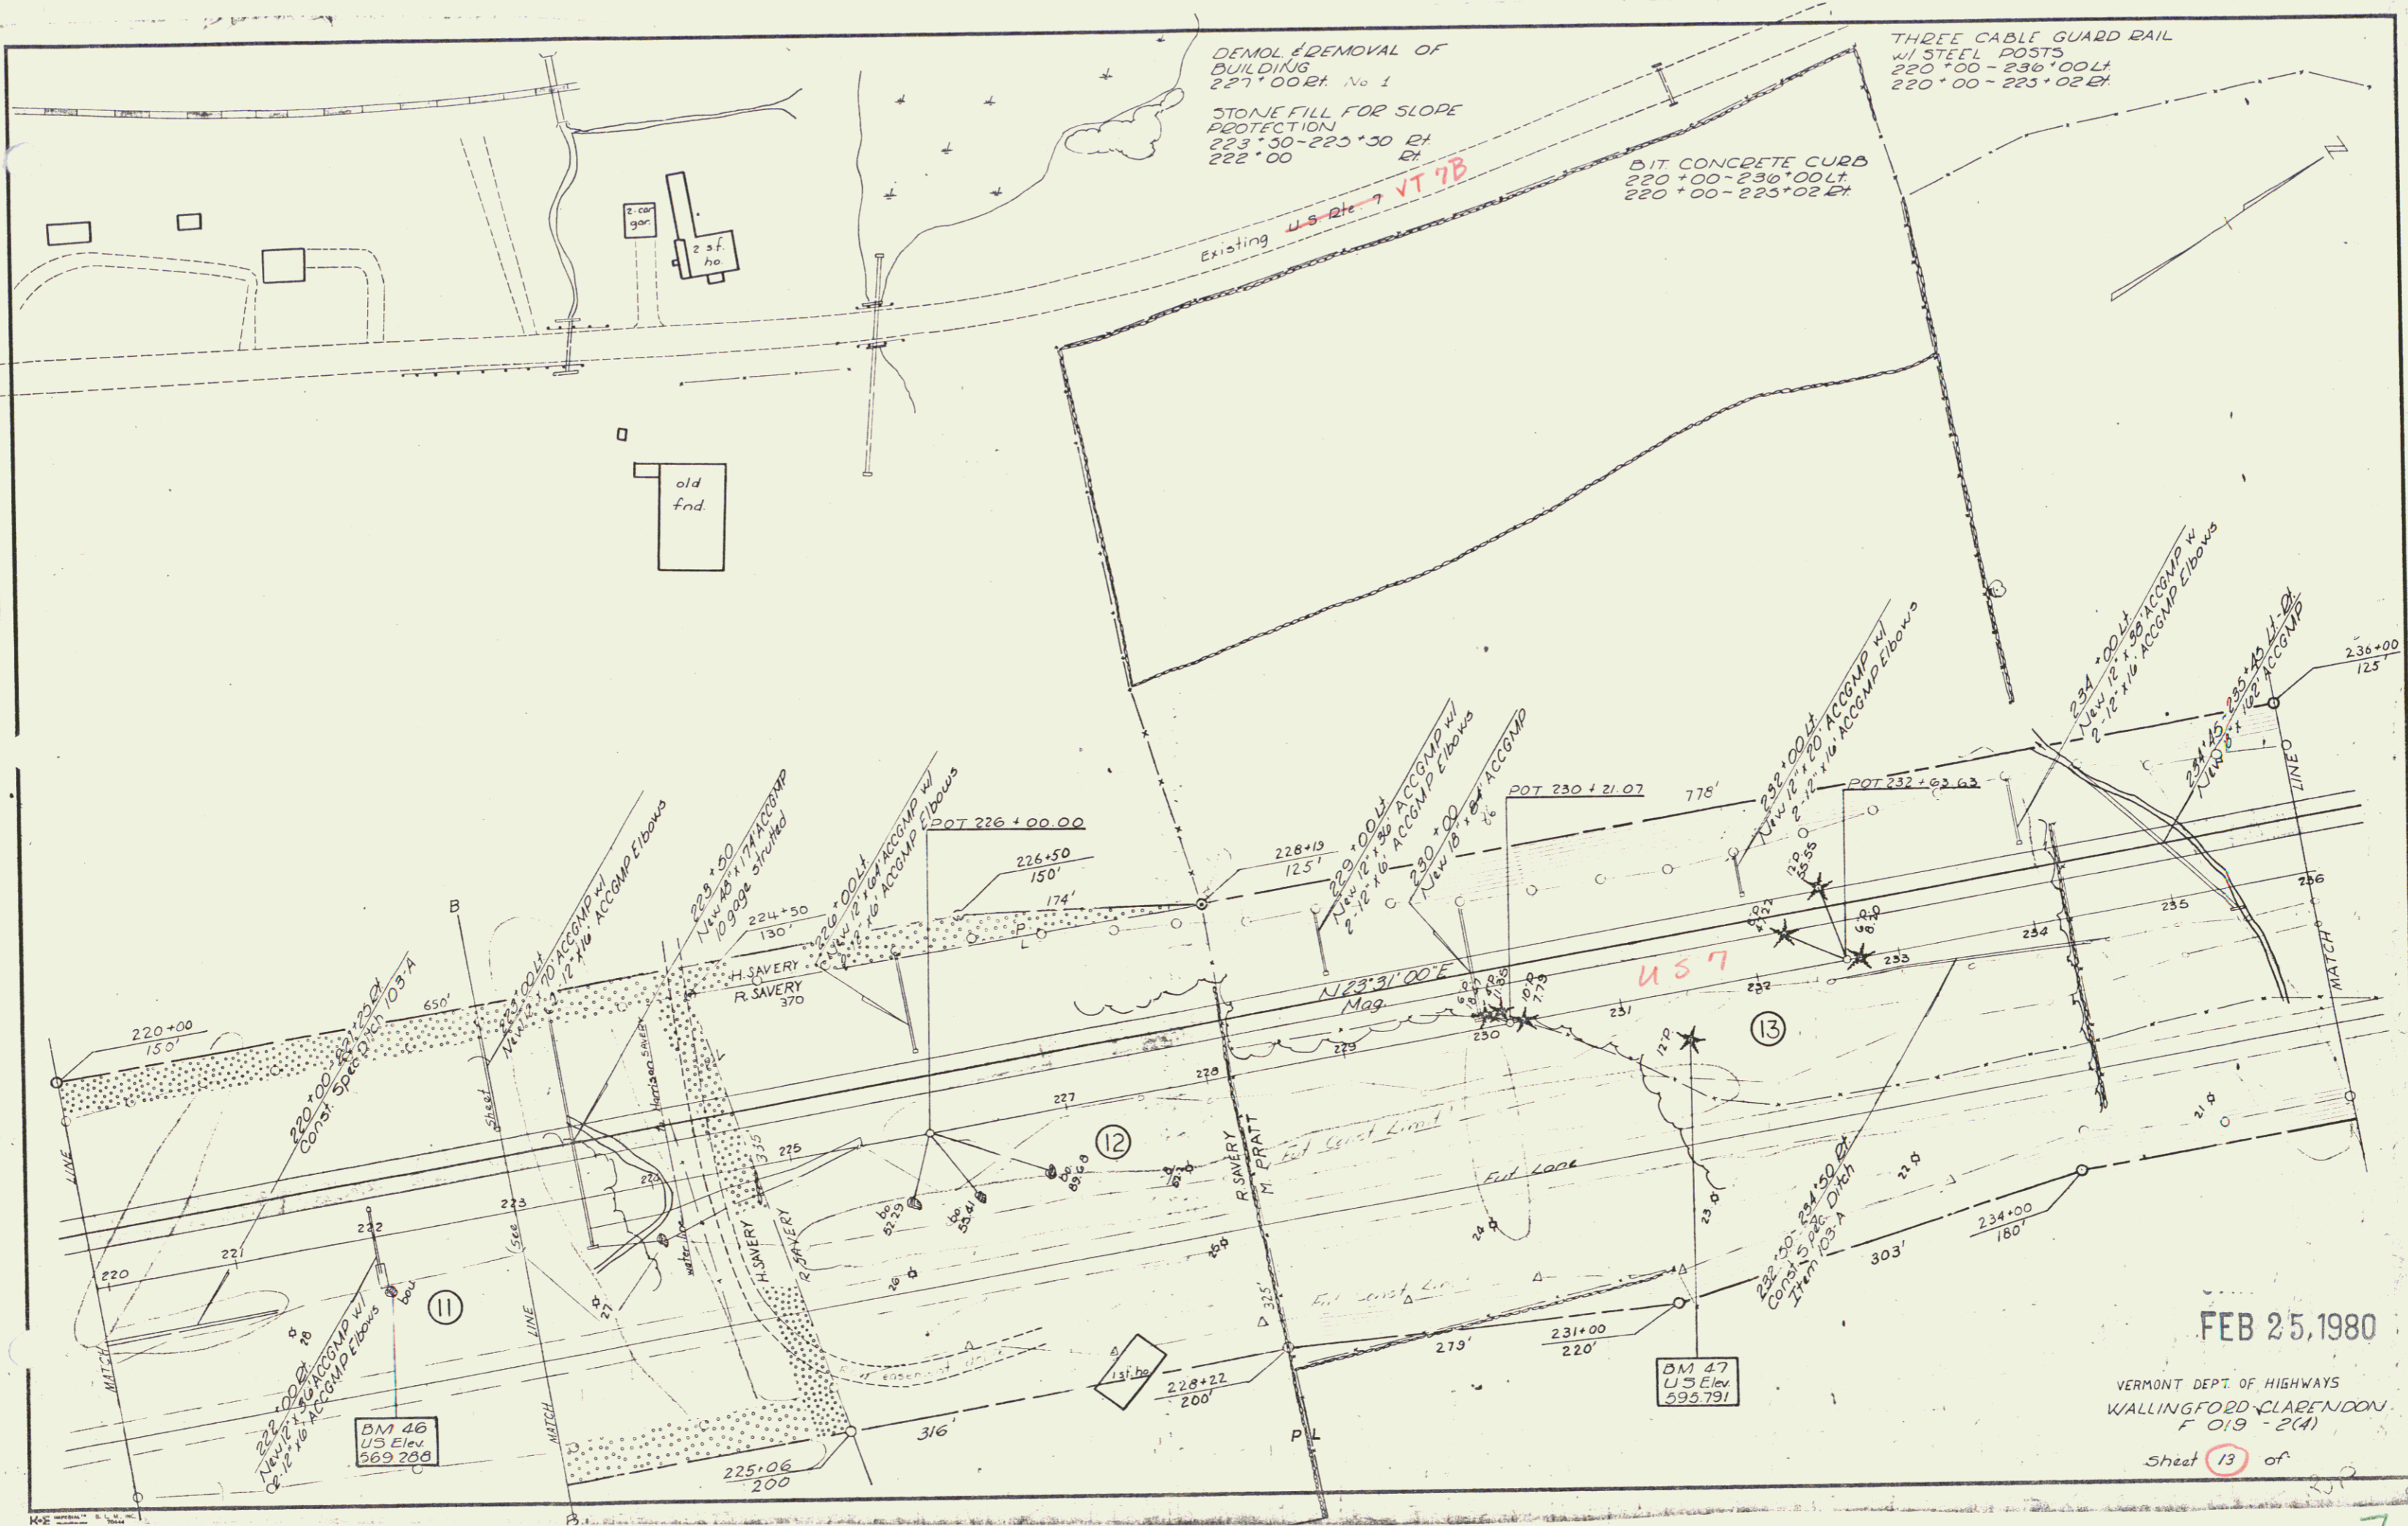

FEB 25, 1980

VERMONT DEPT. OF HIGHWAYS
WALLINGFORD CLARENDOON
F 019 - 2(4)

Sheet 13 of 24

7