
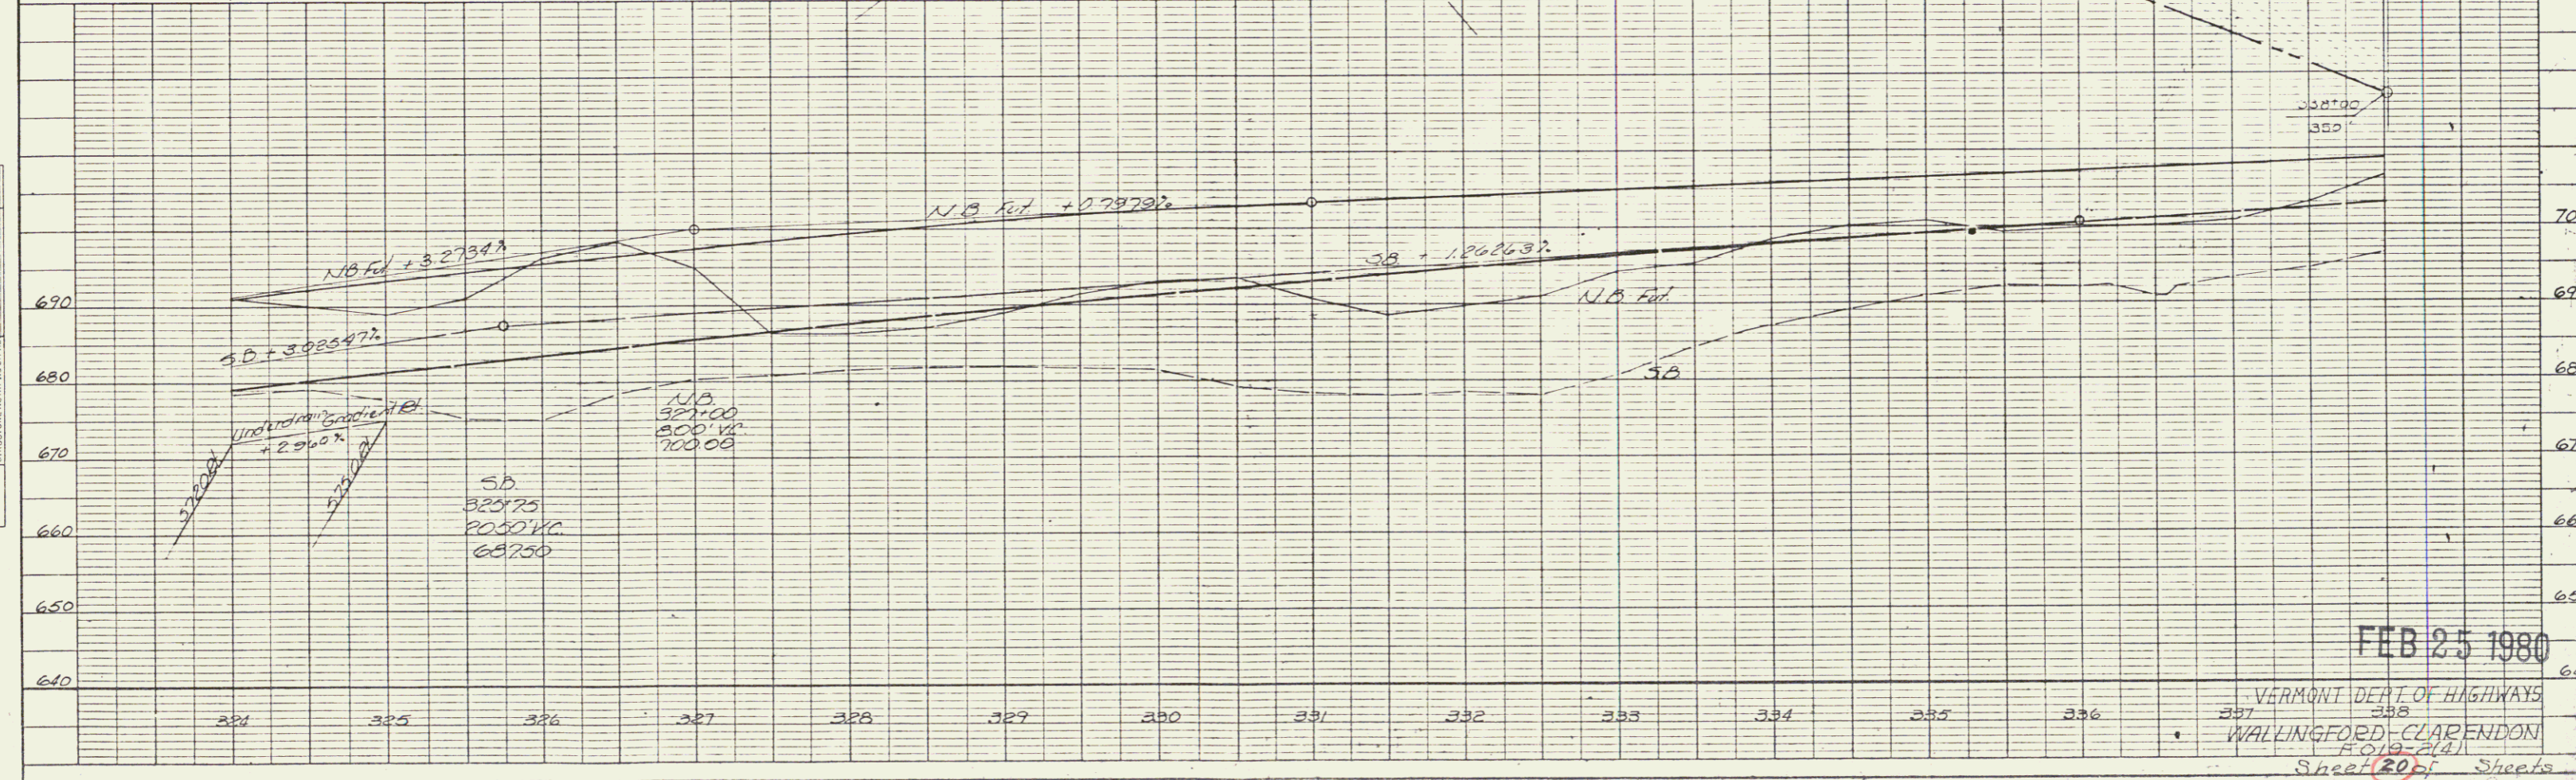


PLAN
 SURVEYED BY: []
 PLANNED BY: []
 CHECKED BY: []
 DATE: []

PROFILE
 SURVEYED BY: []
 PLANNED BY: []
 CHECKED BY: []
 DATE: []

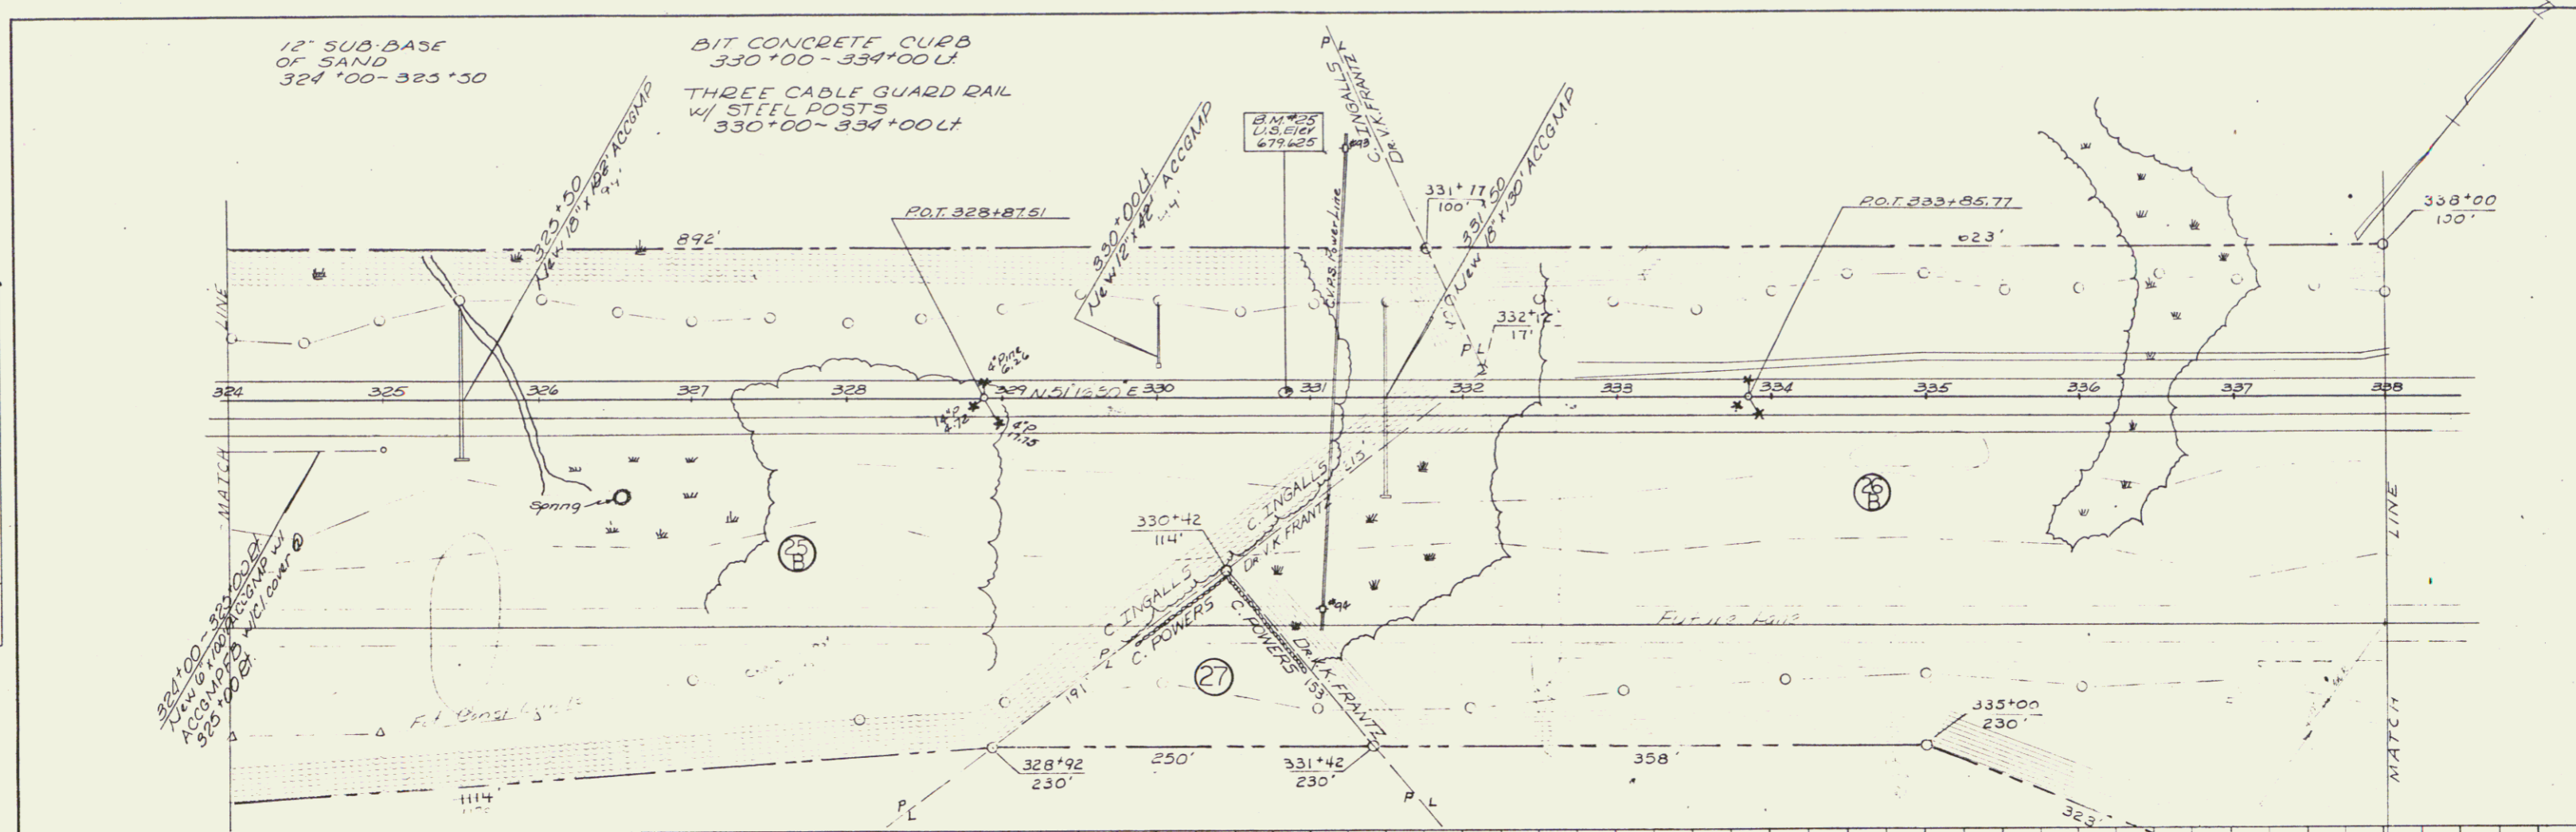

FEB 25 1980

VERMONT DEPT. OF HIGHWAYS
 WALLINGFORD-CLARENDON
 R.O. 10-214
 Sheet 20 of 21

PLATE 1 - PLAN, PROFILE, C. P. A. & S. STANDARD
 REISSUE - A. K. & S. CO., NEW YORK

15