


SURVEYED  
 PLANNED  
 CHECKED  
 DRAWN  
 DATE  
 5/83

GRANITE SLOPE EDGING  
 352+00 - 352+95 Med.

MUCK EXCAVATION  
 352+75 - 355+00

FULL LOOP $\Delta 25^{\circ} 54' 16''$ LT. $D 1^{\circ} 30' 50''$ $B 3784.64$ $T 370.43$ $L 1711.10$	D.L.E.S.B. $\Delta 43^{\circ} 07' 30''$ LT. $D 2^{\circ}$ $B 2864.79$ $T 1132.08$ $L 2156.25$ $E 215.56$	N.B. $\Delta 43^{\circ} 07' 30''$ LT. $D 2^{\circ} 30''$ $B 2291.83$ $T 905.06$ $L 1725.00$ $E 172.06$
---	--	--

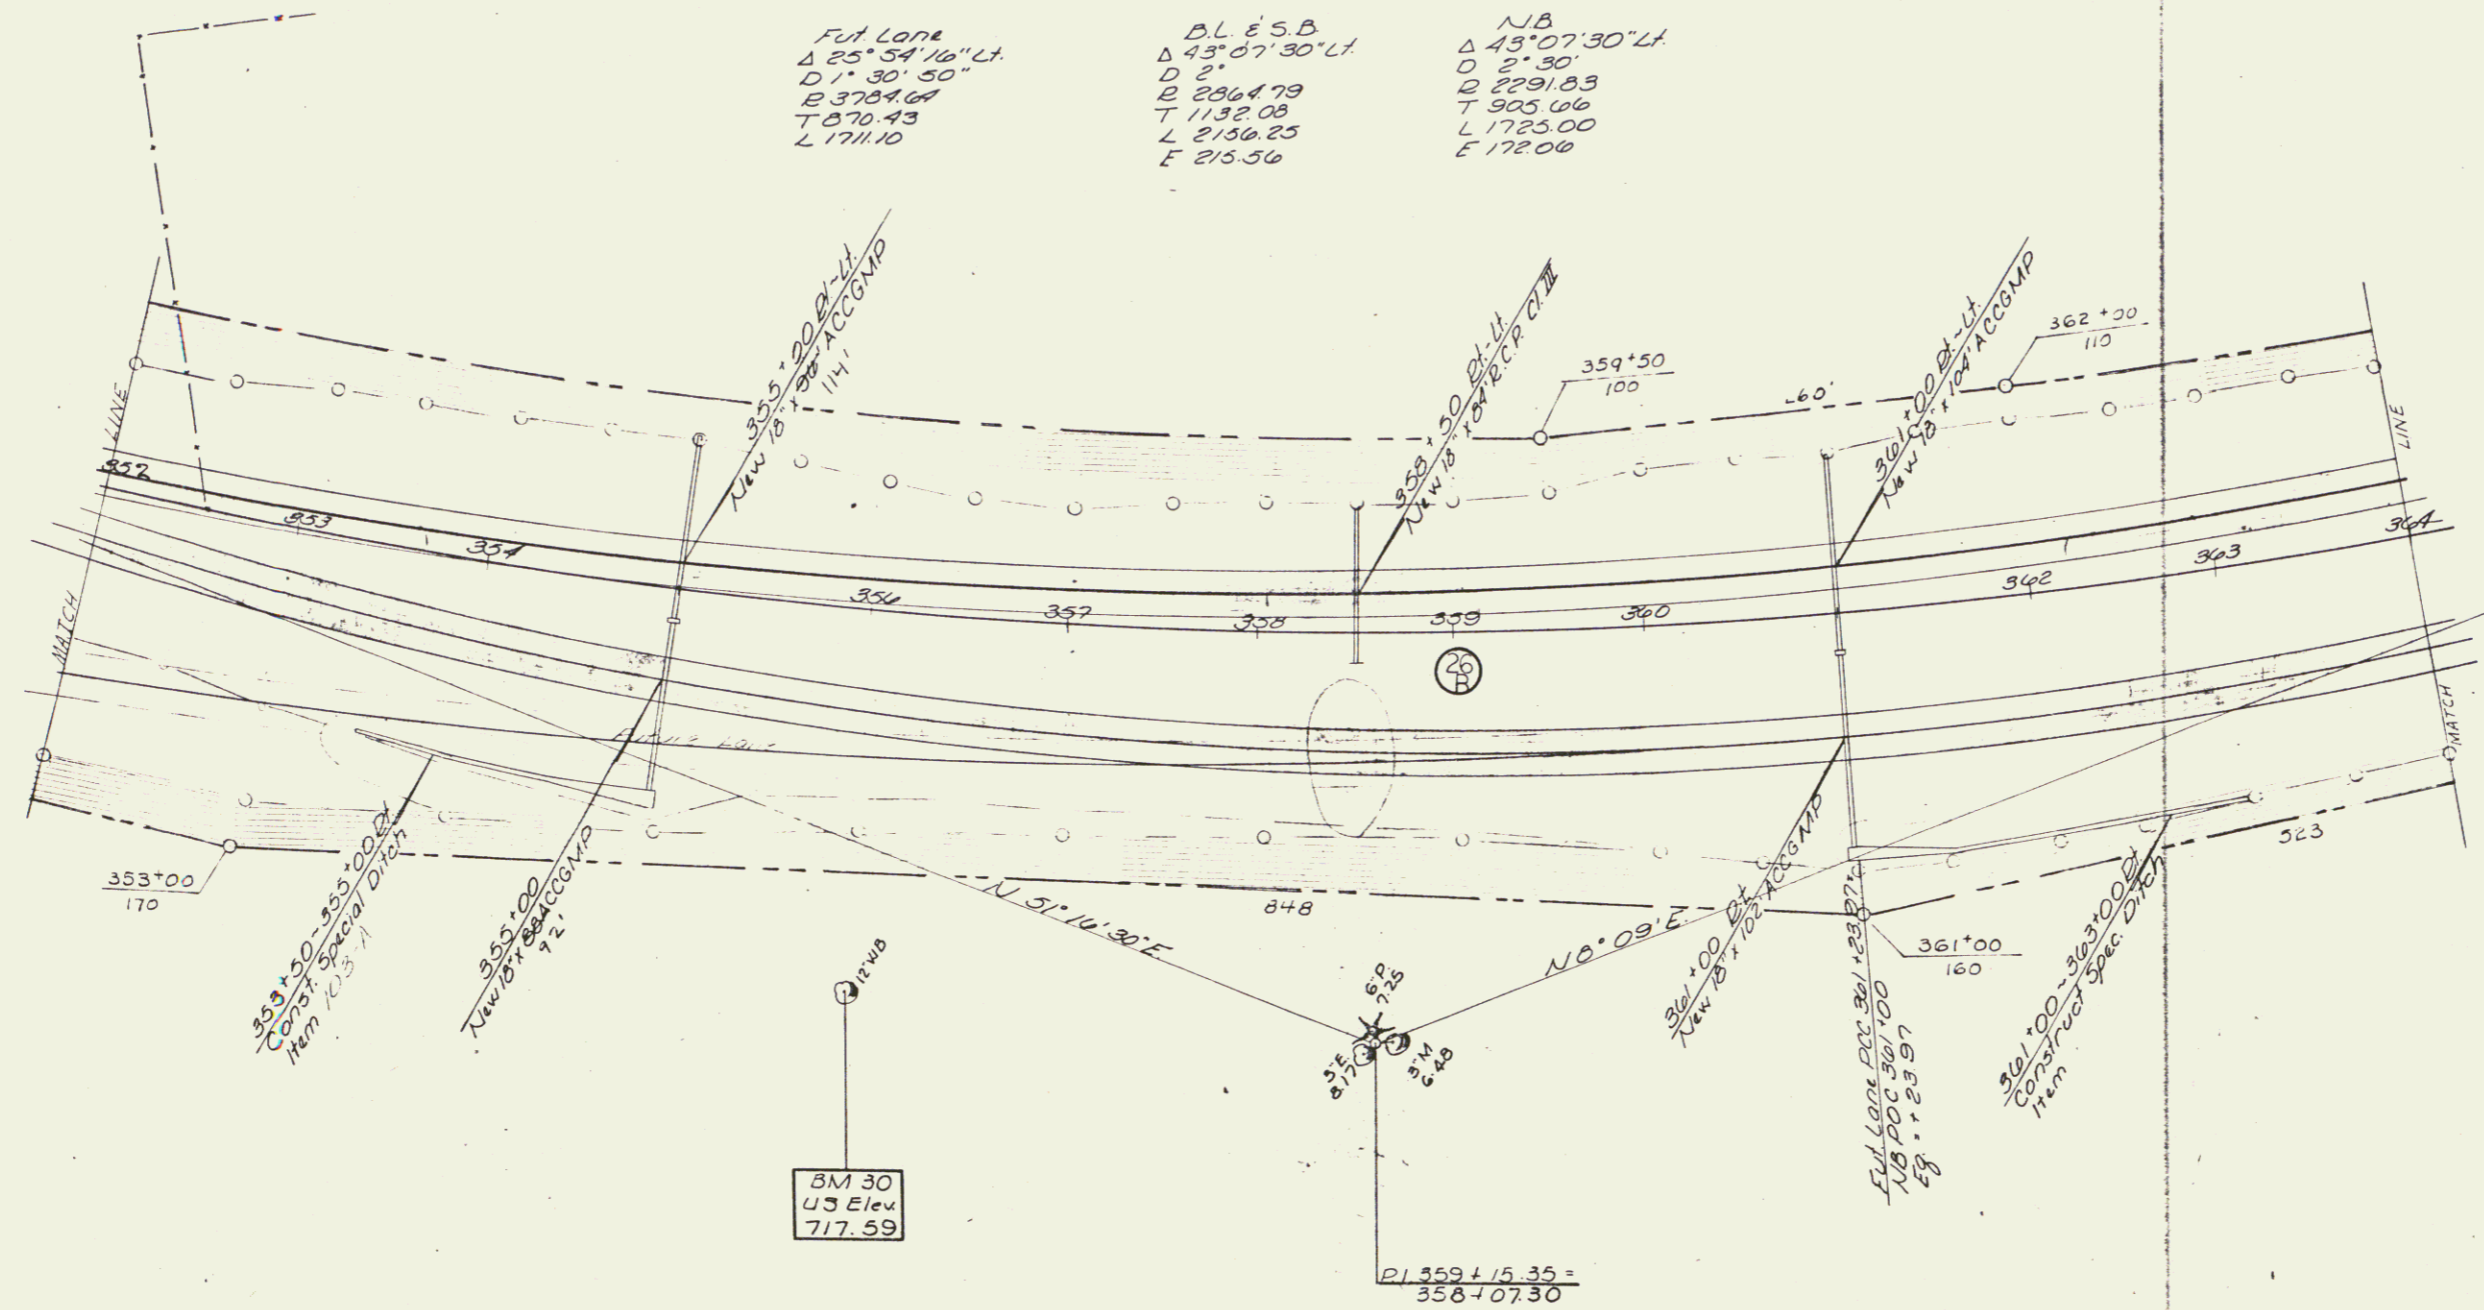

FEB 25 1980

VERMONT DEPT OF HIGHWAYS  
 WALLINGFORD-CLARENDON  
 F 019 - 2(4)

Sheet 22 of 27