


PLAN	REVISIONS	DATE
1	AS SHOWN	2/5/60
2	ADD DRIVE	2/5/60
3	ADD DRIVE	2/5/60
4	ADD DRIVE	2/5/60
5	ADD DRIVE	2/5/60
6	ADD DRIVE	2/5/60
7	ADD DRIVE	2/5/60
8	ADD DRIVE	2/5/60
9	ADD DRIVE	2/5/60
10	ADD DRIVE	2/5/60

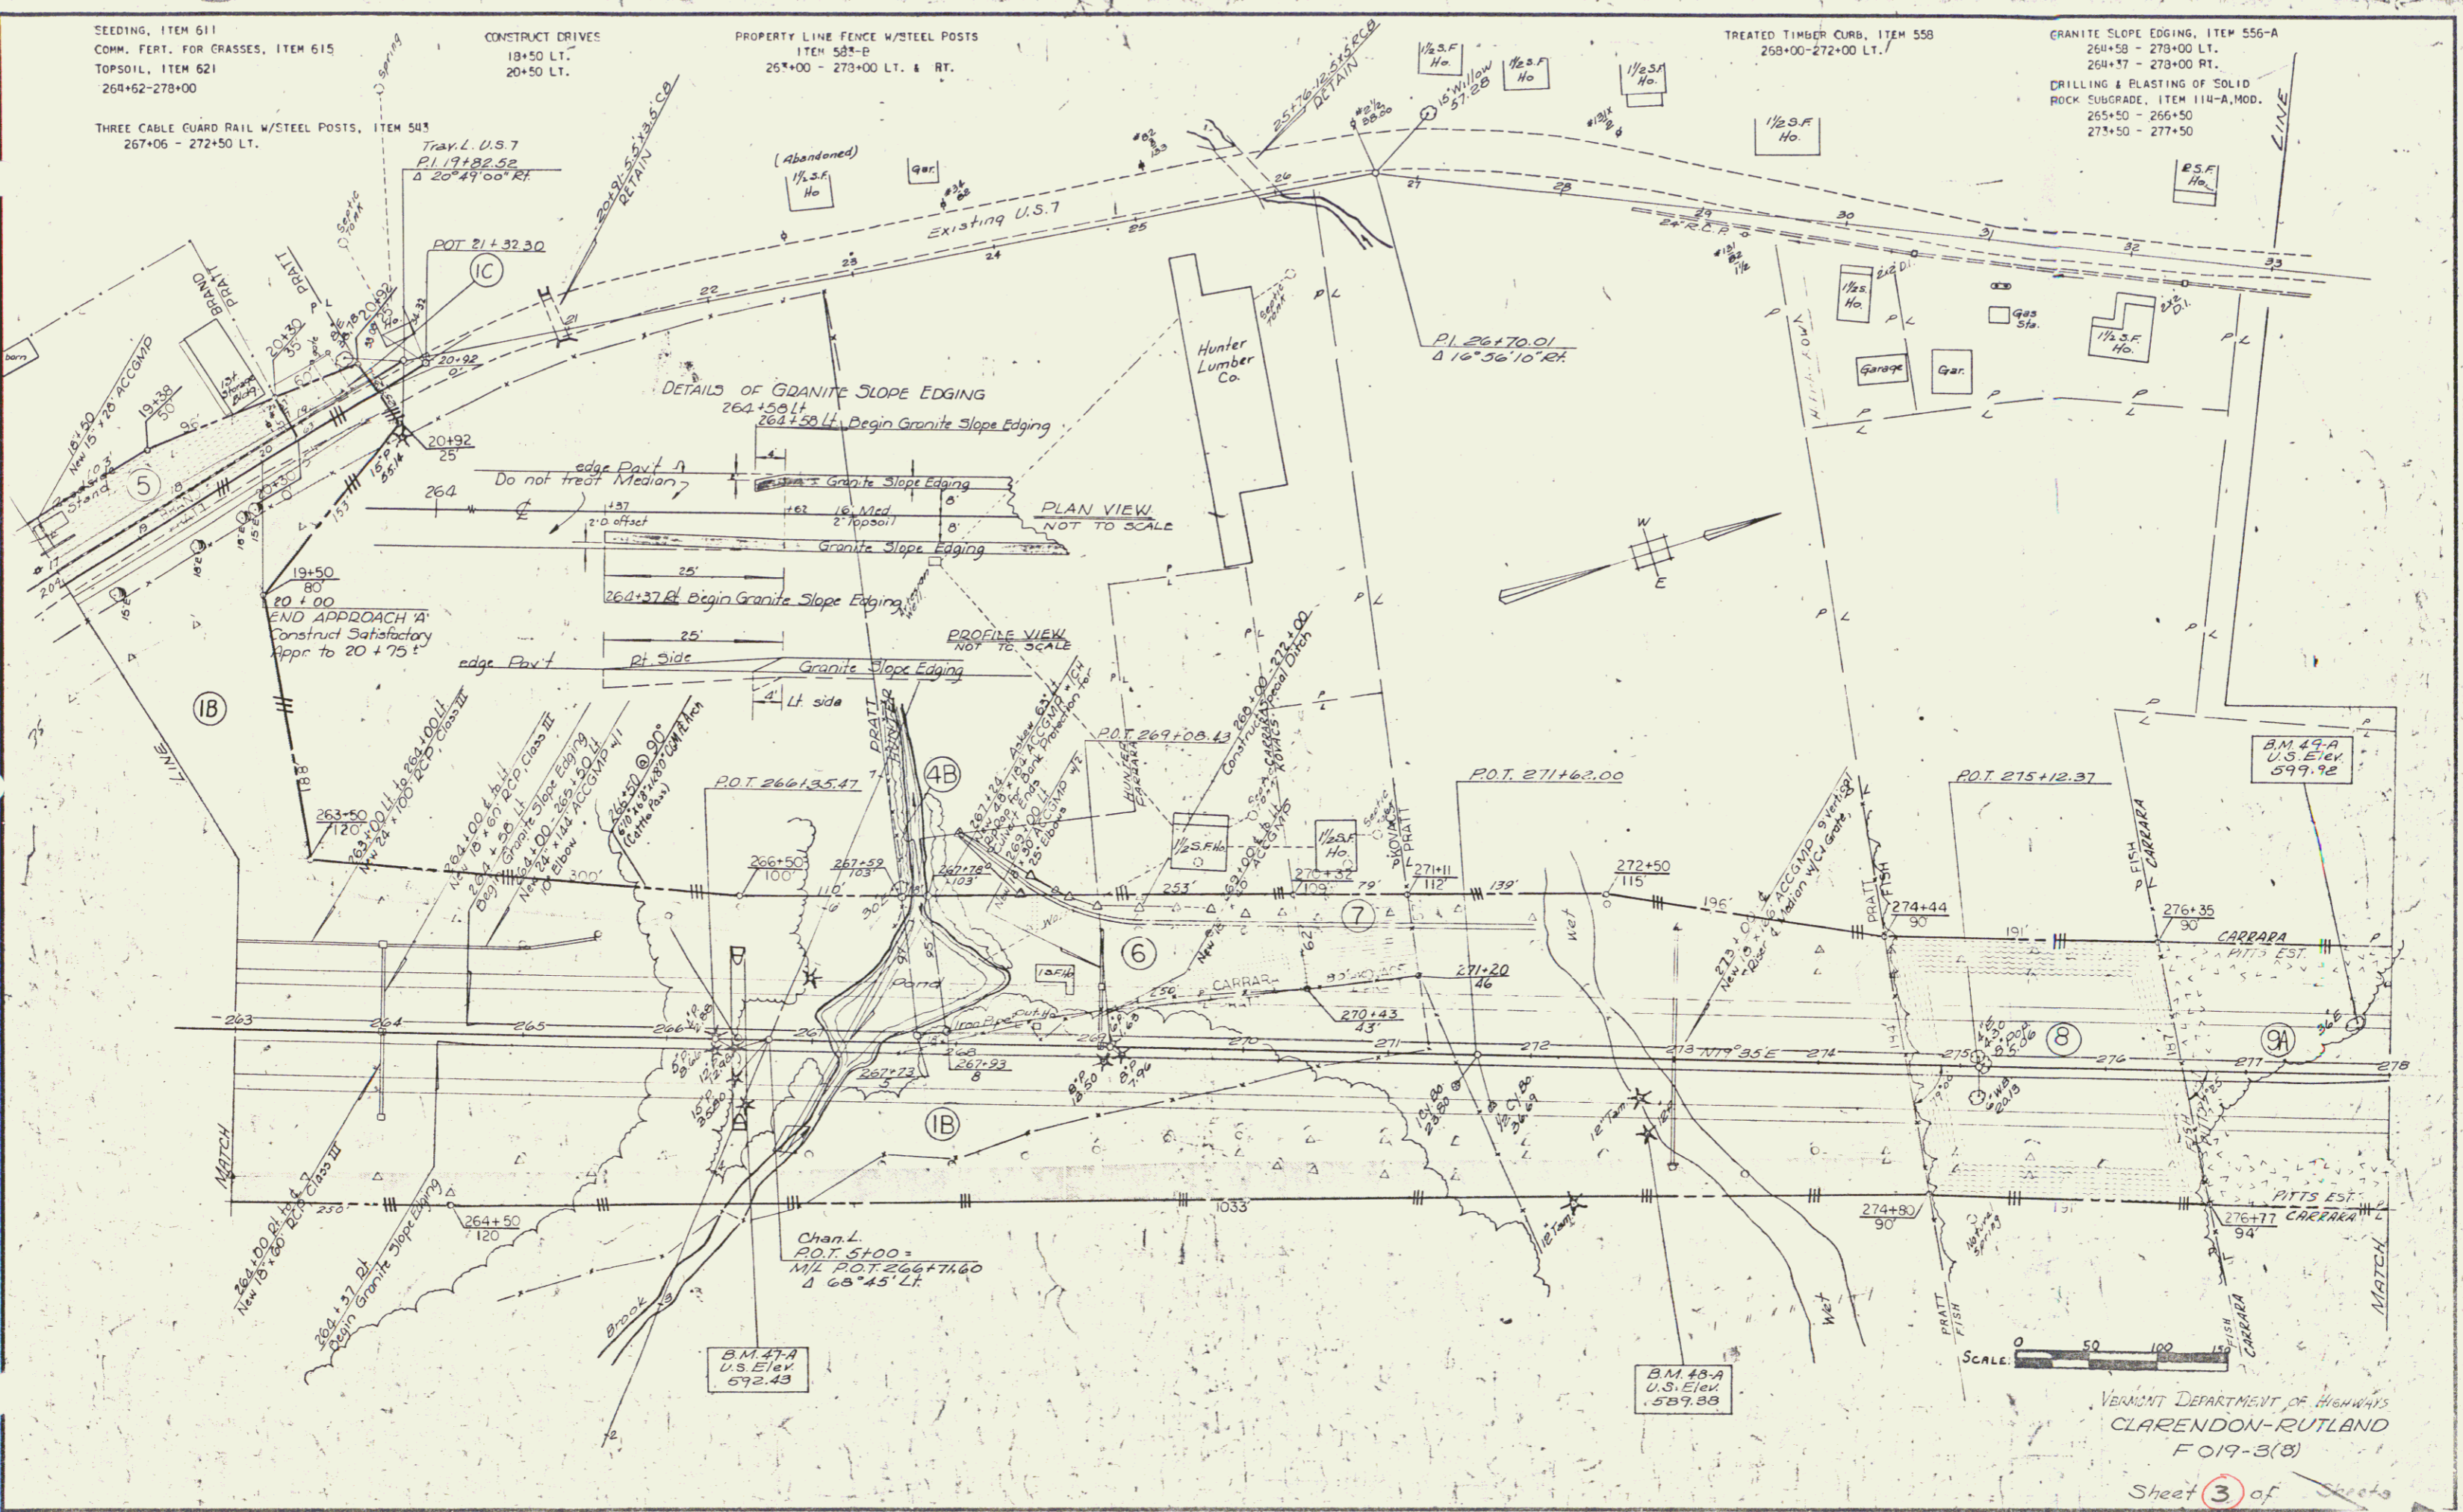

VERMONT DEPARTMENT OF HIGHWAYS
CLARENDON-RUTLAND
F 019-3(8)

Sheet 3 of 3

FEB 25 1960