

SEEDING, ITEM 611
 COMM. FERT. ITEM 615
 TOPSOIL, ITEM 621

148+00-143+63 RT.	151+91-155+59 LT.
149+01-150+11 RT.	156+00-156+73 LT.
150+66-151+00 RT.	157+08-157+30 LT.
150+70-151+57 RT.	157+56-160+19 LT.
148+00-148+13 LT.	160+11-162+21 LT.
148+85-149+00 LT.	162+56-163+42 LT.
150+10-151+16 LT.	161+77-161+00 LT.

CONSTRUCT DRIVES

LT.	RT.
148+00.5	148+00.5
150+03	150+03.5
151+02	156+42.5
155+06.5	157+25.5
156+00.5	158+40.5
157+07.5	157+07.5
160+13.5	160+13.5
162+33.5	162+33.5
164+53.5	164+53.5
161+09.5	161+09.5

GRANITE CURB, ITEM 556-P


LT.	RT.
148+00-148+30	148+00-148+63
148+85-149+37	149+03-150+31
150+23-151+15	150+66-151+00
151+11-151+61	151+44-155+25
151+01-155+60	156+60-161+57
156+00-157+70	156+75-164+00
157+00-157+70	
157+01-160+19	
160+11-162+21	
162+56-163+42.5	
161+77.5-164+00	

5" ONE COURSE CEMENT CONCRETE
 SIDEWALK, ITEM 560

LT.	RT.
151+97-155+64	161+65-164+00

8" ONE COURSE CEMENT CONCRETE
 SIDEWALK, ITEM 560

LT.	RT.
155+64-156+09	
156+68-157+13	
157+25-157+70	
160+44-160+89	
162+16-162+61	
161+37.5-163+82.5	

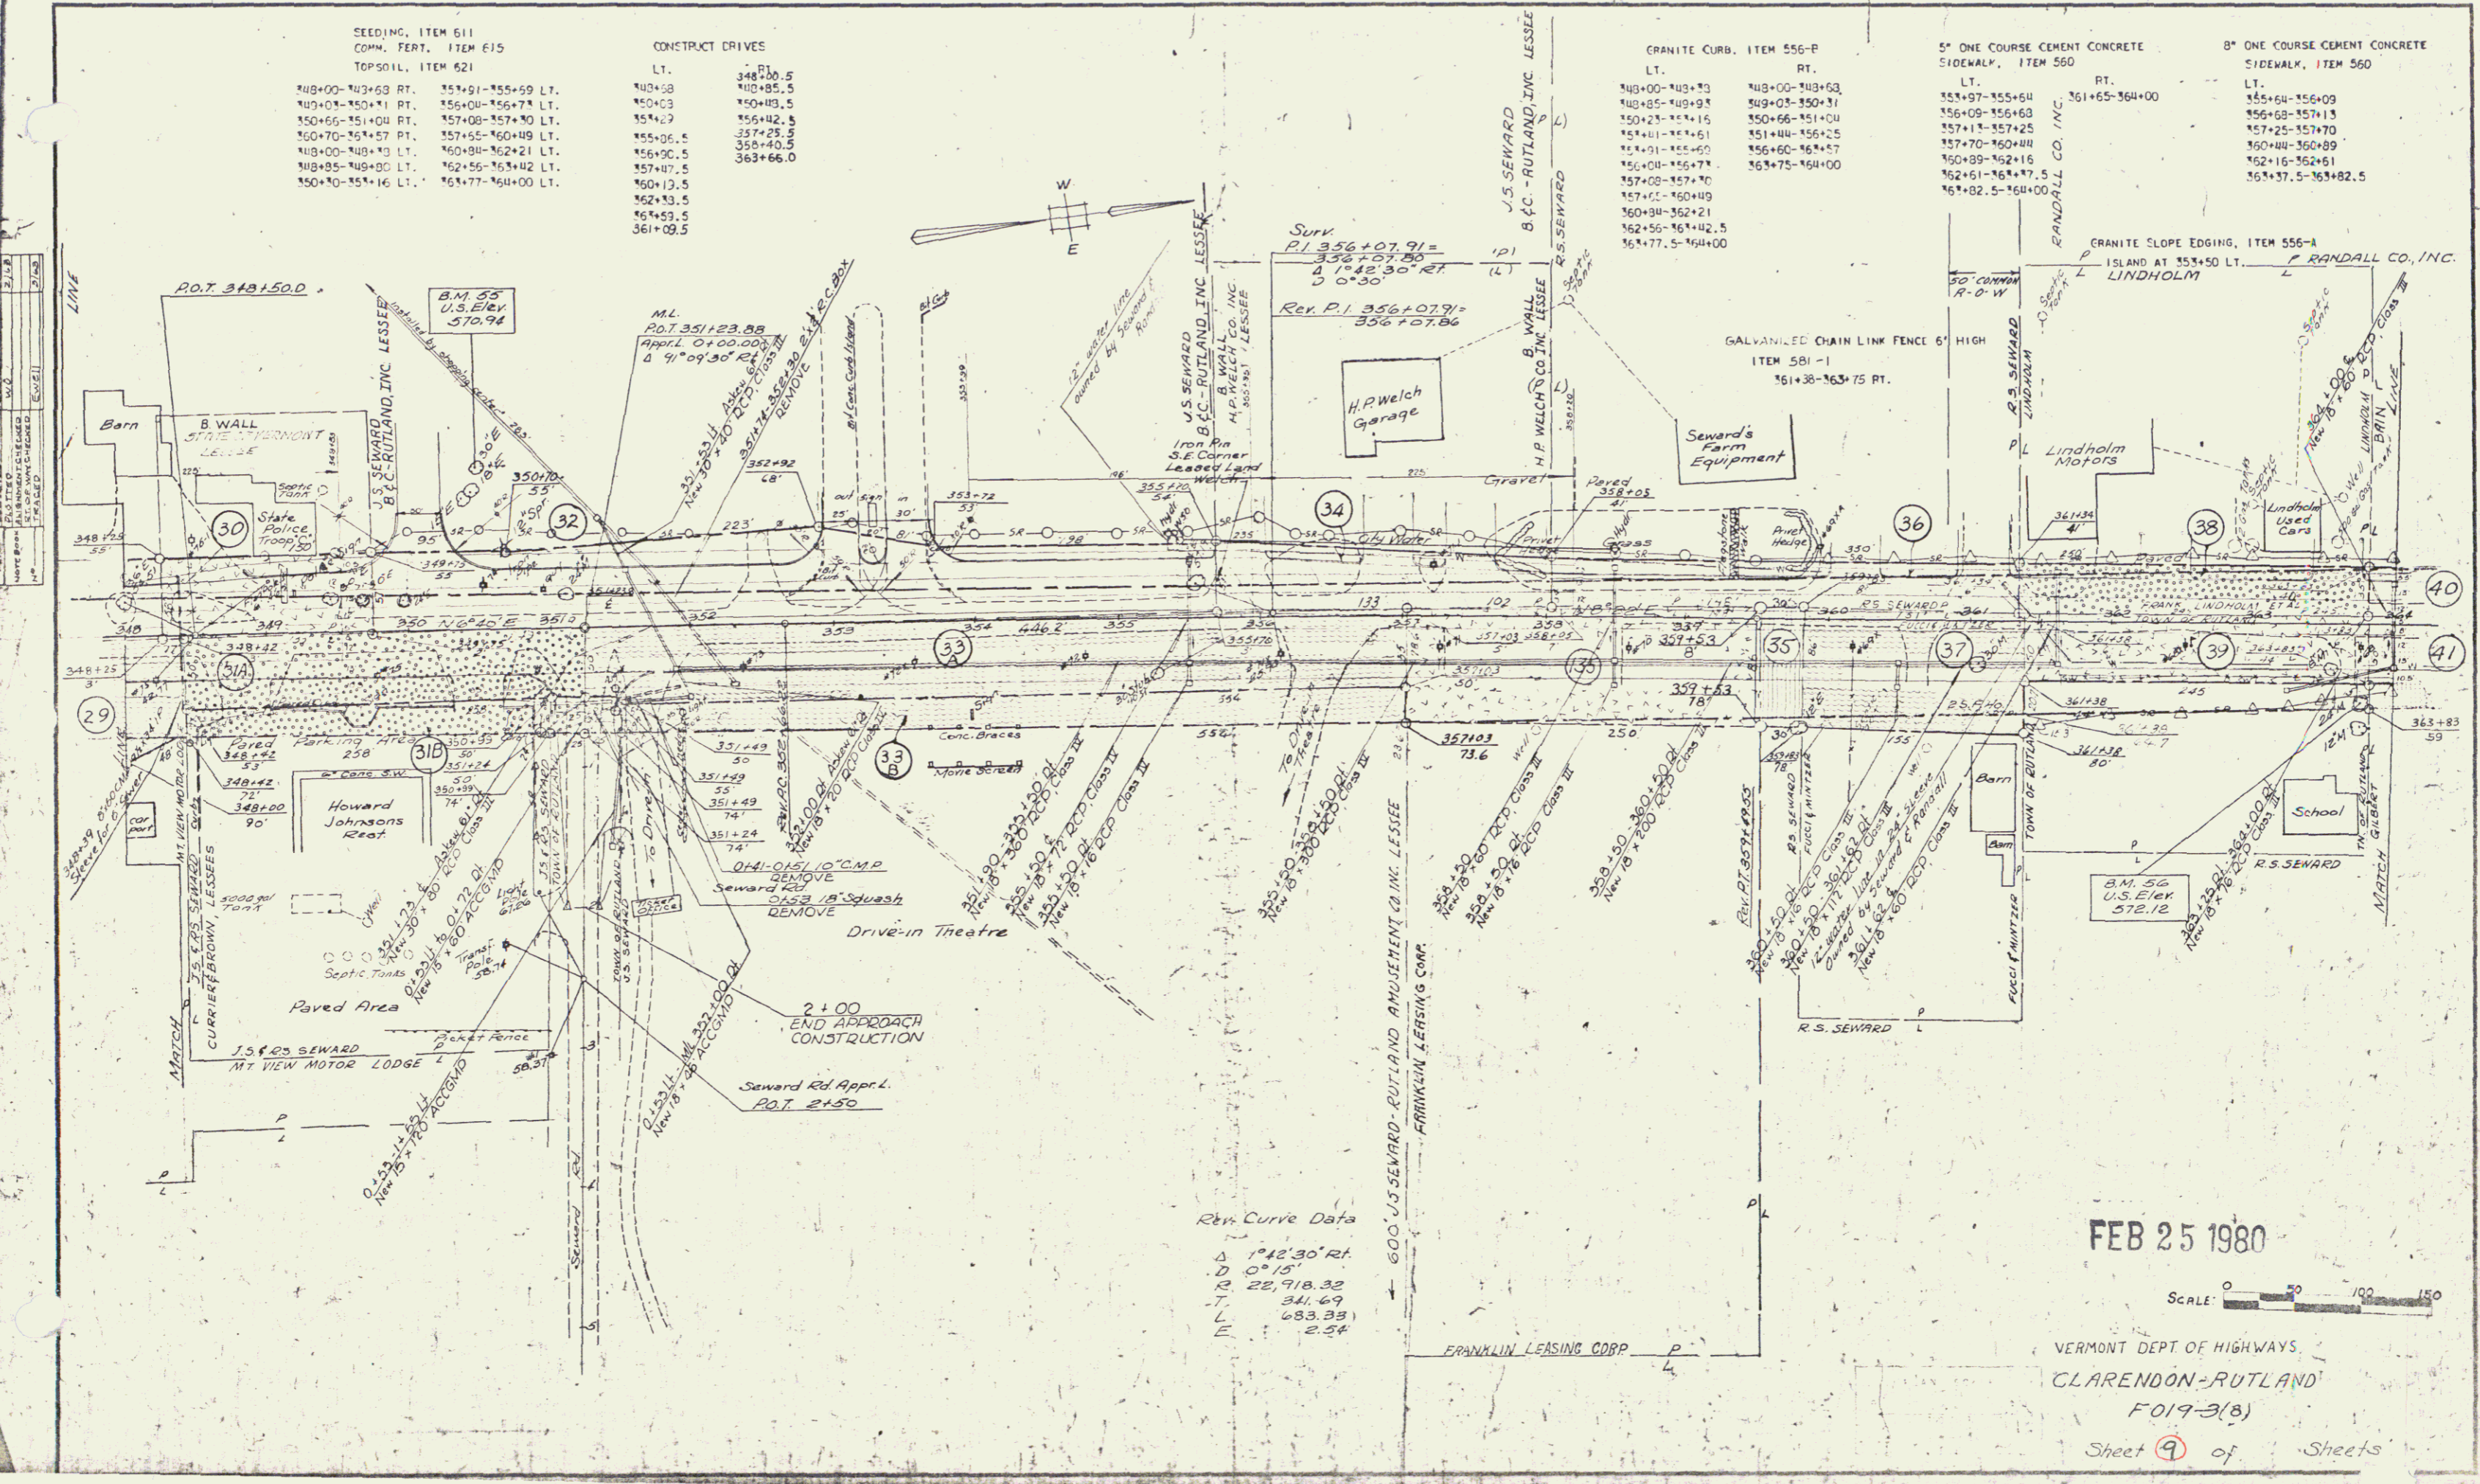

Rev. Curve Data
 Δ 1°42'30" Rt.
 D 0°15'
 R 22,718.32
 T 341.69
 L 683.33
 E 2.54

FEB 25 1980



VERMONT DEPT. OF HIGHWAYS
 CLARENDON-RUTLAND
 F019-3(B)
 Sheet 9 of Sheets