


END LIMITED Access
284+48 75' Lt.



BEGIN LIMITED Access
284+96 75' Lt.

36
NB 288+00RT - ALT. US 7 6+00 LT

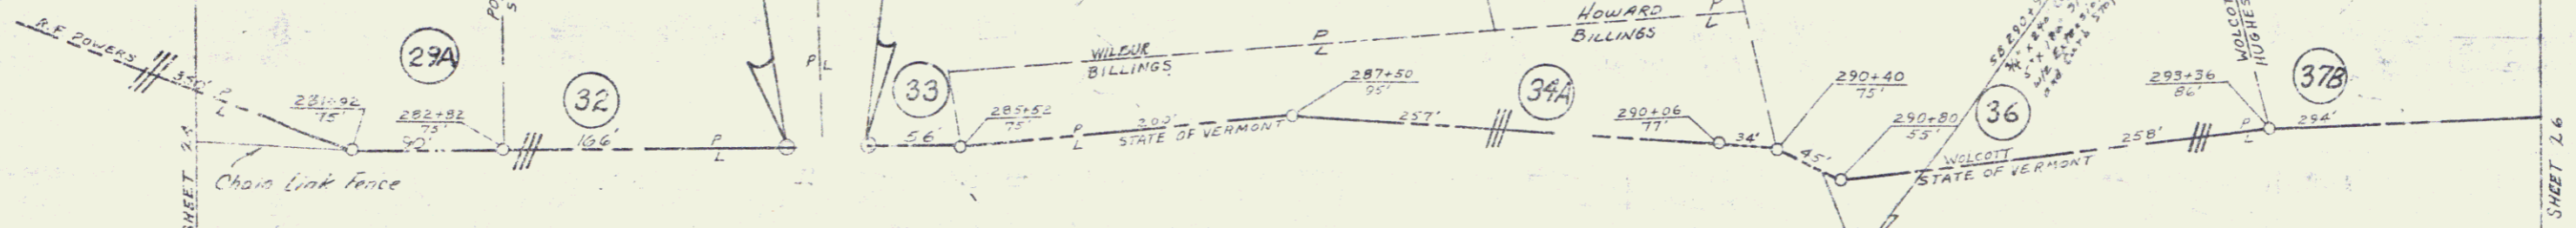

END LIMITED Access
285+15 75' Lt.

BEGIN LIMITED Access
285+72 75' Lt.

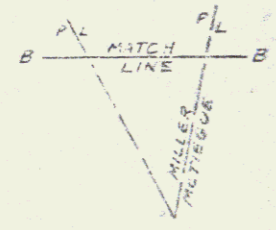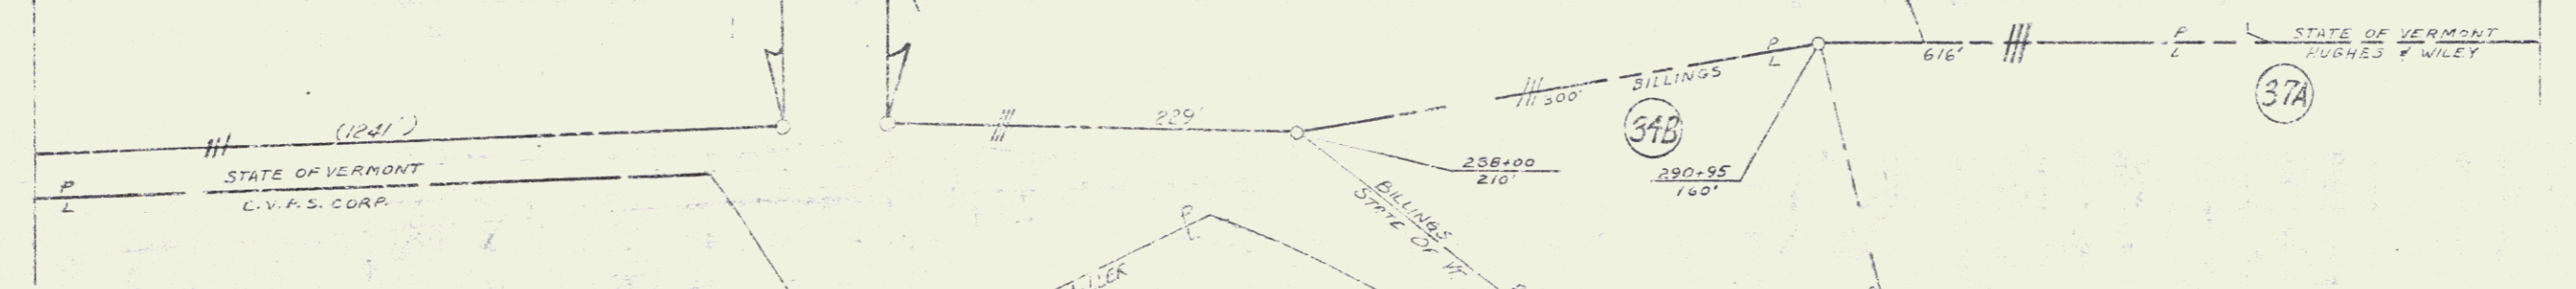

VERMONT DEPARTMENT OF HIGHWAY
 RIGHT-OF-WAY PLANS
 PROJECT WALLINGFORD-CLARENDON
 No. 17 019-2(50)
 SHEET 25 OF 72

