

INDEX OF SHEETS

- 1 TITLE SHEET
- 2-4 TYPICAL SHEETS
- 5 ALIGNMENT SHEET
- 6-7 QUANTITY SHEET
- 8-11 DRAINAGE SHEETS
- 12-22 EARTHWORK SHEETS
- 23-26 R.O.W. DETAIL SHEETS
- 27-60 PLAN AND PROFILE SHEETS
- 61-62 20 SCALE OF REST AREAS
- 63-64 TRAFFIC SIGN SUMMARY SHEETS
- 65 GUIDE SIGN AND DELINEATOR LOCATION SHEET
- 66-67 SIGN AND DELINEATOR PLACEMENT SHEETS
- 68 TRAFFIC SIGN, DESIGN AND DETAIL SHEET
- 69 A-61 DRILLING AND BLASTING
- 70 B-1 BANKING TABLES
- 71 B-5 TYPICAL SLOPE GRADING
- 72 B-6 MUCK EXCAVATION
- 73 B-10 EMBANKMENT ON A SLOPE
- 74 B-11 METHODS OF SLOPE STABILIZATION
- 75 B-15 ENTRANCE AND EXIT TERMINALS
- 76 B-16 TRIANGULAR ISLAND DESIGN
- 77 B-17 DETAILS OF REST AREAS
- 78 C-1 CURBS
- 79 C-1A CURBS
- 80 D-2 HEADWALLS AND UNDERDRAIN
- 81 D-3 GUTTERS AND JUTE MATTING
- 82 D-4 FLUSHING BASINS AND ELBOWS
- 83 D-8 DROP INLETS
- 84 D-10 DROP INLET TOPS
- 85 D-11 DROP INLET GRATES
- 86 D-13 CATCH BASINS
- 87 D-16 DROP INLET GRATES
- 88 D-17 VERTICAL RISERS
- 89 E-1 BARRICADES, SIGNS AND LIGHTS
- 90 E-12 U.S. ROUTE MARKERS
- 91 E-13 STATE ROUTE MARKERS AND AUXILIARY MARKERS
- 92 E-14 REGULATORY SIGNS
- 93 E-15 REGULATORY SIGNS
- 94 E-16 WARNING SIGNS
- 95 E-17 GUIDE SIGNS
- 96 E-18 GUIDE SIGNS
- 97 E-19 STANDARD SIGN PLACEMENT
- 98 E-20 DELINEATORS, HAZARD MARKERS
- 99 E-21 GROUND MOUNTED SIGN SUPPORTS
- 100 F-1 PROPERTY LINE FENCE WITH STEEL POSTS

- 101 F-2 GALVANIZED CHAIN LINK FENCE
- 102 F-3 ALUMINUM ALLOY CHAIN LINK FENCE
- 103 G-1 STEEL BEAM GUARD RAIL
- 104 G-3 THREE CABLE GUARD RAIL
- 105 G-3A DEAD END ANCHORAGE AT BRIDGE APPROACH
- 106 G-4 STEEL MARKER POSTS AND PLANK GUARD RAIL
- 107 G-5 CEDAR LOG GUARD RAIL
- 108 J-1 PROJECT AND BOUNDARY MARKERS
- 109 BLANK
- 110 DETAILS OF 2 LANE TO 4 LANE TRANSITION
- 111 DETAILS OF 2 LANE TO 4 LANE TRANSITION
- 112-115 DETAILS OF 108" ROUND PLATE PIPE AT STA. 185+75
- 116-118 DETAILS OF REINFORCED CONCRETE CATTLE PASS AT STA. 218+50
- 119-121 DETAILS OF REINFORCED CONCRETE CATTLE PASS AT STA. 332+00
- 122-144 BRIDGE SERIES 100
- 145 SCB-30-65
- 146-154 SCB-D1 THRU D9-65
- 155-156 SB-R1-64 SHEETS 1 & 2
- 157 SB-R2-65
- 158-305 MAINLINE CROSS SECTION SHEETS
- 306-320 SIDELINE CROSS SECTION SHEETS
- 321-328 CHANNEL CROSS SECTION SHEETS

STATE OF VERMONT
DEPARTMENT OF HIGHWAYS

PROPOSED IMPROVEMENT

TOWNS OF WALLINGFORD AND CLARENDON
COUNTY OF RUTLAND

U.S. ROUTE 7 L.A. Pin# 992 498

PROJECT NAME & NUMBER-TYPE
WALLINGFORD-CLARENDON BITCONC. AP 019-2(2) PVMT

RECORD PLANS - MATERIALS

CLARENDON TOWN LINE AND EXTENDING NORTHERLY 3.650 MILES
LENGTH OF ROADWAY 18,948.065 FEET = 3.589 MILES
LENGTH OF BRIDGE 32350 FEET = 0.06 MILE
LENGTH OF PROJECT 19,271.565 FEET = 3.650 MILES

SUBBASE OF SAND-YOUNG PIT CLARENDON VT.
SUBBASE OF CRUSHED GRAVEL, CRUSHED STONE PLANT MIXED
BASE COURSE, TAR EMULSION FOR BRIDGE FLOORS, BIT.
CONC. CURB & BIT. CONC. F.W. WHITCOMB CONSTR. CORP.,
& VT. PAVING, WALLINGFORD, VT.
TACK COAT, TYPE III - ALL STATES ASPHALT, INC., ALBANY, N.Y.
ASPHALT - HUMBLE OIL CO., EVERETT, MASS.
CUTBACK ASPHALT - MOBIL OIL CO., ALBANY, N.Y.
CONCRETE, CLASS 'B' & 'AA' - JR. CARRARA & SONS INC., RUTLAND, VT.
REINFORCING STEEL, GRANITE BRIDGE CURB
& WATER REPELLENT - W.W. WYMAN, INC.,
GREENFIELD, MASS.
METAL PIPES, WATER PIPE SLEEVES,
CAST IRON GRATES - NEW ENGLAND
METAL CULVERT CO. WHITE RIVER JCT.,
VT.


(MATERIALS CONT.)
REINFORCED CONC. PIPES, GUARD RAIL ITEMS, FENCING ITEMS,
VERT. GRANITE CURB - S.T. GRISWOLD & CO., INC., ESSEX JCT. VT.
CONC. CATCH BASINS - EL. LEBARON FOUNDRY, BROCKTON, MASS.
JOINT SEALER - HOT POURED - ZIEGLER CHEMICAL & MINERAL CORP., N.Y., N.Y.
JOINT SEALER, PREFORMED - VT. STRUCTURAL STEEL CO., BURLINGTON, VT.
PAINT - AMSTERDAM COLOR WORKS, N.Y., N.Y. & STATEWIDE PAINTING CO., HADLEY, MASS.
ASPHALTIC ASBESTOS COATING, STRUCTURAL STEEL & SHEAR CONNECTORS - LYONS IRON WORKS, MANCHESTER, N.H.
STEEL PILING - BETHLEHEM STEEL CORP., BETHLEHEM, PA.
GALV. IRON WATER PIPE - SHEPARD CORP., WHITE RIVER JCT. VT.

SEAMLESS COPPER WATER TUBE,
CHASE BRASS & COPPER CO., INC.
EXTENSION SERVICE BOXES & CURB
STOPS - MUELLER CORR. DECATUR, ILL.
BRIDGE RAILING - WARD WELER CO., INC.,
NATICK, MASS.
GRANITE BRIDGE CURB - BARRETA
GRANITE CO. MILFORD, N.H.

Added Sheets:-
9 Structural Steel Sheets
Pratt Pit (3 Sheets)
12 Final Earthwork Sheets
24 Drainage Sheets (Construction)

STA 199+00.00
END TEMP. APPROACH BEGIN PROJECT
AP 019-2(2)
MP 6.19

MP 6.526
MP 0.00

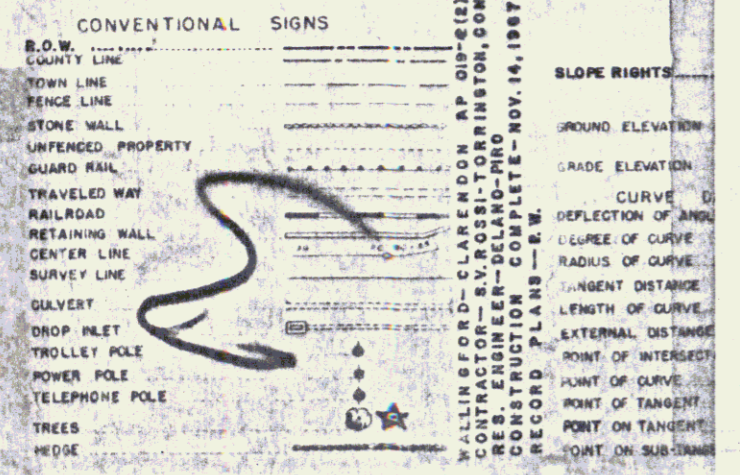

PROJECT: WALLINGFORD-CLARENDON
NUMBER: AP 019-2(2)
TYPE: BITUMINOUS CONCRETE PAVEMENT
CONTRACTOR: S.V. ROSSI, TORRINGTON, CONN.
YEAR: 1967
LOCATION: BEGINNING AT A POINT 0.338 MI. SOUTH OF
THE WALLINGFORD-CLARENDON TOWN LINE AND
EXTENDING NORTHERLY 3.650 MILES.

CONSTRUCTION AREA
U.S. ROUTE 7 & TOWN ROADS NOT IN
CONSTRUCTION AREA, EXCEPT FOR CROSSINGS

THESE PLANS ARE SUBJECT TO SUCH REVISIONS AS MAY BE
REQUIRED BY THE BUREAU OF PUBLIC ROADS OR THE COMMISSIONER
OF HIGHWAYS.
CONSTRUCTION IS TO BE CARRIED ON IN ACCORDANCE WITH THESE
PLANS AND THE STANDARD SPECIFICATIONS FOR HIGHWAY AND BRIDGE
CONSTRUCTION DATED APRIL, 1964, AS APPROVED BY THE BUREAU OF
PUBLIC ROADS ON OCT. 12, 1964, INCLUDING ALL SUBSEQUENT
APPROVED REVISIONS AND SUCH REVISED SPECIFICATIONS AND
SPECIAL PROVISIONS AS ARE INCORPORATED IN THESE PLANS.

CONTRACTOR - S.V. ROSSI
TORRINGTON, CONN.
RES. ENGINEER - DELANO, PIRO, &
INSPECTORS - R. STANCLIFF, C. WITHAM,
D. MAYO
RECORD PLANS - P.W.
CONTRACT:
DATED - AUGUST 2, 1966.
STARTED - AUGUST 4, 1966.
COMPLETED - NOVEMBER 14, 1967.
ACCEPTED - NOVEMBER 14, 1967.

APPROVED: *R.H. Crowl* ASST. CHIEF ENGINEER DATE: 11/21/63
APPROVED: *E.W. Stebbins* DISTRICT ENGINEER DATE: 11/14/63
APPROVED: *J.M. Brennan* BRIDGE ENGINEER DATE: 11/14/63
APPROVED: *J.M. Brennan* DISTRICT ENGINEER DATE: 11/20/63
APPROVED: *G.M. Lane* CHIEF ENGINEER DATE: 11/14/63
APPROVED: *G.D. Bishop* CHIEF ENGINEER DATE: 11/14/63

DEPARTMENT OF COMMERCE
BUREAU OF PUBLIC ROADS
APPROVED
DIVISION ENGINEER DATE
PROJECT: AP 019-2(2)
SHEET 11 OF SHEETS

