

Granite
SLOPE EDGINGS
NB 337+25 ~ 337+75 EH

BIT CONCRETE CURB, Item 555
330+00 - 334+00 LT

CONSTR U-TURN
SB 330+00 RT - NB 335+00 LT



STANDARD STEEL BEAM
GUARD RAIL, Item 545-A
NB 331+50 ~ 332+20 EH
SB 331+71 ~ 332+50 EH

PROPERTY LINE FENCE
w/ STEEL POSTS, Item 583-II, Mod.
NB 332+00 ~ 331+81 EH
NB 332+09 ~ 338+00 EH
SB 332+00 ~ 331+81 LT
SB 332+09 ~ 335+00 LT
NB 331+91 LT - SB 334+01 EH
NB 332+09 LT - SB 332+09 EH

D.M.#24
U.S. Elev
675.30

D.M.#25
U.S. Elev
679.625

D.M.#26
U.S. Elev
687.73

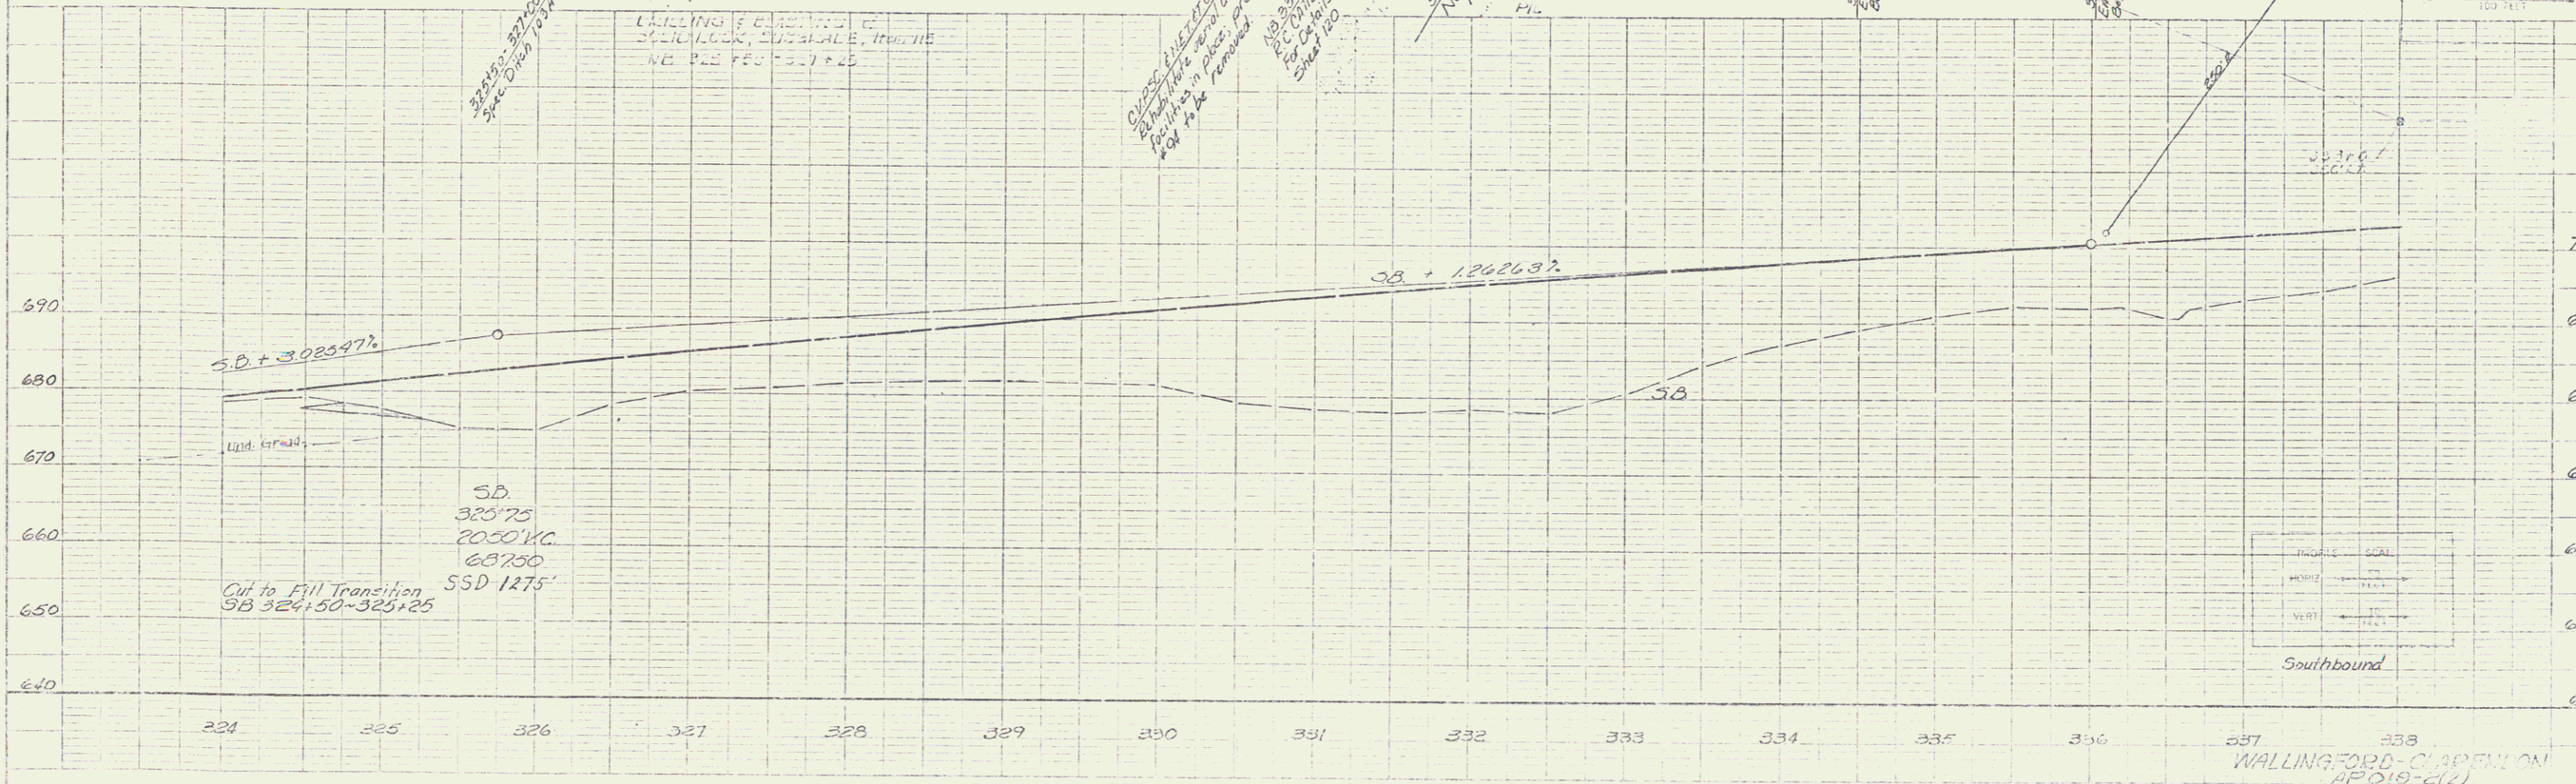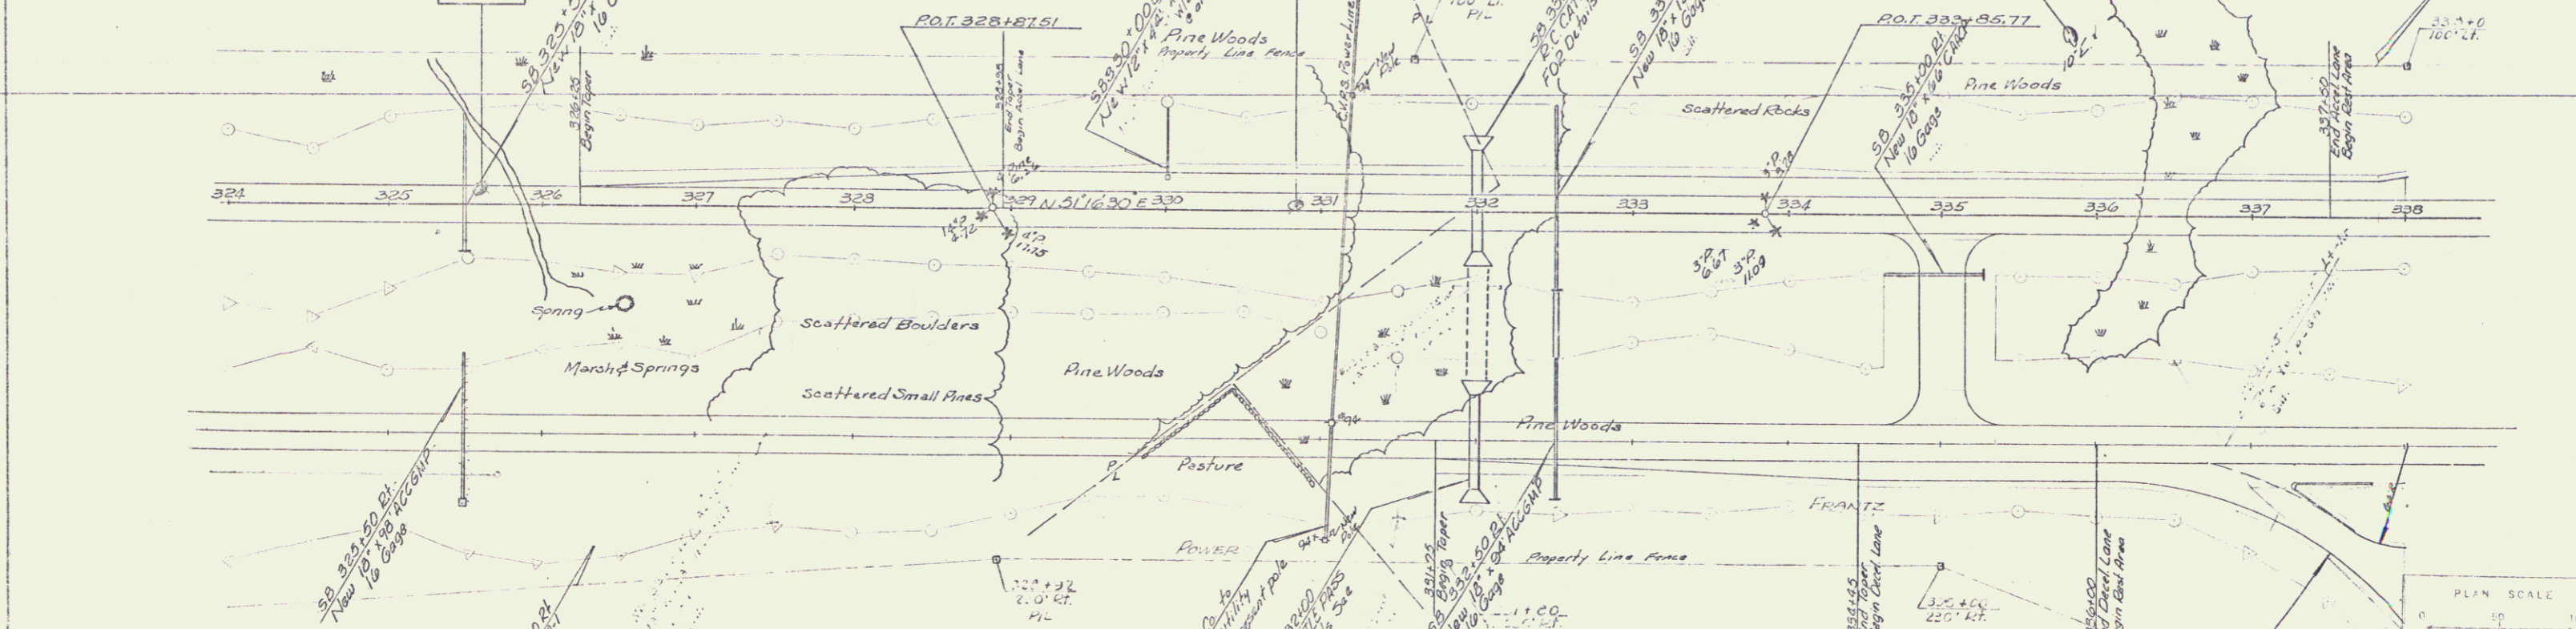

WALLINGFORD-CADPELLON
APD19-011
Sheet 5 of 20