


STANDARD STEEL BEAM GUARD
RAIL w/ STEEL POSTS
SB 353+98-354+33.1



Item 117
MUCK EXCAVATION
352+75-353+00

PROPERTY LINE FENCE
w/ STEEL POSTS, Item 583-II, Mod.
NB 352+00-364+00 RL
SB 352+00-364+00 LL

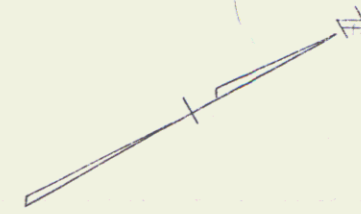

PLAN	REVISIONS	DATE
1	AS SHOWN	
2	AS SHOWN	
3	AS SHOWN	
4	AS SHOWN	
5	AS SHOWN	
6	AS SHOWN	
7	AS SHOWN	
8	AS SHOWN	
9	AS SHOWN	
10	AS SHOWN	

D.L. E.S.B.	N.B.
$\Delta 45^{\circ}07'30''$ LH	$\Delta 45^{\circ}07'30''$ LH
D 2'	D 1'46"
E 2964.79'	E 3274.05'
T 1132.07'	T 1293.01'
L 2136.23'	L 2404.29'
F 215.57'	F 246.30'
Bank $\frac{3}{8}$ " in 12"	Bank $\frac{1}{2}$ " in 12"

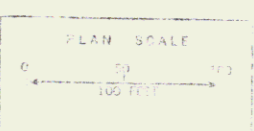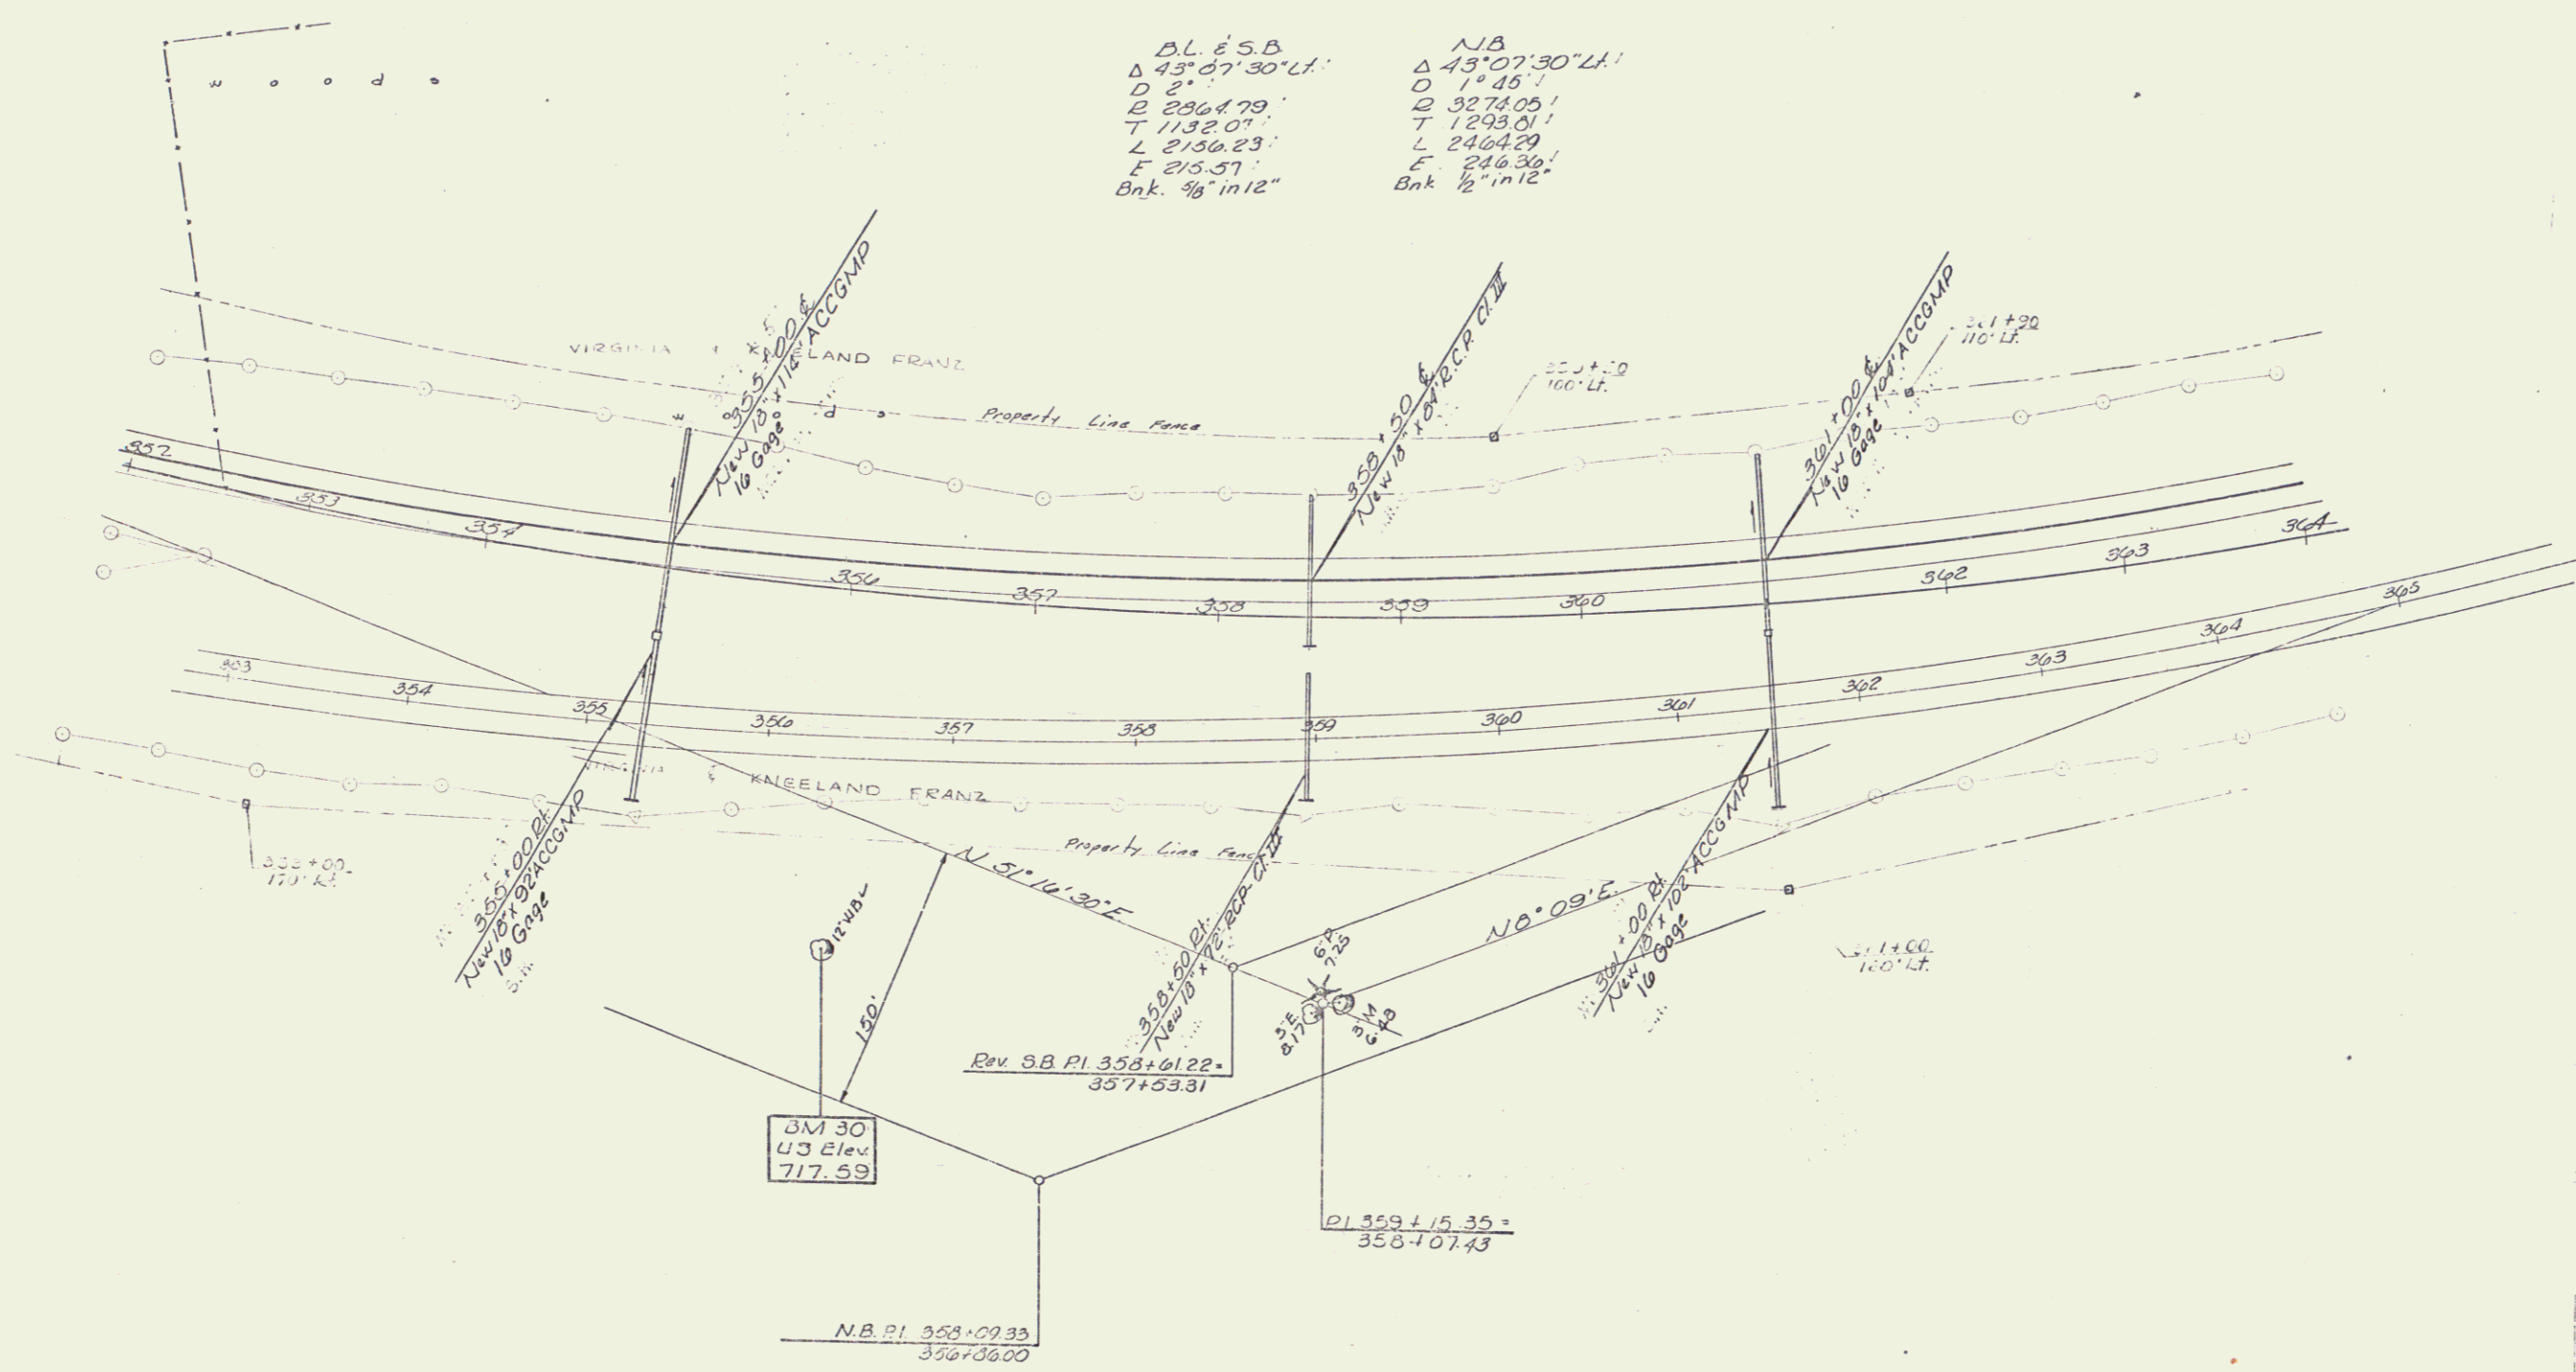

WALLINGFORD CLARENDON
SP 019 - 2(2)
Sheet 55 of 228