

JUTE MATTING, ITEM 623  
 209+00 - 211+00 MED.  
 212+50 - 214+00 MED.  
 218+50 - 222+50 RT.

STONE FILL, FOR SLOPE PROTECTION (LIGHT TYPE)  
 ITEM 512  
 NB 216+50-217+55 RT.  
 NB 217+35-218+50 RT.  
 SB 216+40-219+15 LT.

THREE CABLE GUARD RAIL WITH STEEL POSTS  
 ITEM 542  
 SB 217+00-221+50 LT.  
 NB 215+50-220+00 RT.  
 SB 217+50

TREATED TIMBER CURB  
 ITEM 553  
 SB 217+00-221+50 LT.  
 NB 217+00-221+50 RT.  
 SB 216+50-219+50


SUB-BASE OF SAND, ITEM 202  
 NB 208+00-215+00  
 SB 208+00-218+00

PROPERTY LINE FENCE WITH STEEL POSTS  
 ITEM 583 II MOD.

DRIVE GATE FOR PROPERTY LINE FENCE  
 ITEM 583 V  
 209+50 RT.  
 212+00 RT.  
 223+00 9 RT.

CONSTRUCT DRIVE  
 209+50 RT.  
 212+00 RT.  
 223+00 RT.  
 EDW Bid Item

STANDARD STEEL BEAM GUARD RAIL WITH STEEL POSTS, ITEM 585-A  
 210+70-211+55 SB LT.

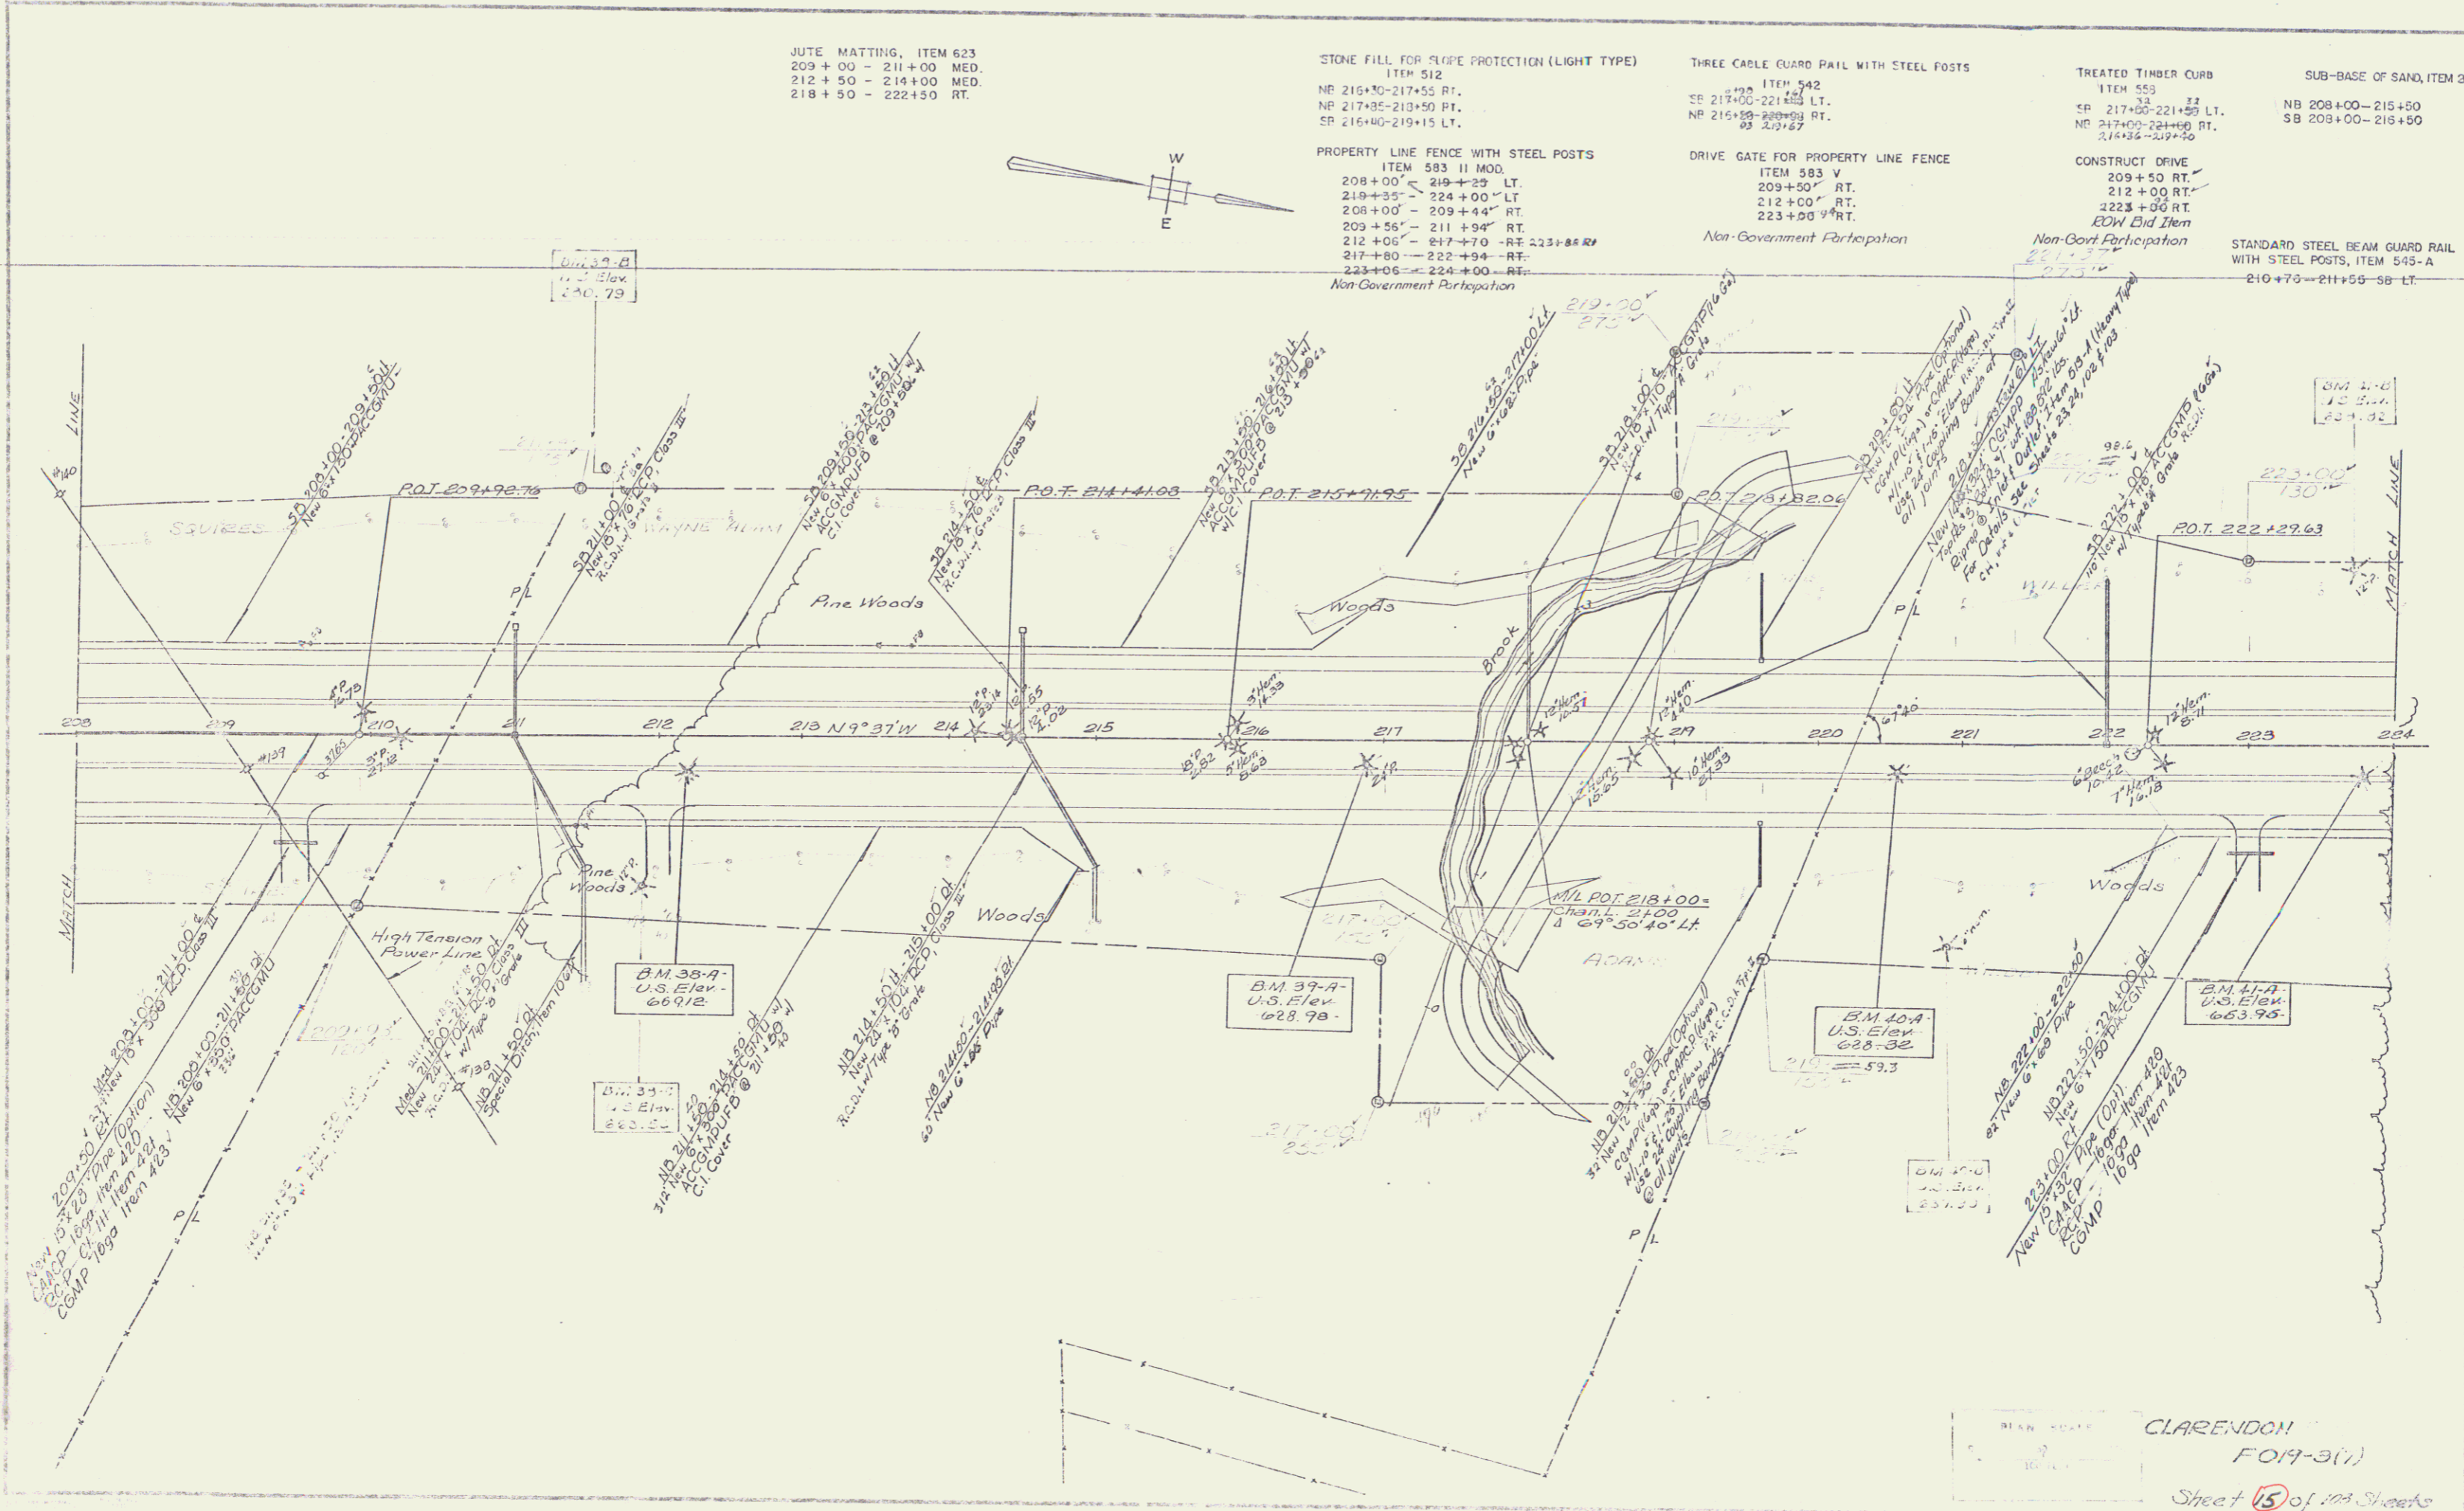

CLARENDON  
 FO19-3(1)  
 Sheet 15 of 104 Sheets