

GRAVEL SLOPE EDGING - ITEM 556-A
279+74.34 TO 254+00 LT. & RT.

THREE CABLE GUARD RAIL W/STEEL POSTS
ITEM 542
SB 250+00 - 251+00 LT.
NB 249+94 - 252+50 RT.

BITUMINOUS CONCRETE SURFACE FOR
CUTTERS & TRAFFIC ISLANDS, ITEM 554
243+50 MED.

JUTE MATTING, ITEM 623.
242+50 - 243+50 MED.
244+50 - 246+00 MED.
249+00 - 251+50 RT.


PROPERTY LINE FENCE WITH STEEL POSTS
ITEM 583-11 MGD.
239+00 - 242+04 LT.
243+05 - 258+90 LT.
239+00 - 240+04 RT.
240+36 - 253+00 RT.
Non-Government Participation

STANDARD STEEL BEAM GUARD RAIL WITH STEEL POSTS, ITEM 545-A
NB 244+00 - 245+14 RT.
NB 253+35 - 254+00 LT.
SB 249+00 - 253+00 LT.

DRIVE GATE FOR PROPERTY LINE FENCE
ITEM 583 V
243+00 LT.
240+50 RT.
240+50 RT.
Non-Government Participation

CONSTRUCT DRIVE
243+00 LT.
240+50 RT.
253+00 RT. (Non-Govt. Part.)
Non-Government Participation
ECW Bid Item

SUB-BASE OF SAND, ITEM 202
NB 239+00 - 249+00
SB 239+50 - 249+00

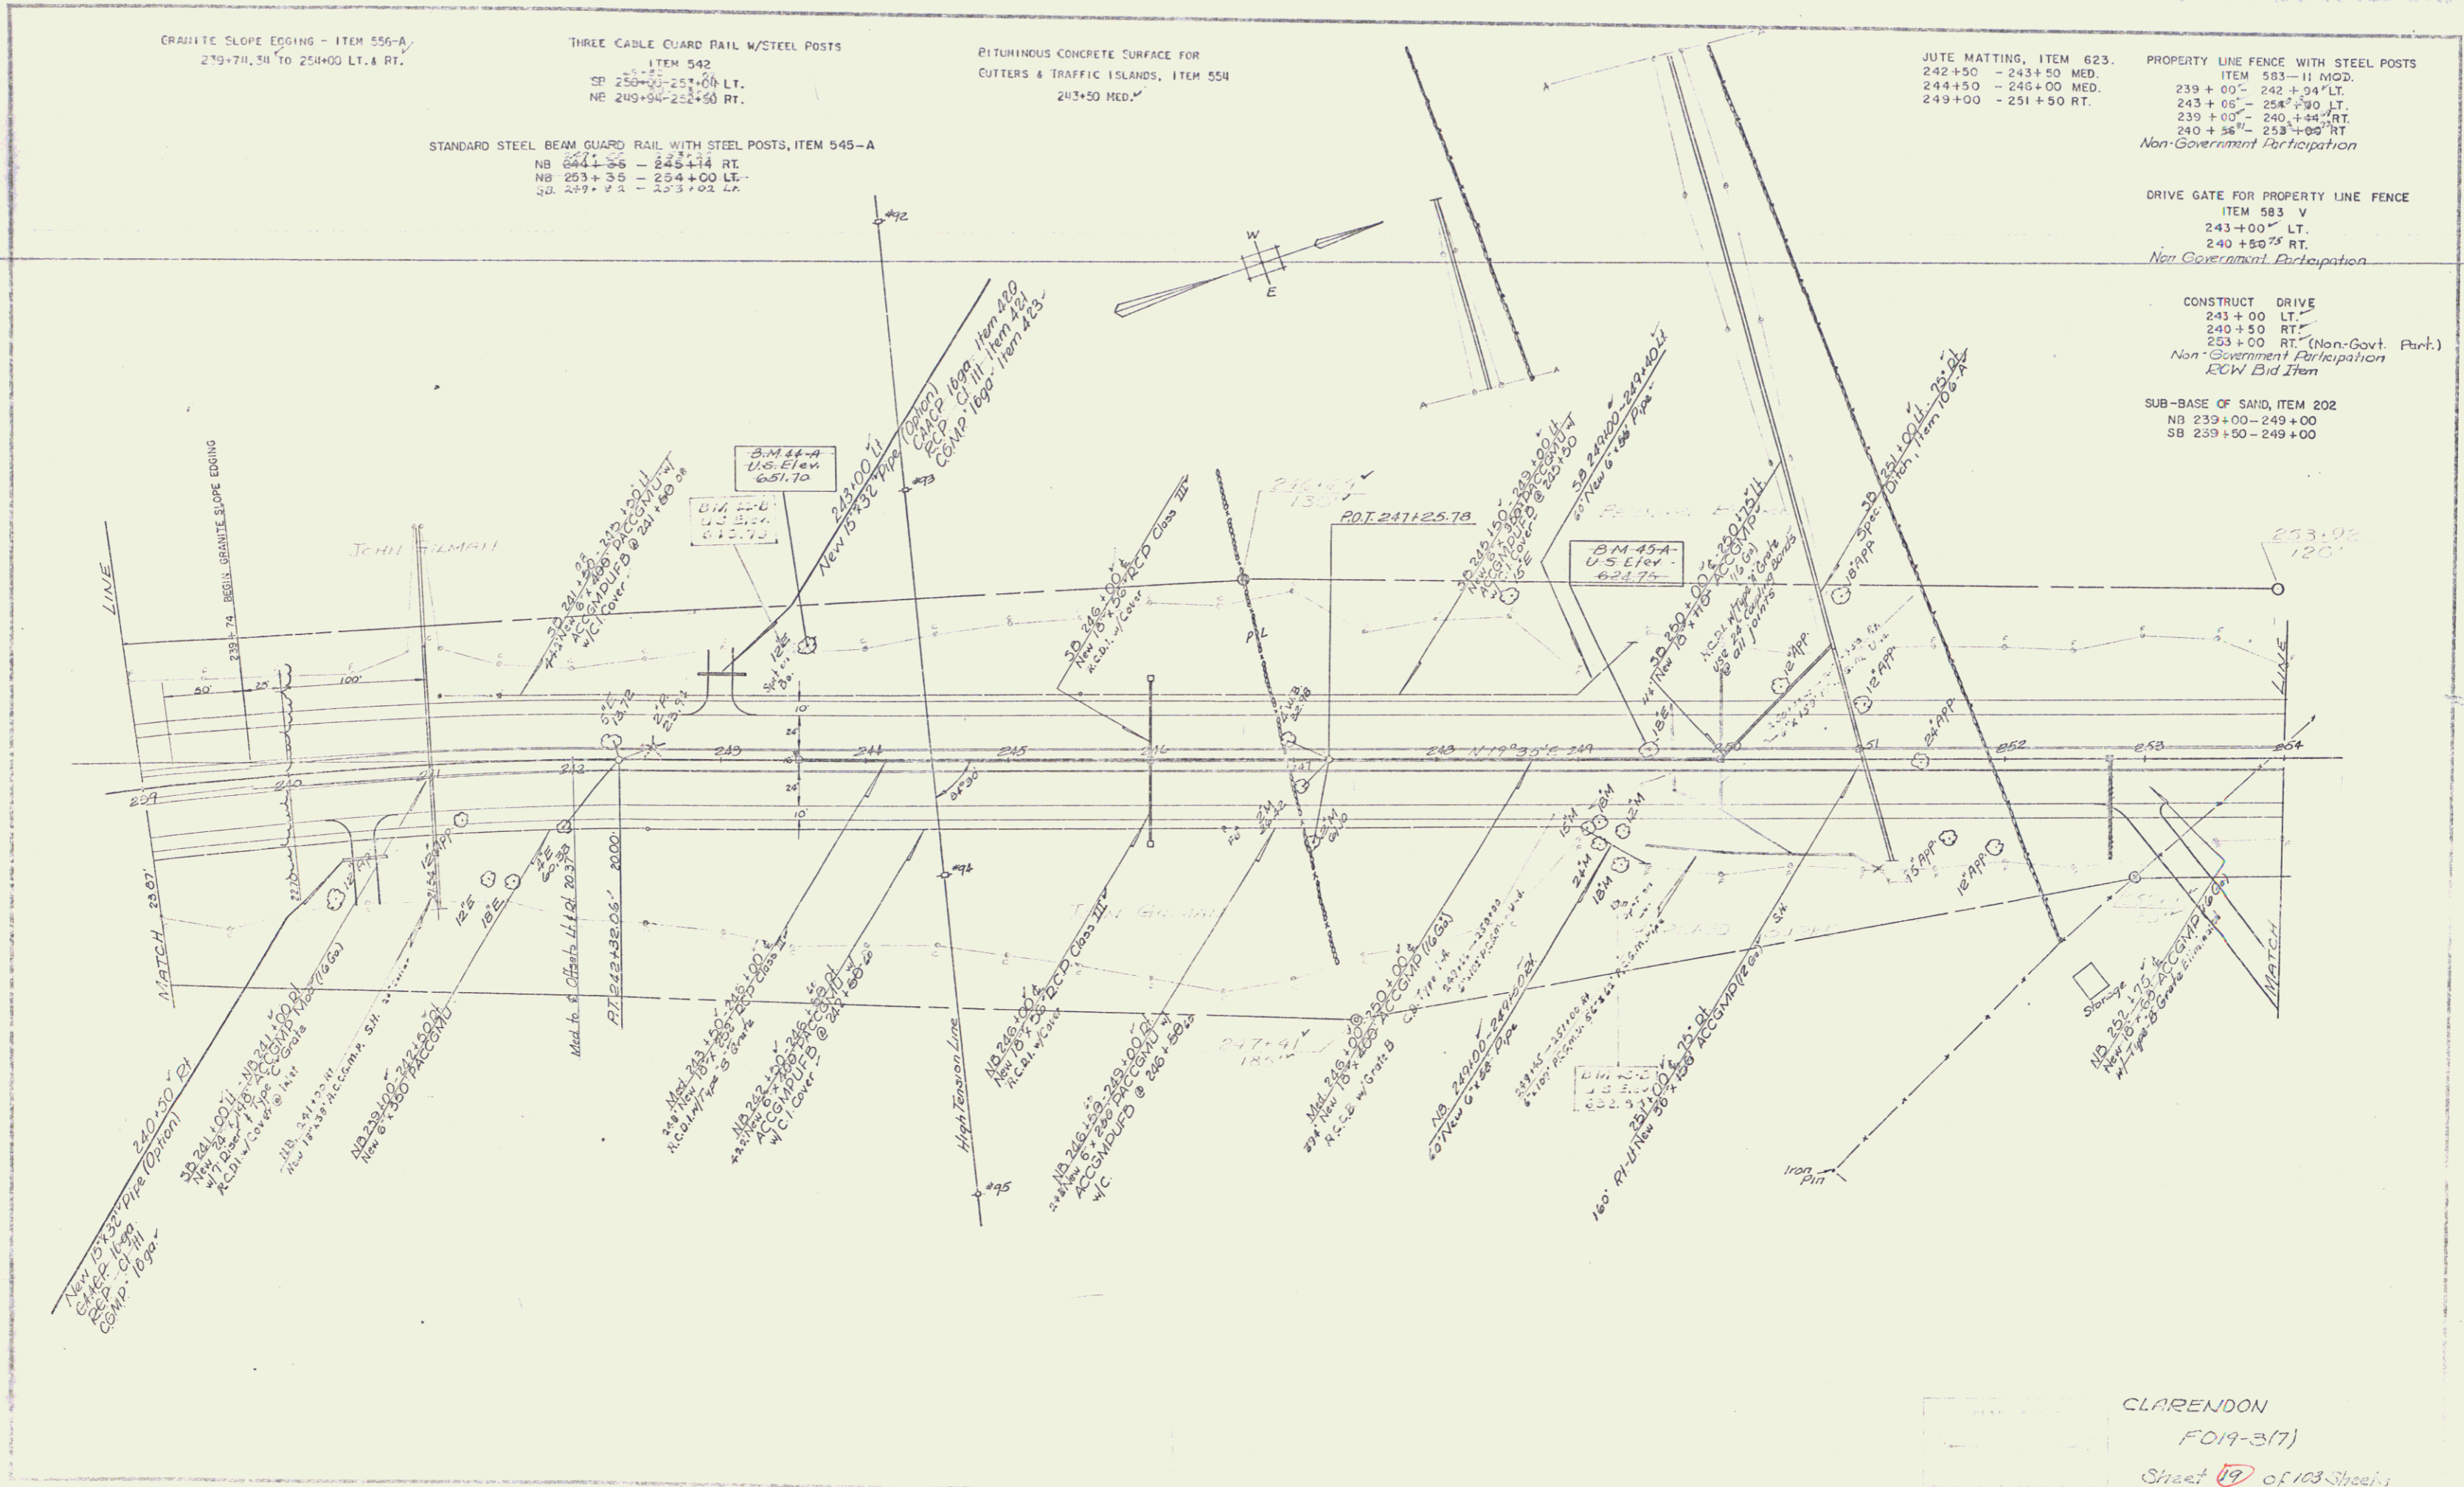

CLARENDON
FO19-3(7)
Sheet 19 of 103 Sheets