

RECORD PLANS FOR AP 019-3(7)
BITUMINOUS CONCRETE SURFACE FOR
GUTTERS & TRAFFIC ISLANDS, ITEM 554, MOD.
256+19 - 259+19
260+19 - 262+49

GRANITE CURB EDGING
ITEM 556-A
256+10 - 259+10
260+17 - 263+00

BITUMINOUS CONCRETE SURFACE FOR
GUTTERS & TRAFFIC ISLANDS, ITEM 554, MOD.
256+19 - 259+19
260+19 - 262+49

GRANITE CURB EDGING
ITEM 556-A
256+10 - 259+10
260+17 - 263+00

SPEDING, ITEM 611
FERTILIZER, ITEM 615
TOPSOIL, ITEM 621
259+50 - 259+60 M.D.
252+49 - 263+00 M.D.

CONSTRUCT DRIVES
RAMP A 6+50 LT.
A 8+50 LT.
A 46+92 LT. (1430)
A 174+00 LT.
10+70 LT.
18+75 LT.

STANDARD STEEL BEAM GUARD RAIL
WITH STEEL POSTS, ITEM 345-A
250+00 - 261+02 LT.


ALUM. COATED CHAIN LINK
FENCE (6' HIGH) ITEM 581-1
251+00 - 257+00 LT.

CONTROL OF ACCESS LIMITS
257+44.8 - 263+00
(EXCEPT AT RAMP ENTRANCES RT. & LT.
OF STA 259+69.03)

PROPERTY LINE FENCE WITH STEEL POSTS
ITEM 57-3-II MOD.
RAMP A 11+28 RT. - 263+00 RT.
to be erected prior to construction
19+20 - 263+30 LT.

PLANK GUARD RAIL, ITEM 540
257+50 - CONSTRUCT BARRICADE

DRILLING & BLASTING OF SOLID ROCK SUBGRADE, ITEM 115
259+50 - 260+50

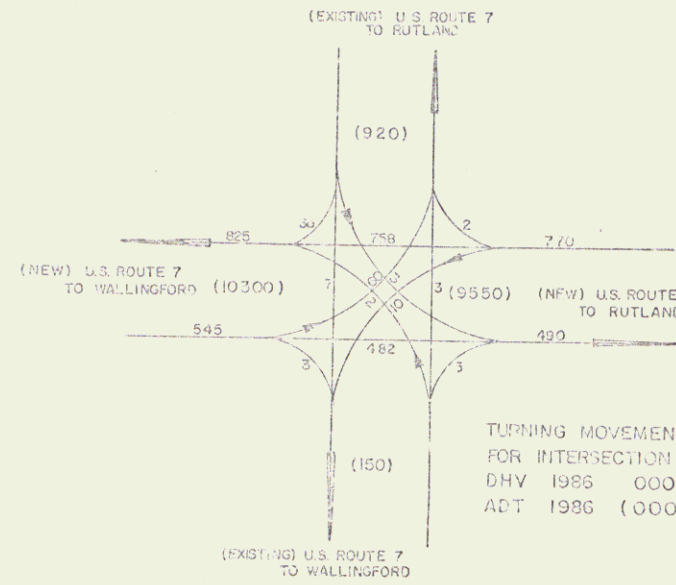

General notes regarding the intersection of U.S. Route 7 and the proposed ramp. The notes describe the existing conditions, the proposed construction, and the required materials and methods. The notes are written in a cursive script and are located in the lower left corner of the plan.

BEGIN APPROPRIATE
CONSTRUCTION

