

PLAN	CONTRACT NO.	DATE
DESCRIPTION	PROJECT NO.	SCALE
BY	APPROVED	
CHECKED		
NO.		

SEEDING, ITEM 611,  
FERTILIZER ITEM 615,  
TOPSOIL, ITEM 621  
263+00-273+00 MED.

THREE RAILS CROSS RAIL W/STEEL POSTS, ITEM 512  
266+42 - 273+50 LT.


CONSTRUCT DRIVES  
10'± LT.  
18'± LT.

PROPERTY LINE FENCE W/STEEL POSTS  
ITEM 583 II MOD. #0  
RAMP A 20+82 RT - 266+42 LT.  
266+42 - 267+24 LT.  
267+24 - 275+00 RT.  
275+00 - 278+00 RT.  
278+00 - 279+00 LT.

NON-GOV'T PART  
UNCLASSIFIED CHANNEL EXCAVATION  
ITEM 108-C  
266+50 RT.  
NON-GOV'T PART  
STRUCTURE EXCAVATION, ITEM 109  
266+50 E

TREATED TIMBER CURB, ITEM 558  
273+00-272+00 LT.  
STD. STEEL BEAM GUARD RAIL ITEM 545-A  
266+10 - 267+42 RT.  
5+47 - 26

GRANITE SLOPE EDGING, ITEM 555-A  
263+00 - 273+00 LT.  
263+00 - 273+00 RT.  
DRILLING & FLASHING OF SOLID  
ROCK SUBGRADE, ITEM 115  
258+50 - 266+50 RT.  
271+80 - 277+50 ± 1/2"±

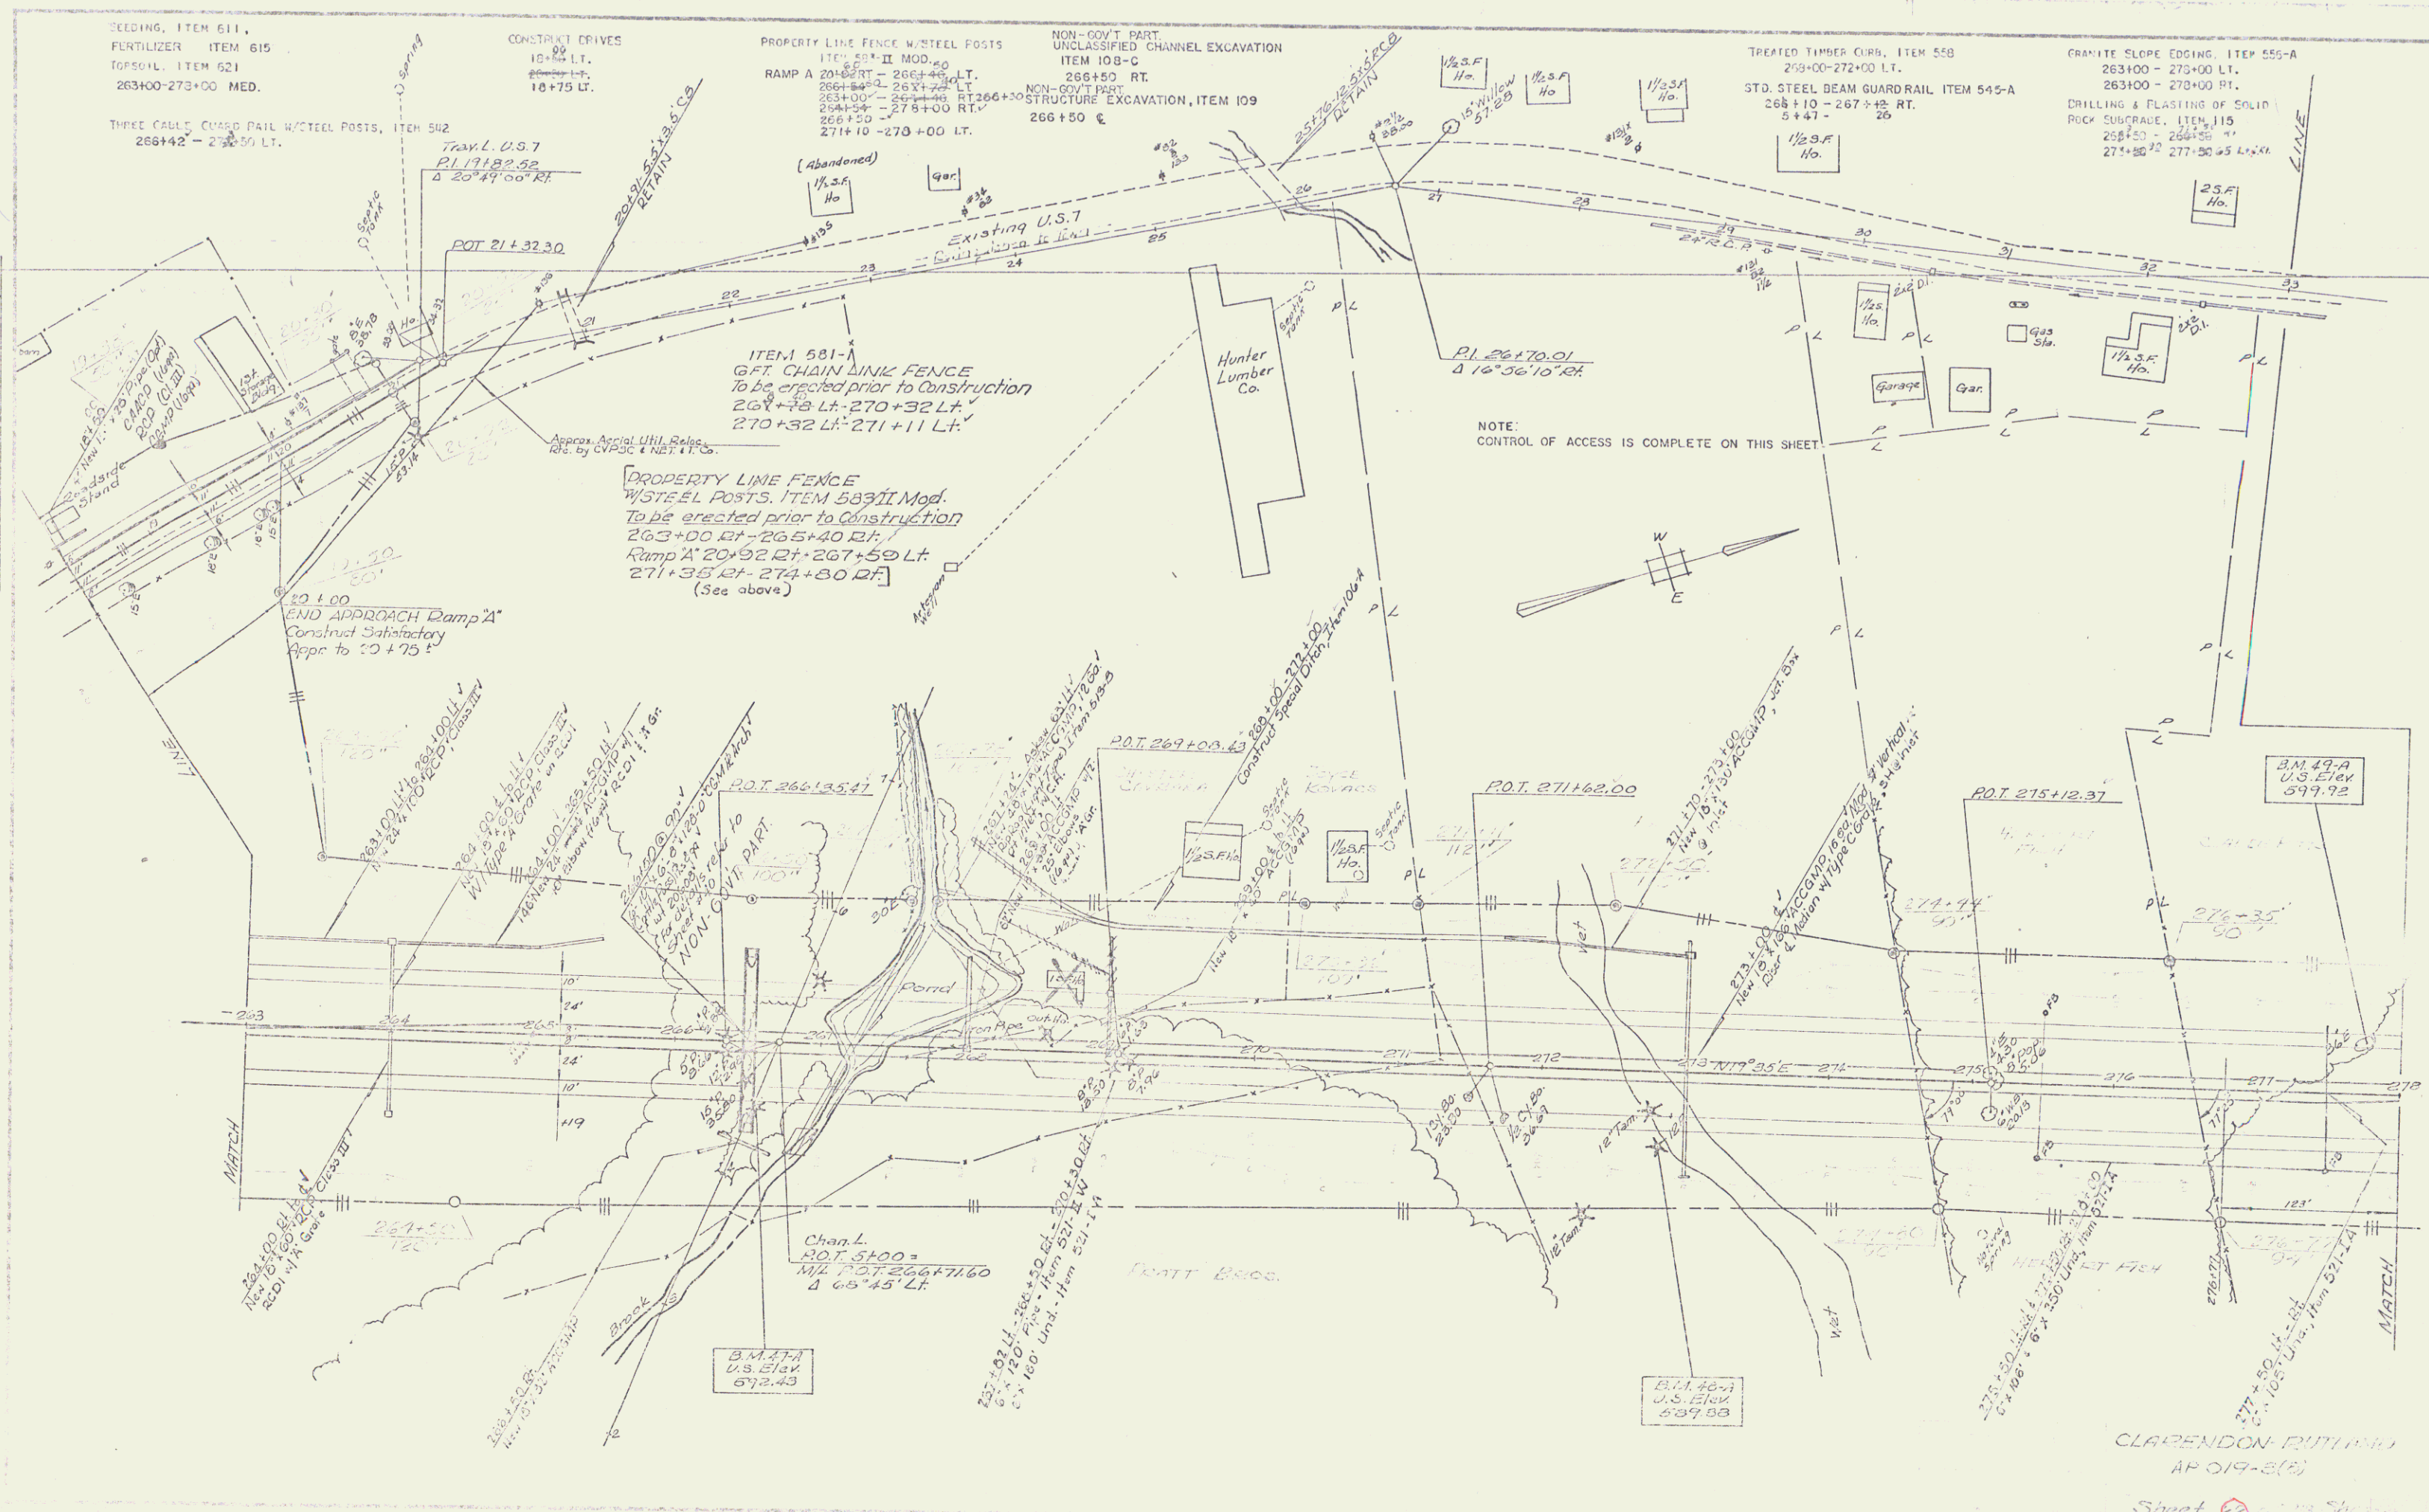

ITEM 581 -  
6 FT. CHAIN LINK FENCE  
to be erected prior to construction  
267+13 LT - 270+32 LT.  
270+32 LT - 271+11 LT.

PROPERTY LINE FENCE  
W/STEEL POSTS, ITEM 583 II Mod.  
To be erected prior to construction  
263+00 RT - 265+40 RT.  
Ramp A 20+82 RT - 267+59 LT.  
271+35 RT - 274+80 RT.  
(See above)

NOTE:  
CONTROL OF ACCESS IS COMPLETE ON THIS SHEET

CLARENDON RUTHERFORD  
AP 019-8(2)

Sheet 62 of 78 Sheets