


PLAN	CLARENCON-ROULAND
DATE	11/15/58
BY	J. W. B. & SONS, INC.
NO.	100-100

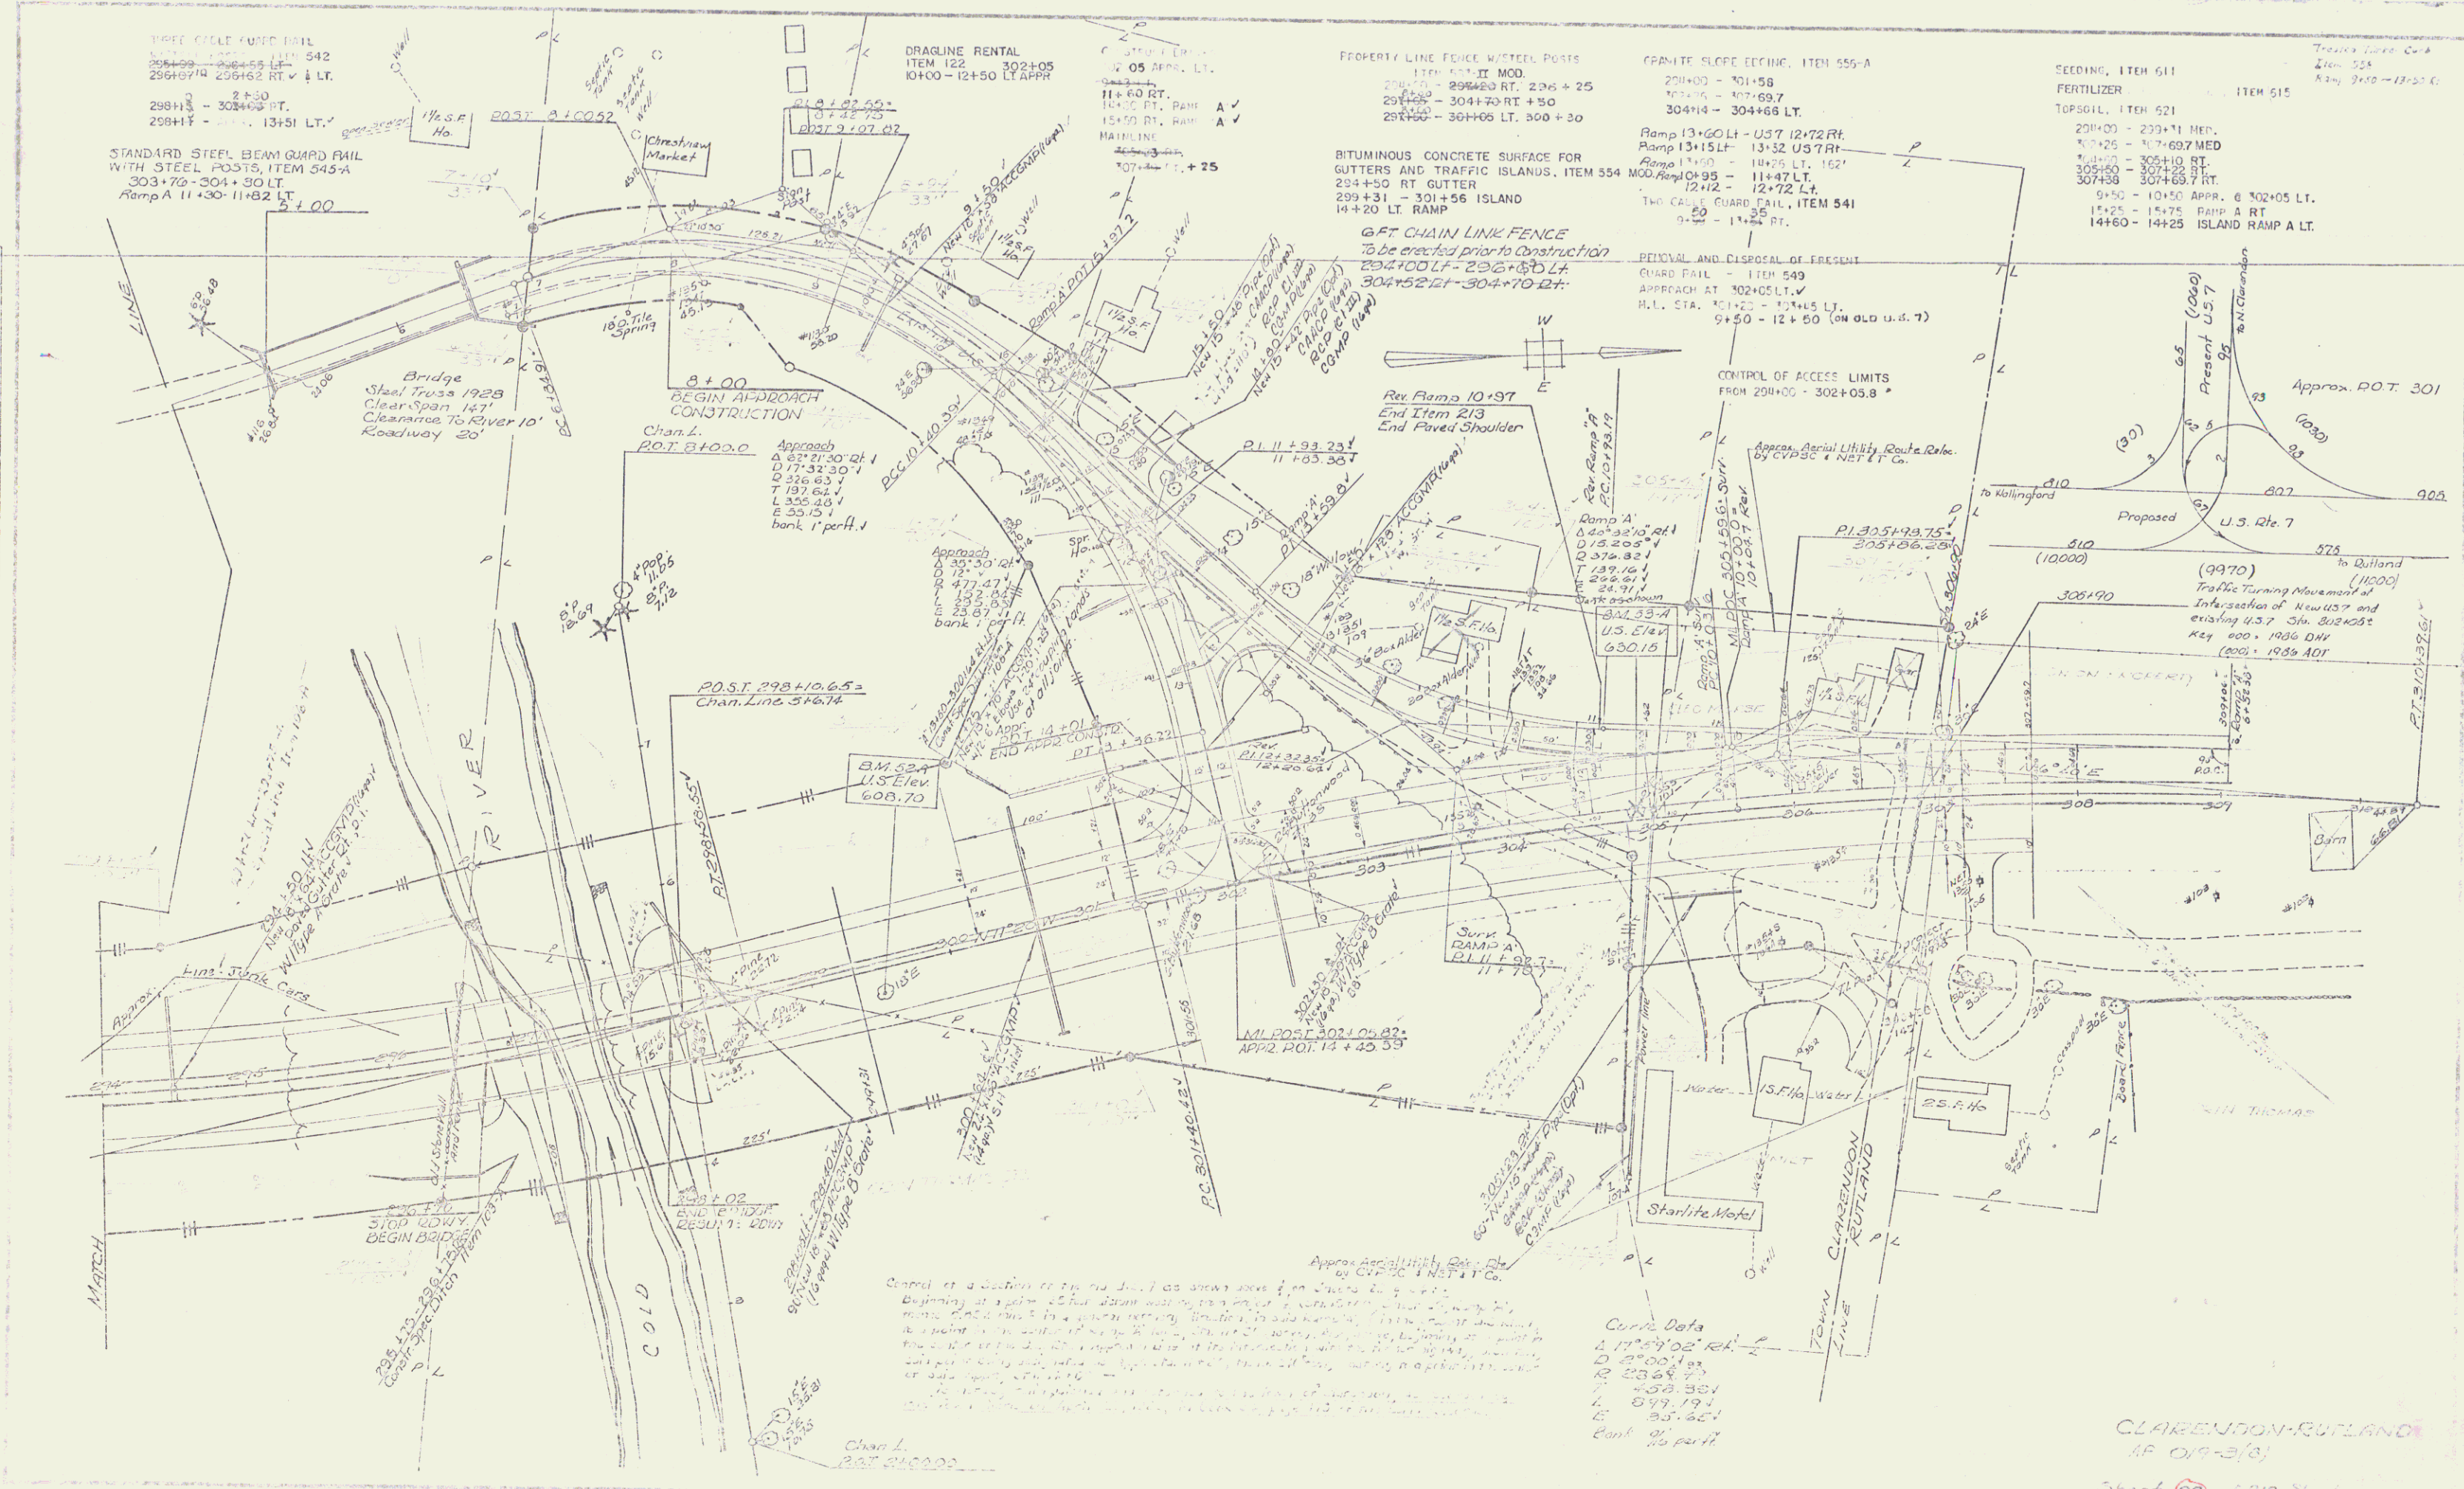

CLARENCON-ROULAND  
 AF 019-2(3)  
 Sheet 27 of 213 Sheets