


EXCAVATION & REMOVAL OF ROAD SURFACES
AND/OR PAVEMENTS, ITEM 119
23+25 - 24+15 ± RT.

CONSTRUCT APPROACH
23+25

CONSTRUCT DRIVE
20+25 RT & LT ✓

PLAN	DATE	BY	CHKD
NO. 1	10/1/78	J. W. H.	J. W. H.
NO. 2	10/1/78	J. W. H.	J. W. H.
NO. 3	10/1/78	J. W. H.	J. W. H.
NO. 4	10/1/78	J. W. H.	J. W. H.
NO. 5	10/1/78	J. W. H.	J. W. H.
NO. 6	10/1/78	J. W. H.	J. W. H.
NO. 7	10/1/78	J. W. H.	J. W. H.
NO. 8	10/1/78	J. W. H.	J. W. H.
NO. 9	10/1/78	J. W. H.	J. W. H.
NO. 10	10/1/78	J. W. H.	J. W. H.

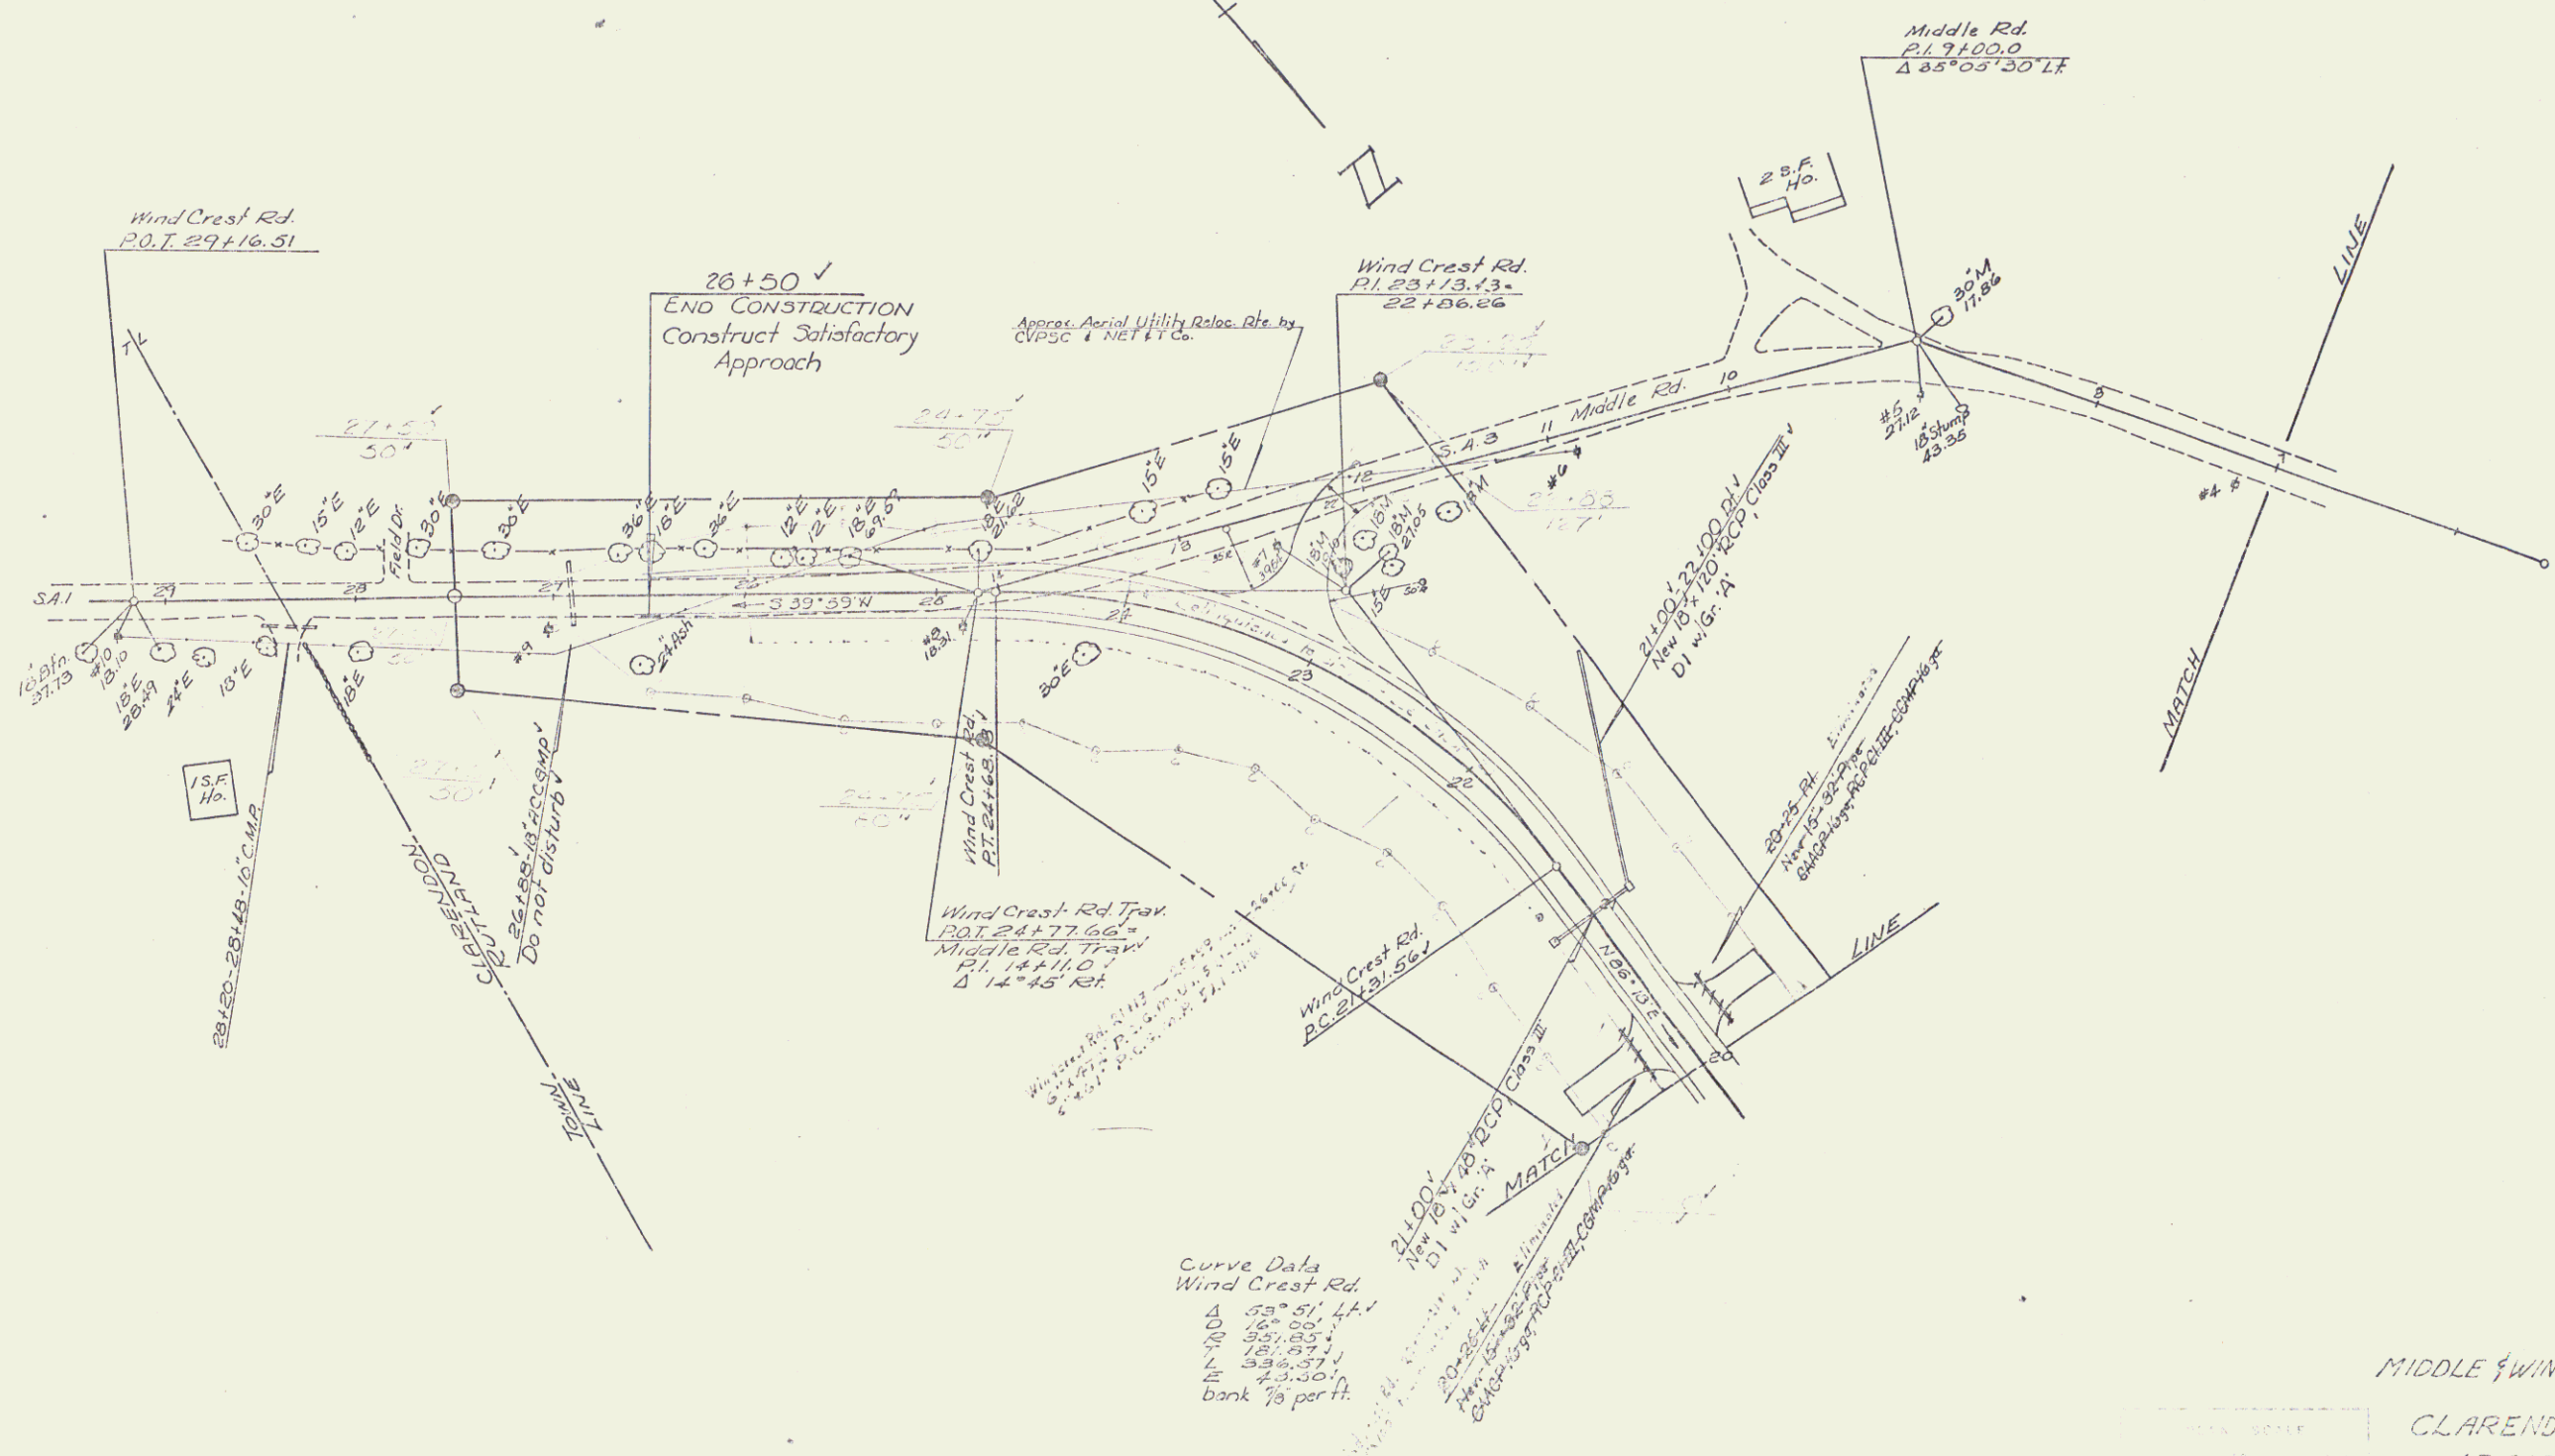

Curve Data
Wind Crest Rd.
93°51' LHT
160.00'
181.87'
193.37'
214.00'
bank 7% per ft.

MIDDLE & WIND CREST ROADS

CLARENDON - RUTLAND
AP 019-3(2)

Sheet 20 of 210 Sheets