


EXCAVATION & REMOVAL OF ROAD SURFACE
ON ROADWAY, ITEM 119-A
2+25 - 24+15 ± RT.

CONSTRUCT APPROACH
2+25

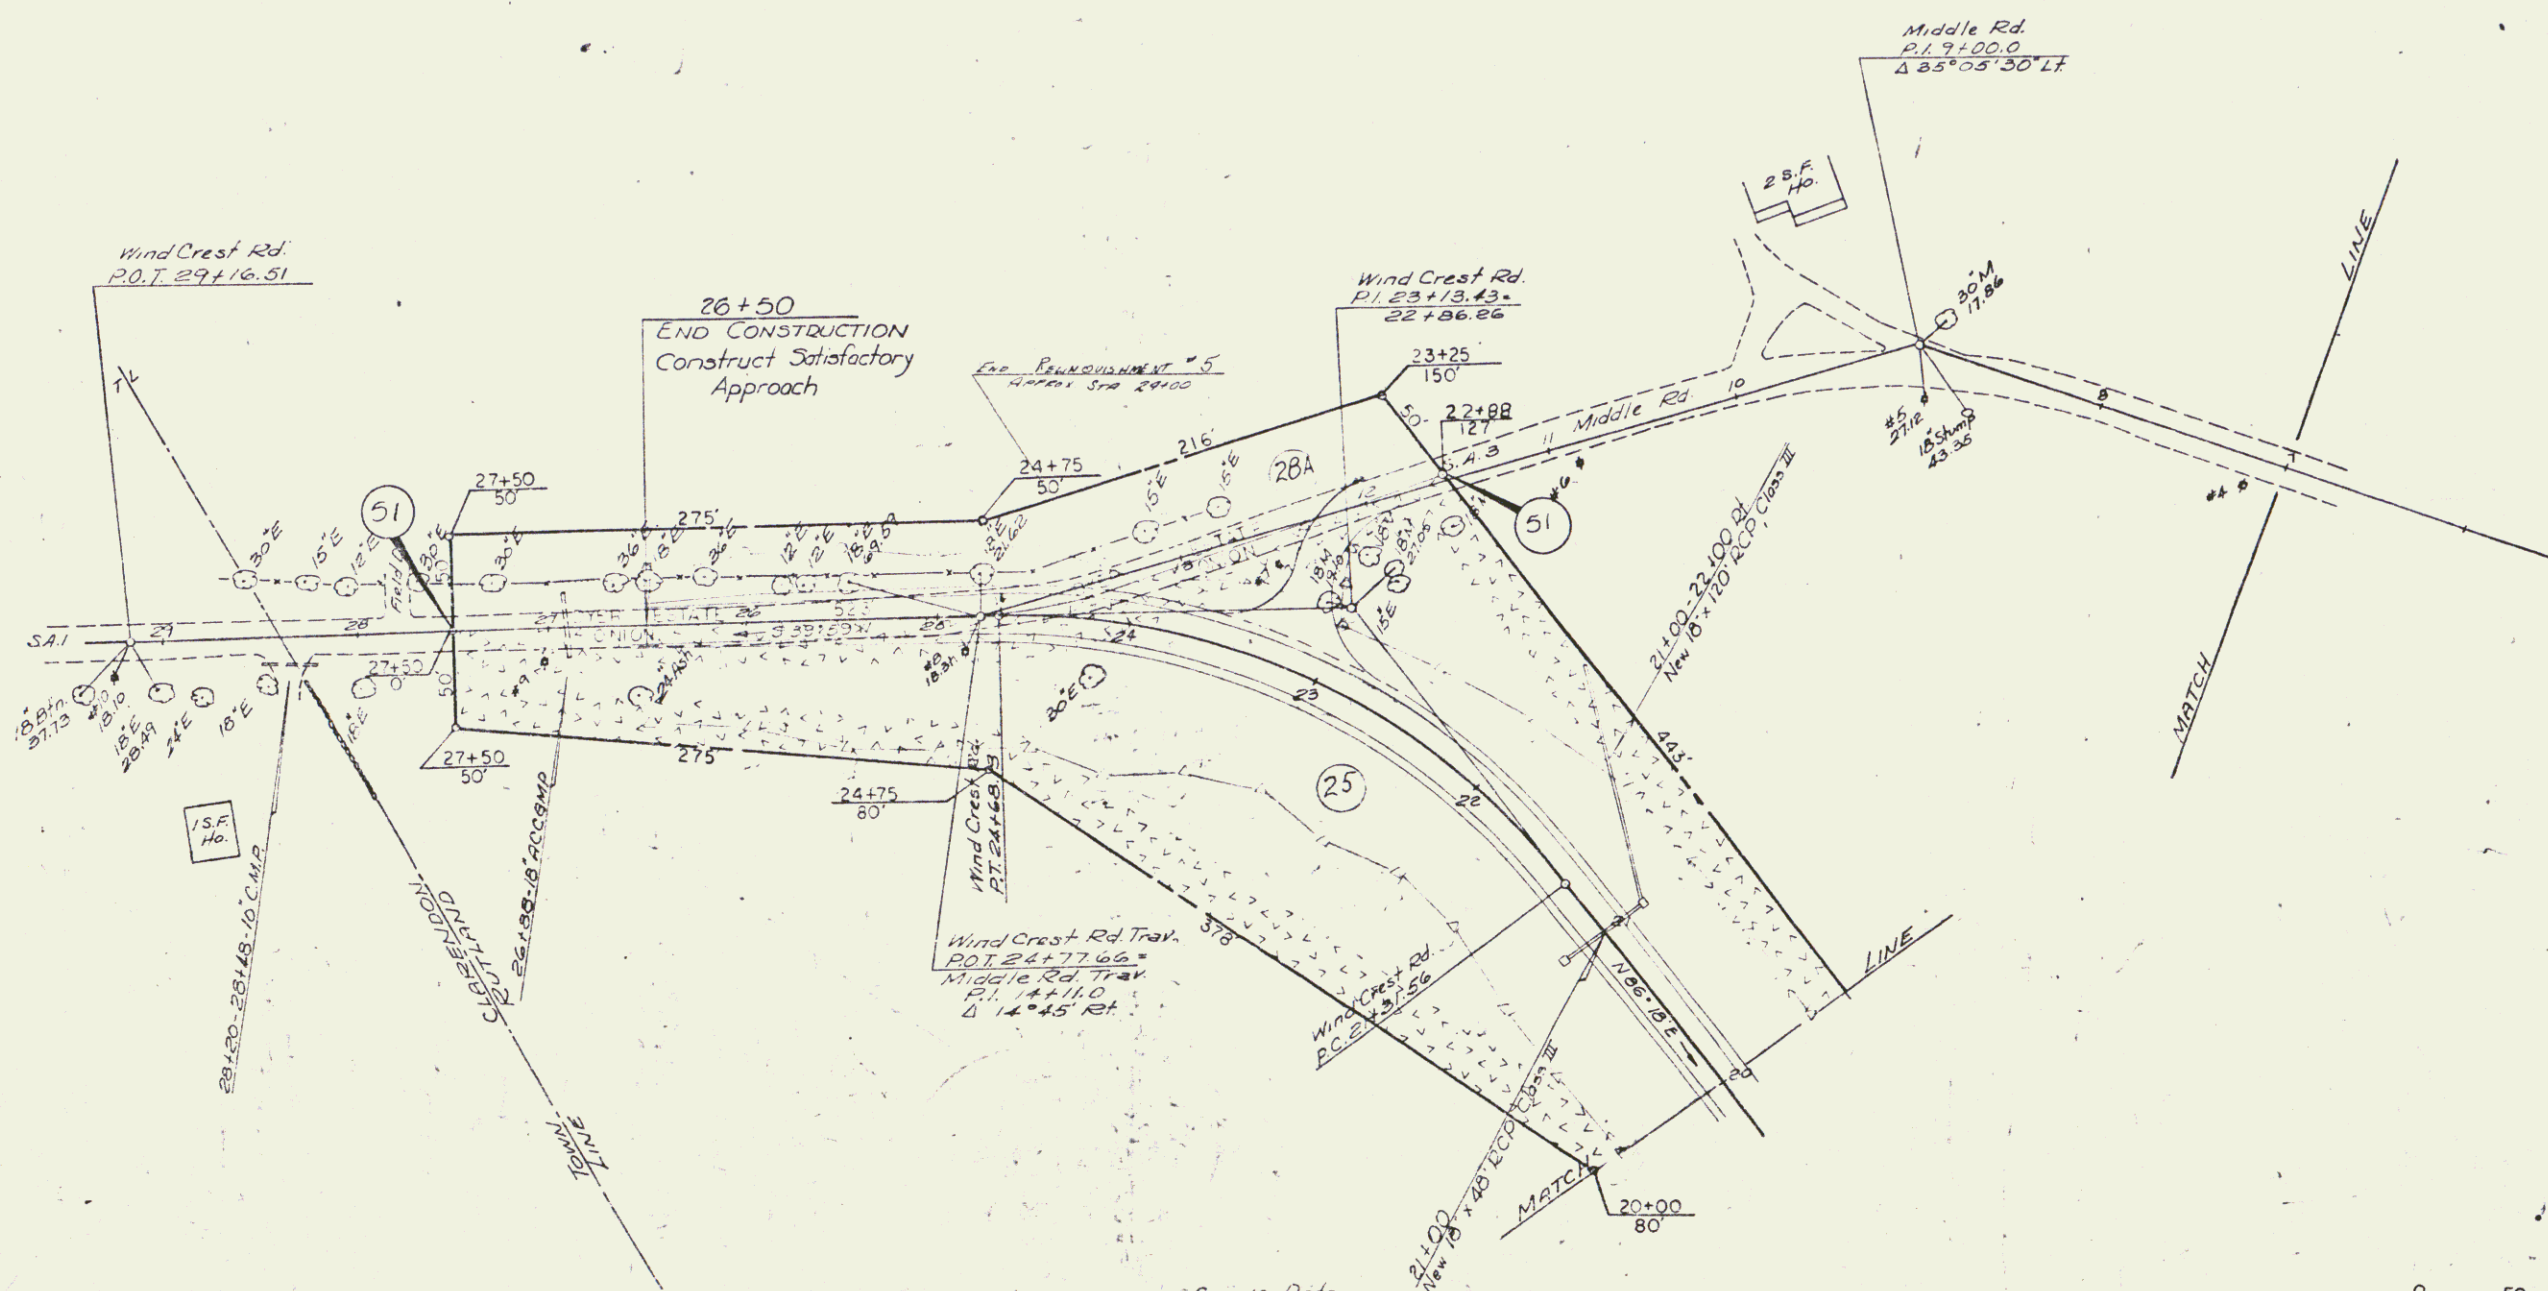

Curve Data
Wind Crest Rd.
Δ 59° 51' Lt
R 125.00
L 135.00
L 135.00
L 135.00
L 135.00
bank 70 per ft

SCALE: 0 50 100 150

MIDDLE & WIND CREST ROADS
VERMONT DEPARTMENT OF HIGHWAYS
CLARENDON-RUTLAND
FO19-3(10)

Sheet 23 of 24