

THESE LINES SHALL BE 1720 R.F.
 31+00 - 321+70.4
 07+20 - 321+84 R.L.

SEEDING, ITEM 511
 FERTILIZER, ITEM 615
 TOPSOIL, ITEM 521
 *116+00 - *112+00 ISLAND
 *113+50 - *120+00 RT.

GRANITE SLOPE EDGING
 ITEM 555-A
 *116+00 - *112+00

DRILLING & BLASTING OF SOLID
 ROCK SUBGRADE, ITEM 115
 *125+50 - *112+00

CONSTRUCT DRIVES
 *120+00 RT.
 *110+10 RT.
 318+00-RT (TURN-AROUND)
 322+00 RT.
 *115
 323+60 RT.


THREE CABLE CHAIN RAIL WITH
 STEEL POSTS, ITEM 542
 *118+00 - *117 RT.
 *117+50 - *121+54 RT.

REMOVAL OF CONCRETE PAVEMENT
 ITEM 103-B
 324+00 - 332+00

RIPRAP (LIGHT TYPE) ITEM 513-B

320+15 RT.

PI 111	11/15/54	11/15/54
PI 112	11/15/54	11/15/54
PI 113	11/15/54	11/15/54
PI 114	11/15/54	11/15/54
PI 115	11/15/54	11/15/54
PI 116	11/15/54	11/15/54
PI 117	11/15/54	11/15/54
PI 118	11/15/54	11/15/54
PI 119	11/15/54	11/15/54
PI 120	11/15/54	11/15/54

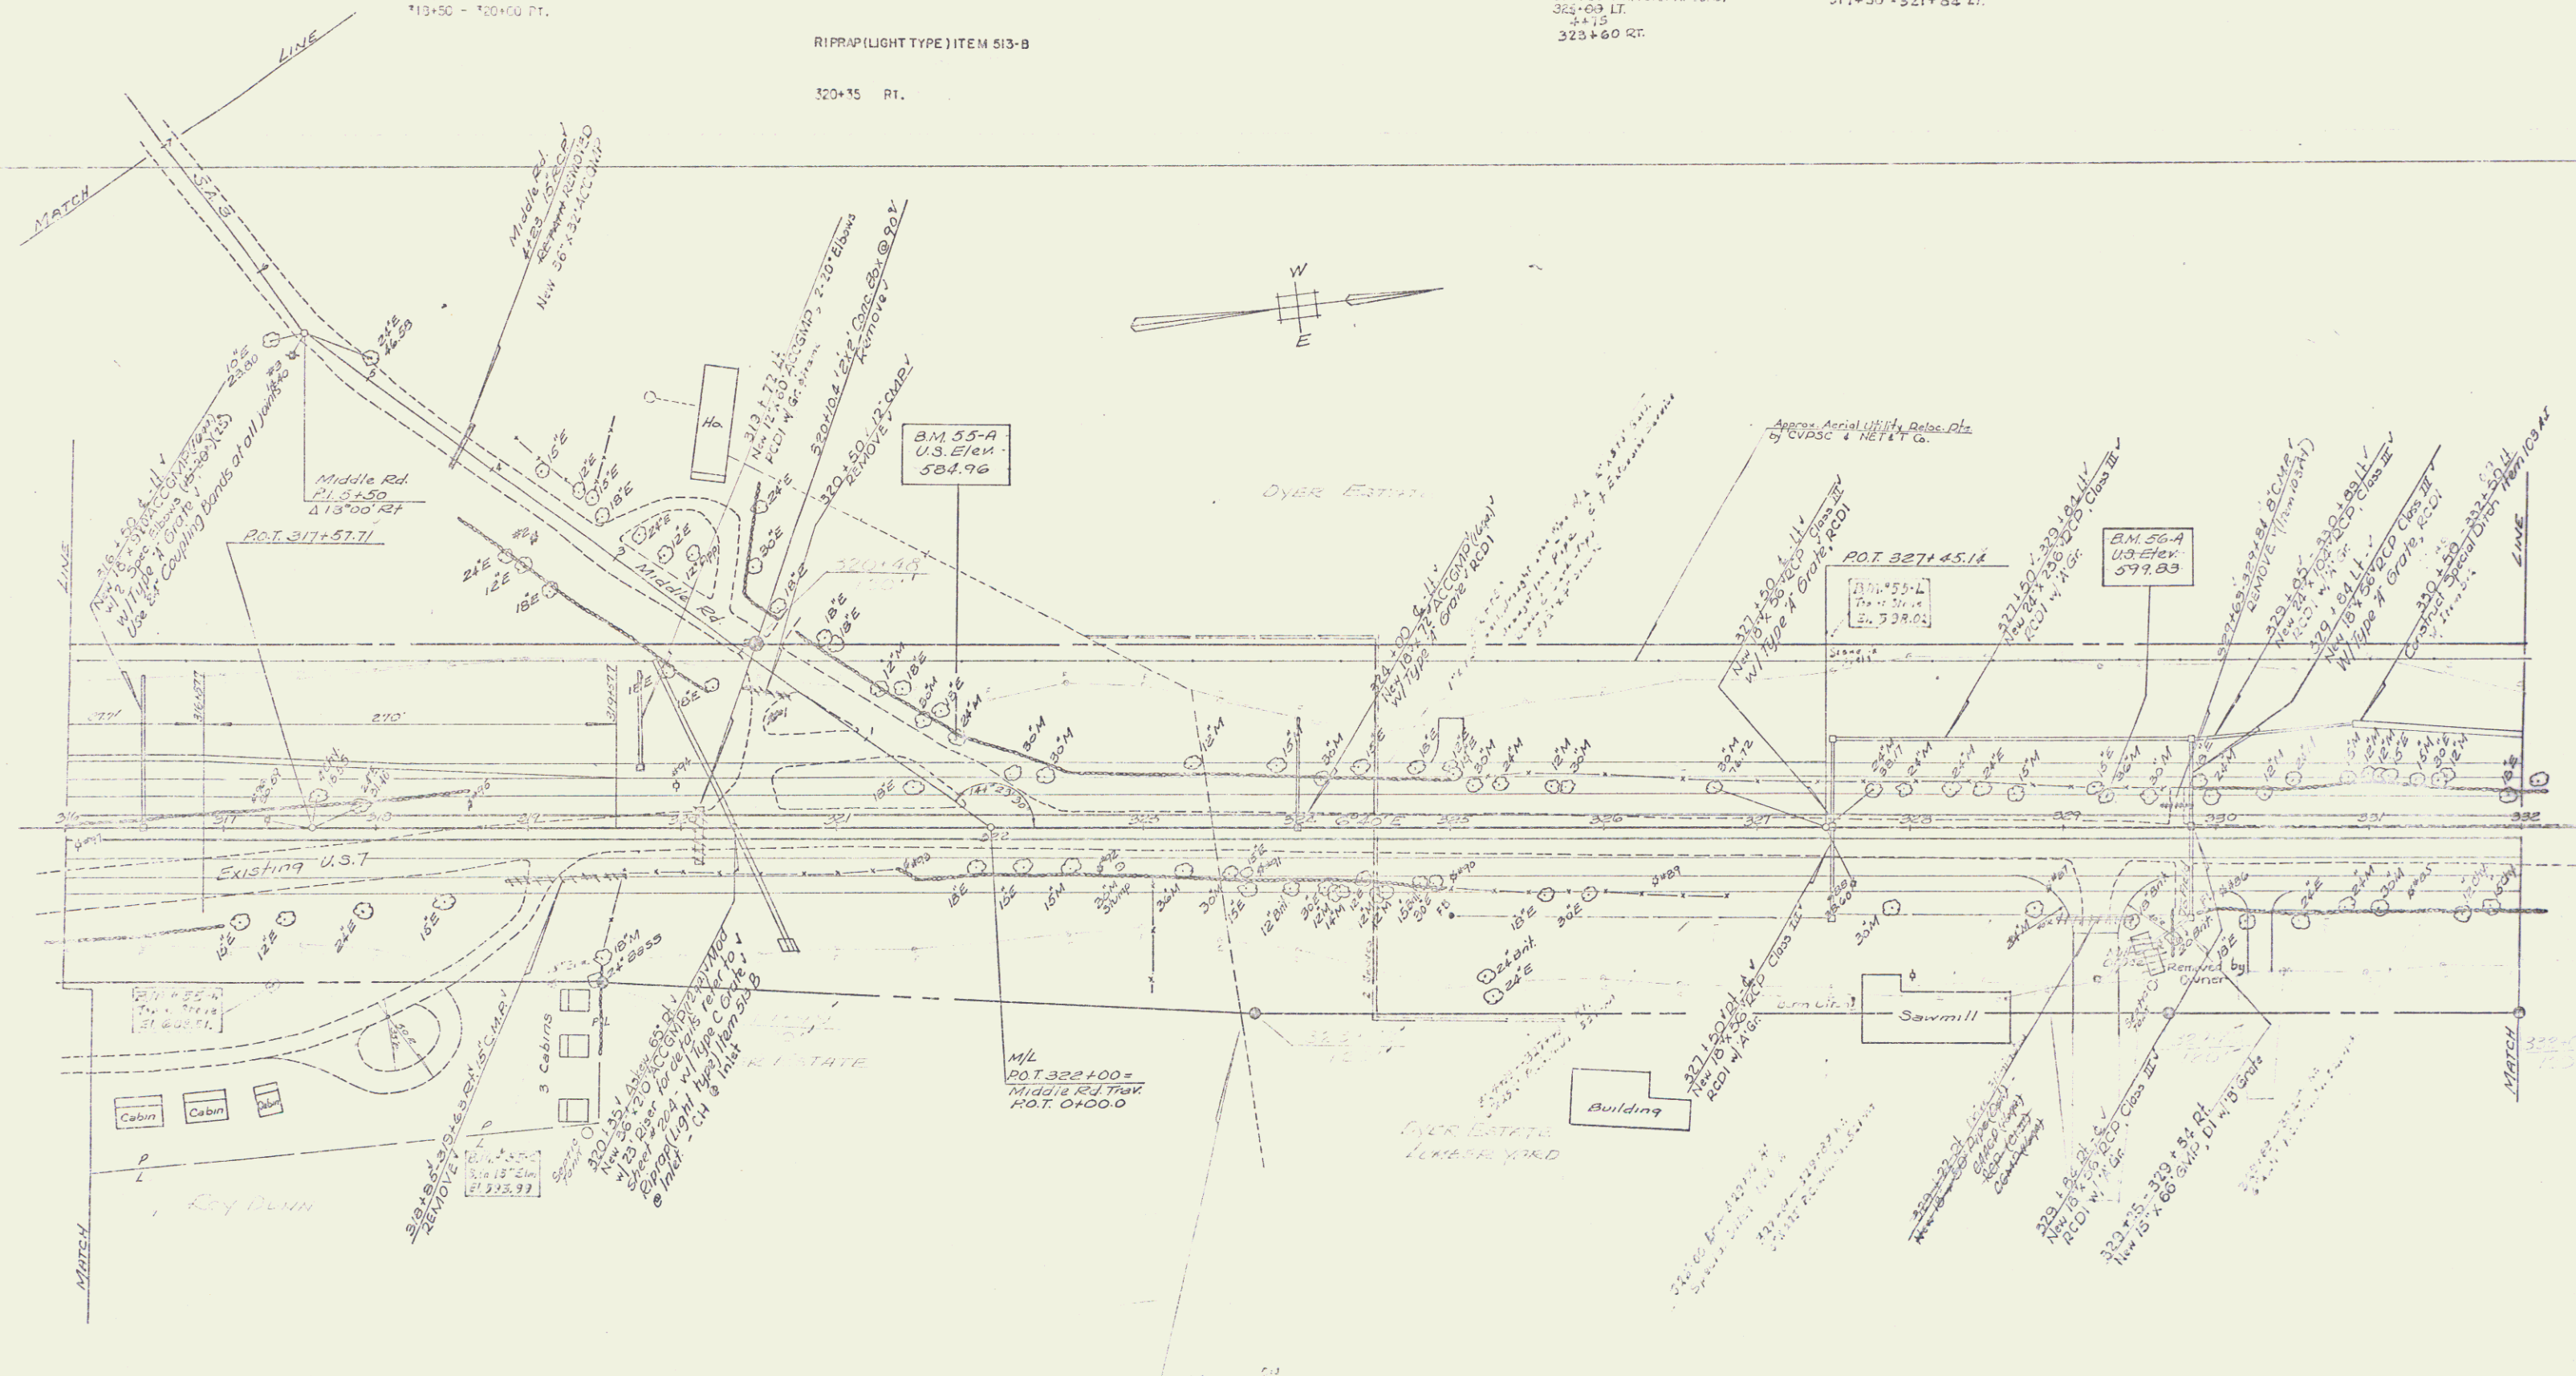

CLARENDON-RUTLAND
 AD 019-3(3)
 Sheet 02 of 210 Sheets