

CONSTRUCT DRIVES
 339+25 RT.
 340+00 LT.
 340+00 RT.
 346+77 LT. ✓

SEEDING ITEM 611
 FERTILIZER ITEM 615
 TOPSOIL ITEM 621
 332+00 - 342+50 ISLANDS
 339+30 - 340+00 RT.
 242+92 - 317+83 RT.
 343+50 - 345+65 LT.
 347+00 - 348+00 LT.

RIPRAP (LIGHT TYPE) ITEM 513-B
 341+06 RT.
 344+60 RT.

GRANITE SLOPE EDGING, ITEM 556-A
 342+00 - 342+52
 341+12 - 342+54 RT. (JUG HANDLE)
 341+52 - 342+63 LT. of Jug Handle

VERTICAL GRANITE CURB, ITEM 555-F
 343+50 - 345+54 LT.
 347+08 - 348+00 LT.
 342+92 - 347+83 RT.

THREE CABLE GUARD RAIL
 W/STEEL POSTS, ITEM 542
 345+99 - 346+23 LT.
 7+10 - 2+20

DRILLING & PLASTING OF SOLID ROCK
 SUBGRADE, ITEM 115.
 342+00 - 344+00



COLORLED SYNTHETIC BINDER CONCRETE
 ITEM 374
 342+70 - 348+00 ✓

REMOVAL OF CONCRETE PAVEMENT
 ITEM 103-B
 332+00 - 336+50
 346+00 - 348+00

INSTALL OVERHEAD TRAFFIC SIGN SUPPORT, ITEM 703
 STA 345+00
 FOR DETAILS REFER TO SHEETS NO. 66

STANDARD STEEL BEAM GUARD RAIL WITH STEEL POSTS, ITEM 545-A
 344+86 - 345+65 LT.
 344+35 - 345+14 RT.

PLAN	DATE	BY
CLARENDON-RUTLAND	10/1/83	W. J. ...
AD 019-3(3)		
SHEET 34		

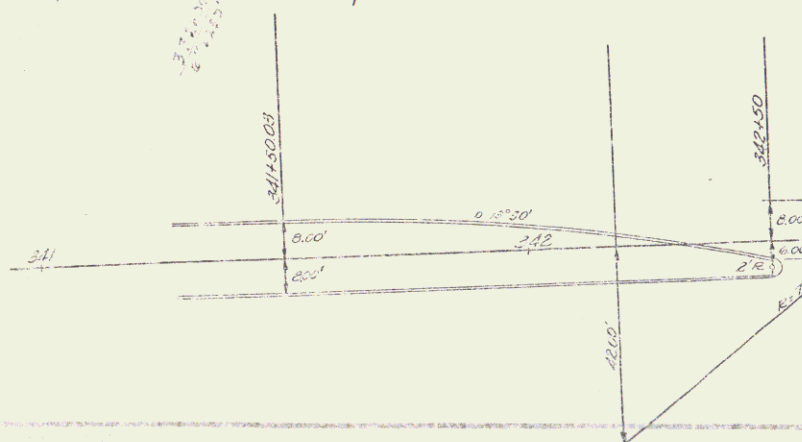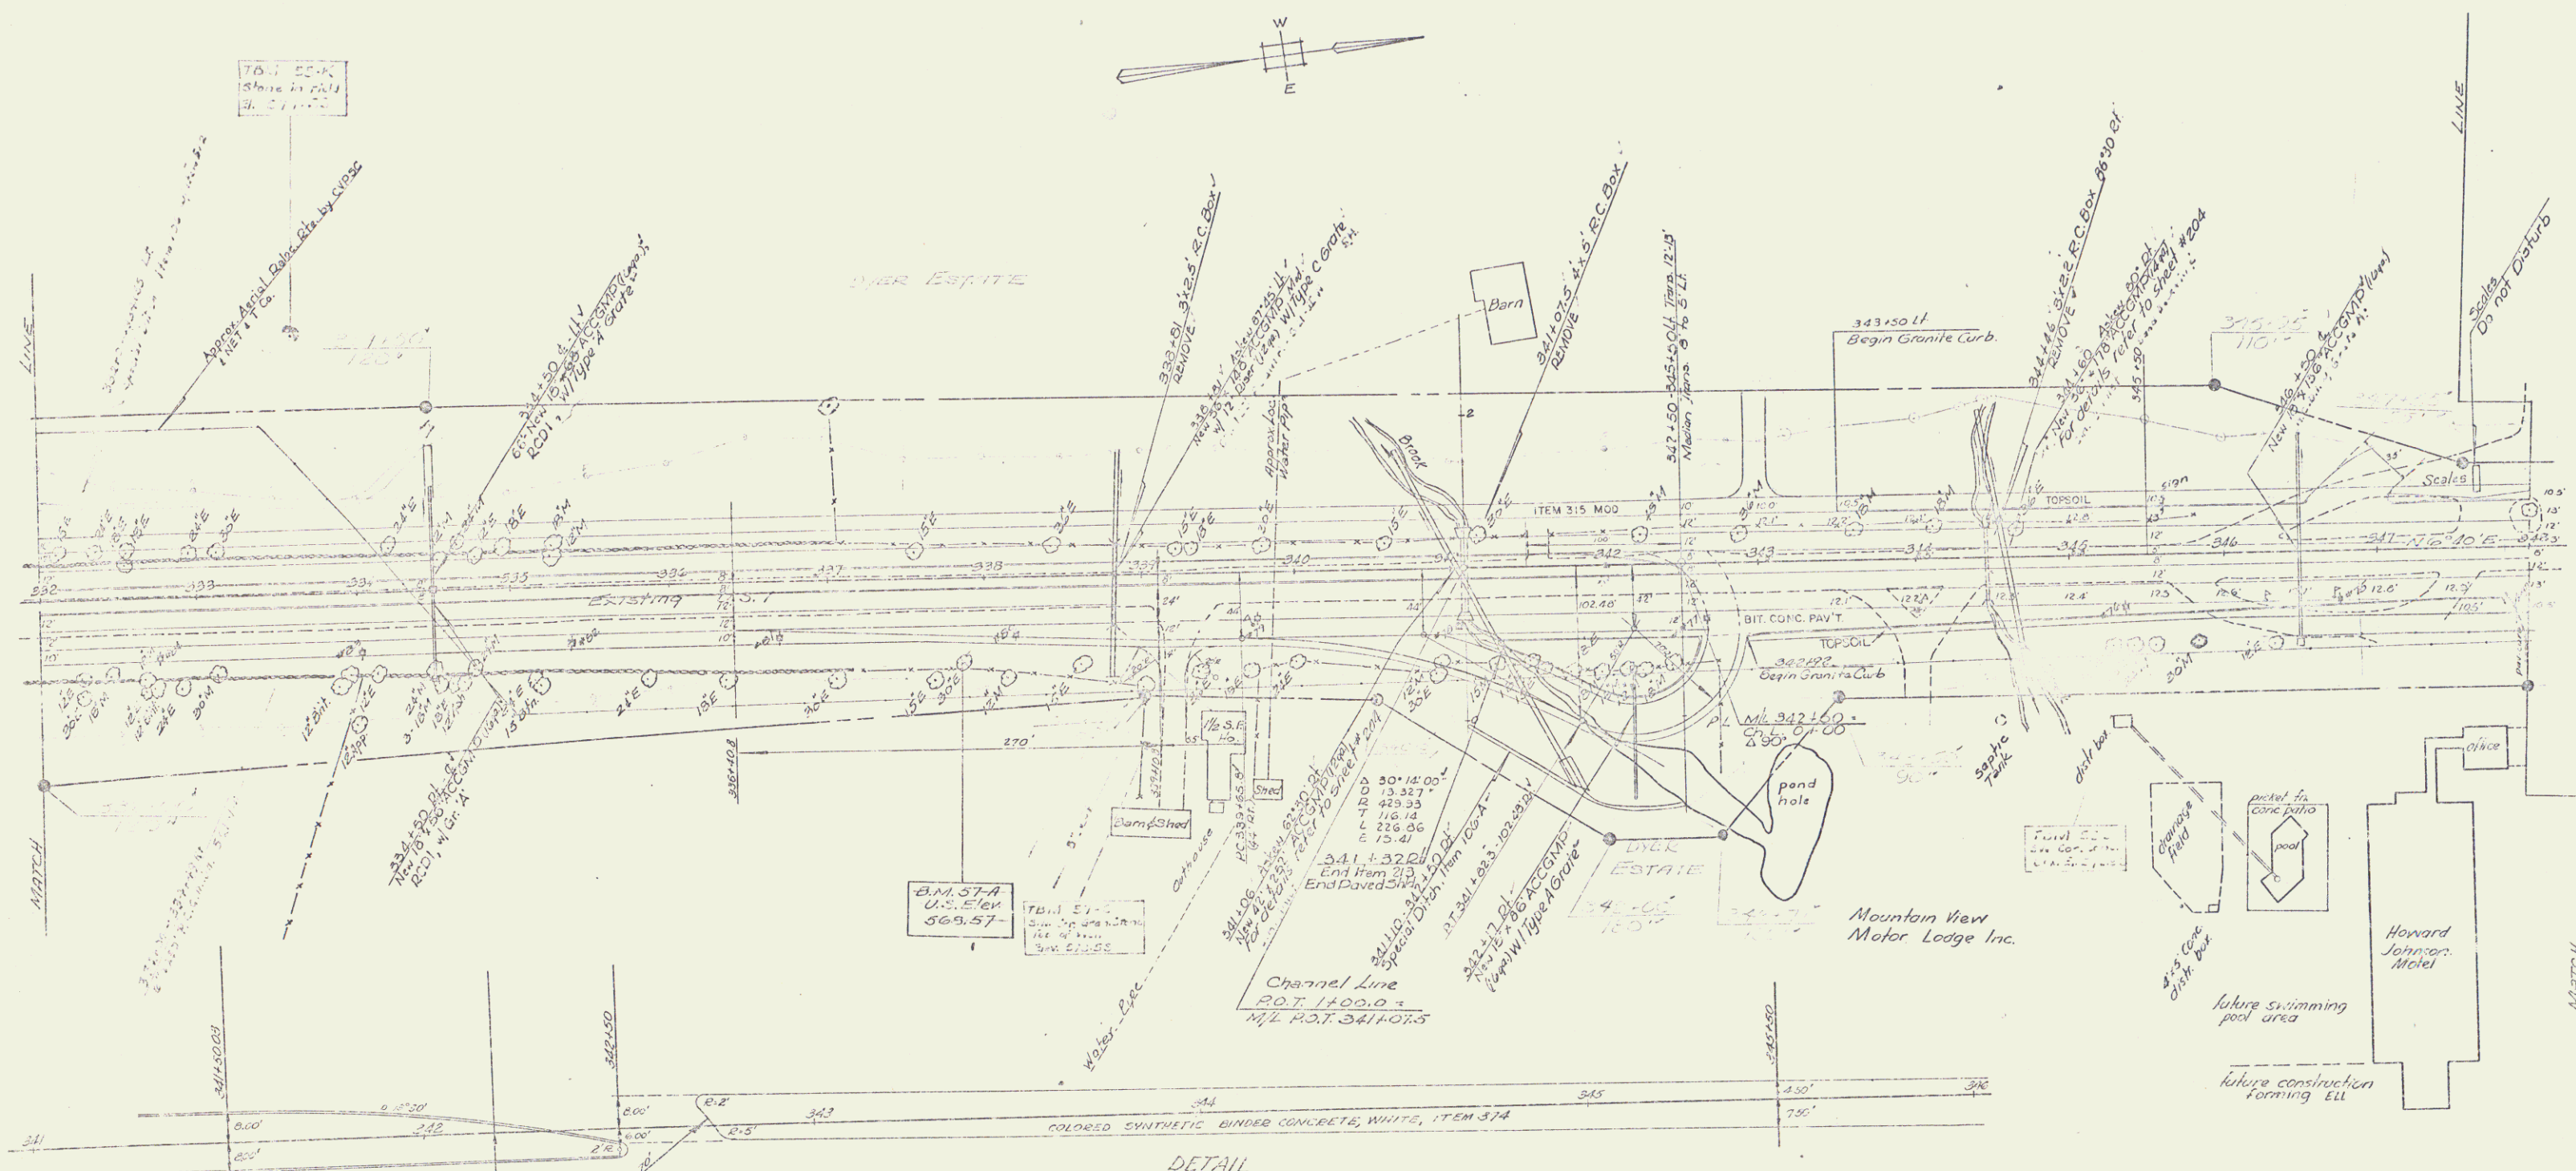

CLARENDON-RUTLAND
 AD 019-3(3)
 Sheet 34 of 28 Sheets