
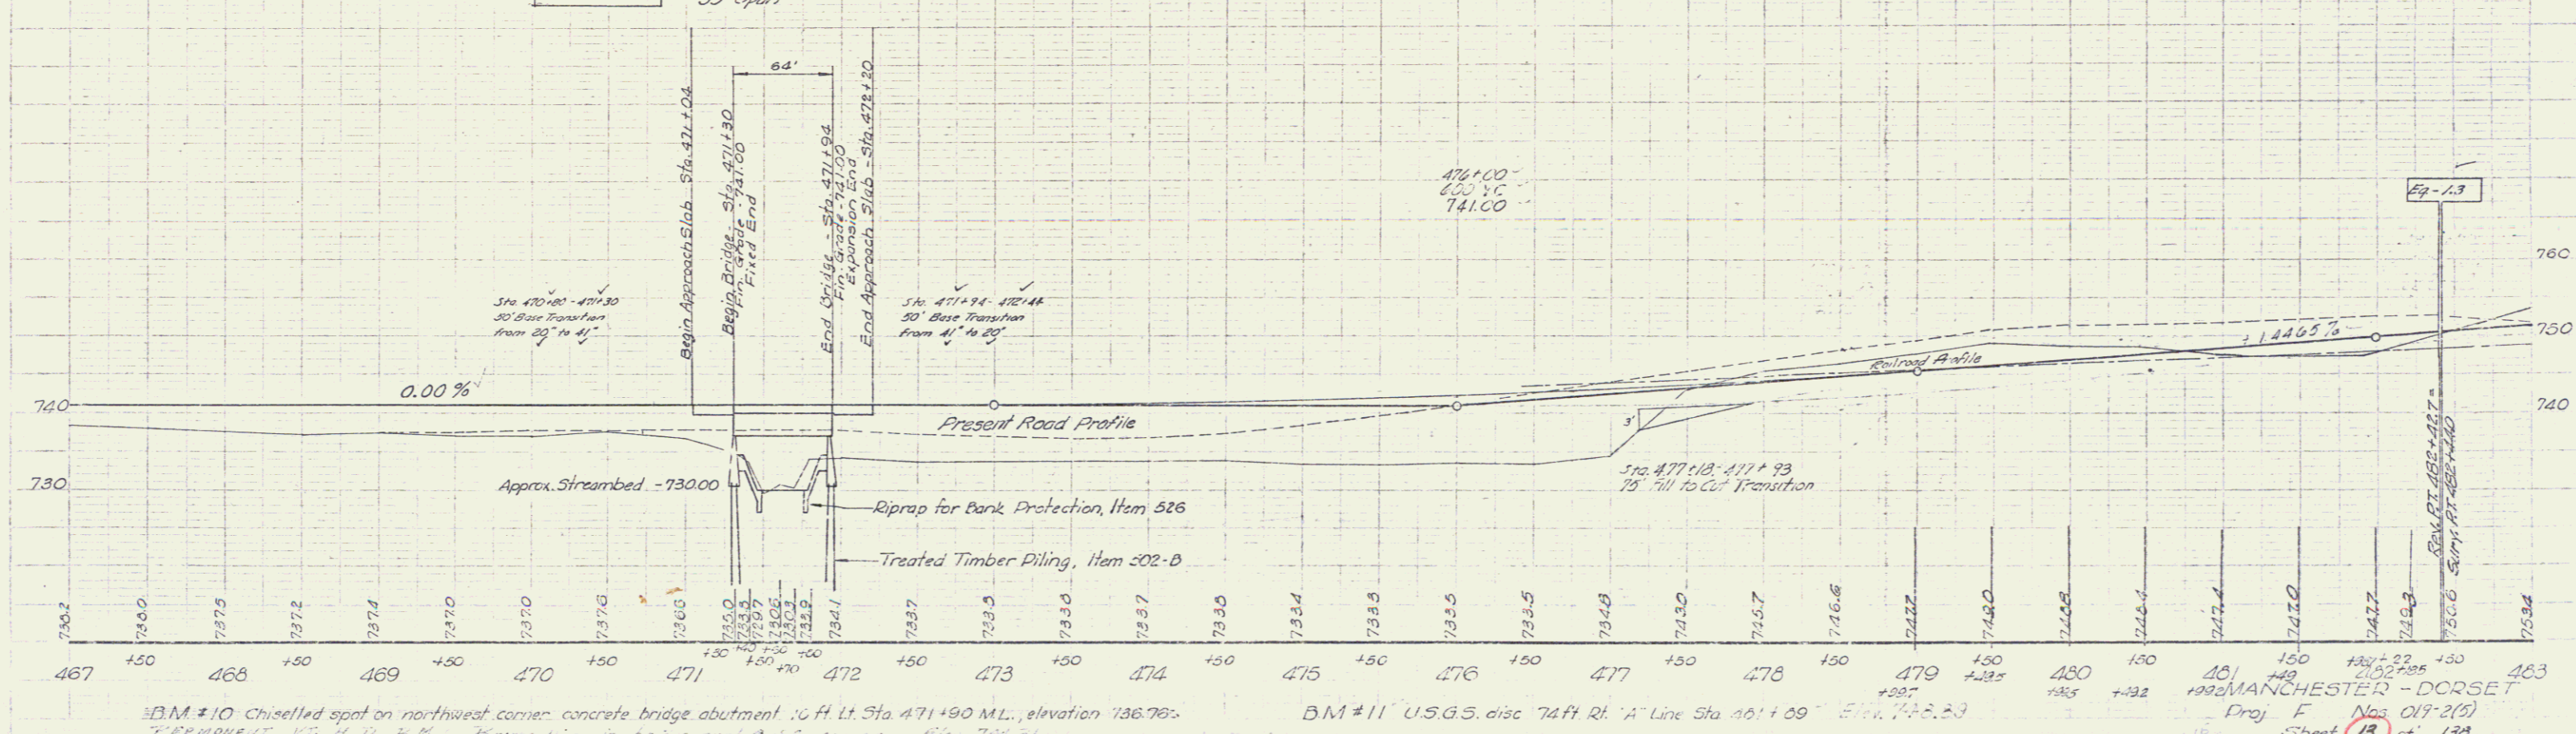


Excavation + Removal of Road Surface on Discontinued Roadway, Item 118 472+00 - 481+00 Lt.
 Demolition and Removal of Building 467+25 Lt.

Construct Approach 482+13.5 Lt.
 Construct Drives Lt. 468+50 - 467+50
 FRANK V. SR. & CLARA W. READ

Plank Guard Rail for Barricade 472+26 Lt. Item 541A
 Three Cable Guard Rail with Steel Posts Item 543 472+07 - 472+31 Lt.
 Rt. 470+83 - 471+17
 471+94 - 472+18

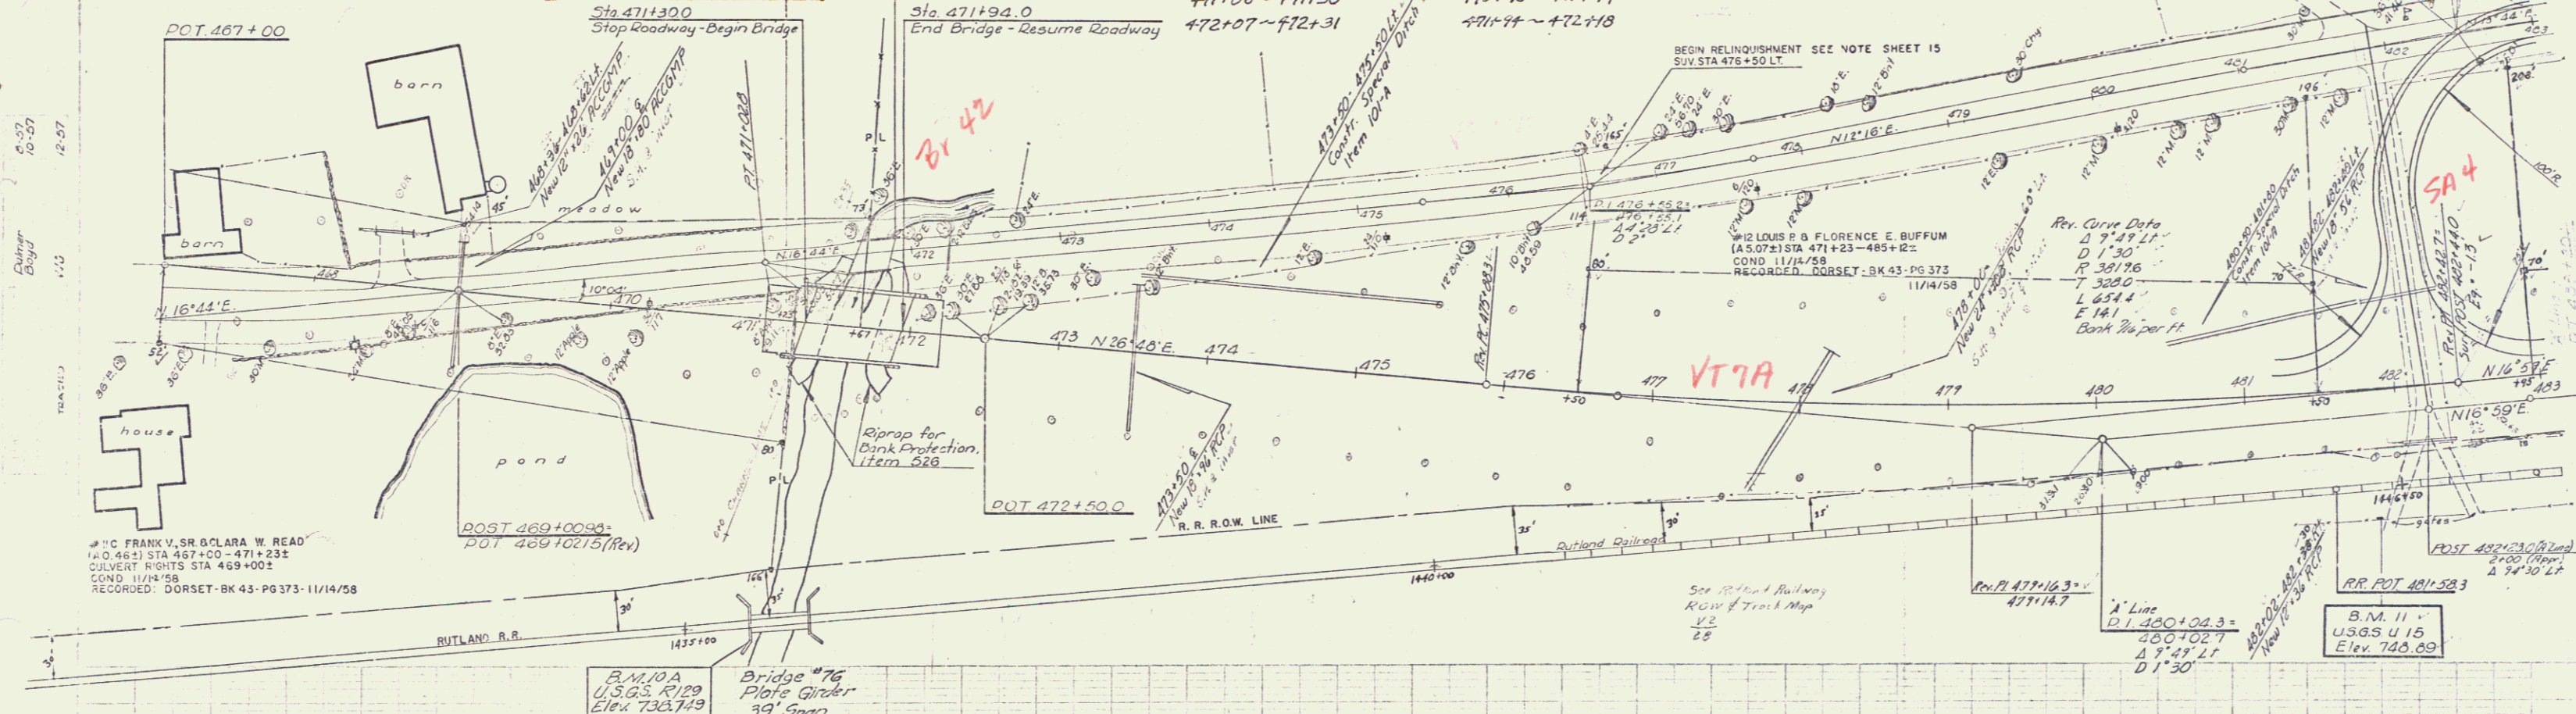

B.M. #10 Chiselled spot on northwest corner concrete bridge abutment. 10 ft. Lt. Sta. 471+90 M.L. elevation 736.76.
 B.M. #11 U.S.G.S. disc 74 ft. Rt. 'A' Line Sta. 481+09 Elevation 742.33
 Proj. F. No. 019-2(5)
 Sheet 13 of 130