

INDEX OF SHEETS

SHEET NO. 1 TITLE PAGE
2 TYPICAL CROSS-SECTION OF IMPROVED
PLAN AND PROFILE

SHEET	STATIONS	SHEET	STATIONS	SHEET	STATIONS
3	4-15	4	16-31	5	32-47
6	48-63	7	64-79	8	80-95
9	96-111	10	112-127	11	128-143
12	144-159	13	160-175	14	176-191
16	192-207	17	208-223	18	224-239
21	240-255	22	256-271	23	272-287
24	288-303	25	304-319	26	320-335
27	336-351	28	352-367	29	368-383
30	384-399	31	400-415	32	416-431
33	432-447	34	448-463	35	464-479
38	480-495	39	496-511	40	512-527
42	528-543	43	544-559	44	560-575
46	576-591	47	592-607	48	608-623
49	624-639	50	640-655	51	656-671
52	672-687	53	688-703	54	704-719

SHEET-STATION	SHEET-STATION	SHEET-STATION
30 357-00	31 427-00	32 497-00
33 457-00	34 527-00	35 597-00
38 627-00	39 697-00	40 767-00
42 837-00	43 907-00	44 977-00
46 1047-00	47 1117-00	48 1187-00

SHEET-STATION	SHEET-STATION	SHEET-STATION
30 357-00	31 427-00	32 497-00
33 457-00	34 527-00	35 597-00
38 627-00	39 697-00	40 767-00
42 837-00	43 907-00	44 977-00
46 1047-00	47 1117-00	48 1187-00

SECTION A
BENNINGTON COUNTY

SHEETS
1-26
27-39
63-98

SECTION B
RUTLAND COUNTY

SHEETS
1-2
27-49
60-62
99-133



STATE OF VERMONT
STATE HIGHWAY DEPARTMENT

PLAN AND PROFILE OF PROPOSED
STATE HIGHWAY

TOWNS OF DORSET-MT. TABOR-DANBY Pin# 992505

DORSET-WALLINGFORD ROAD
FROM MANCHESTER-DORSET LINE TO DANBY-WALLINGFORD LINE

SCALES
PLAN 1" = 100'
PROFILE 1" = 10'
CROSS-SECTIONS 1" = 5'

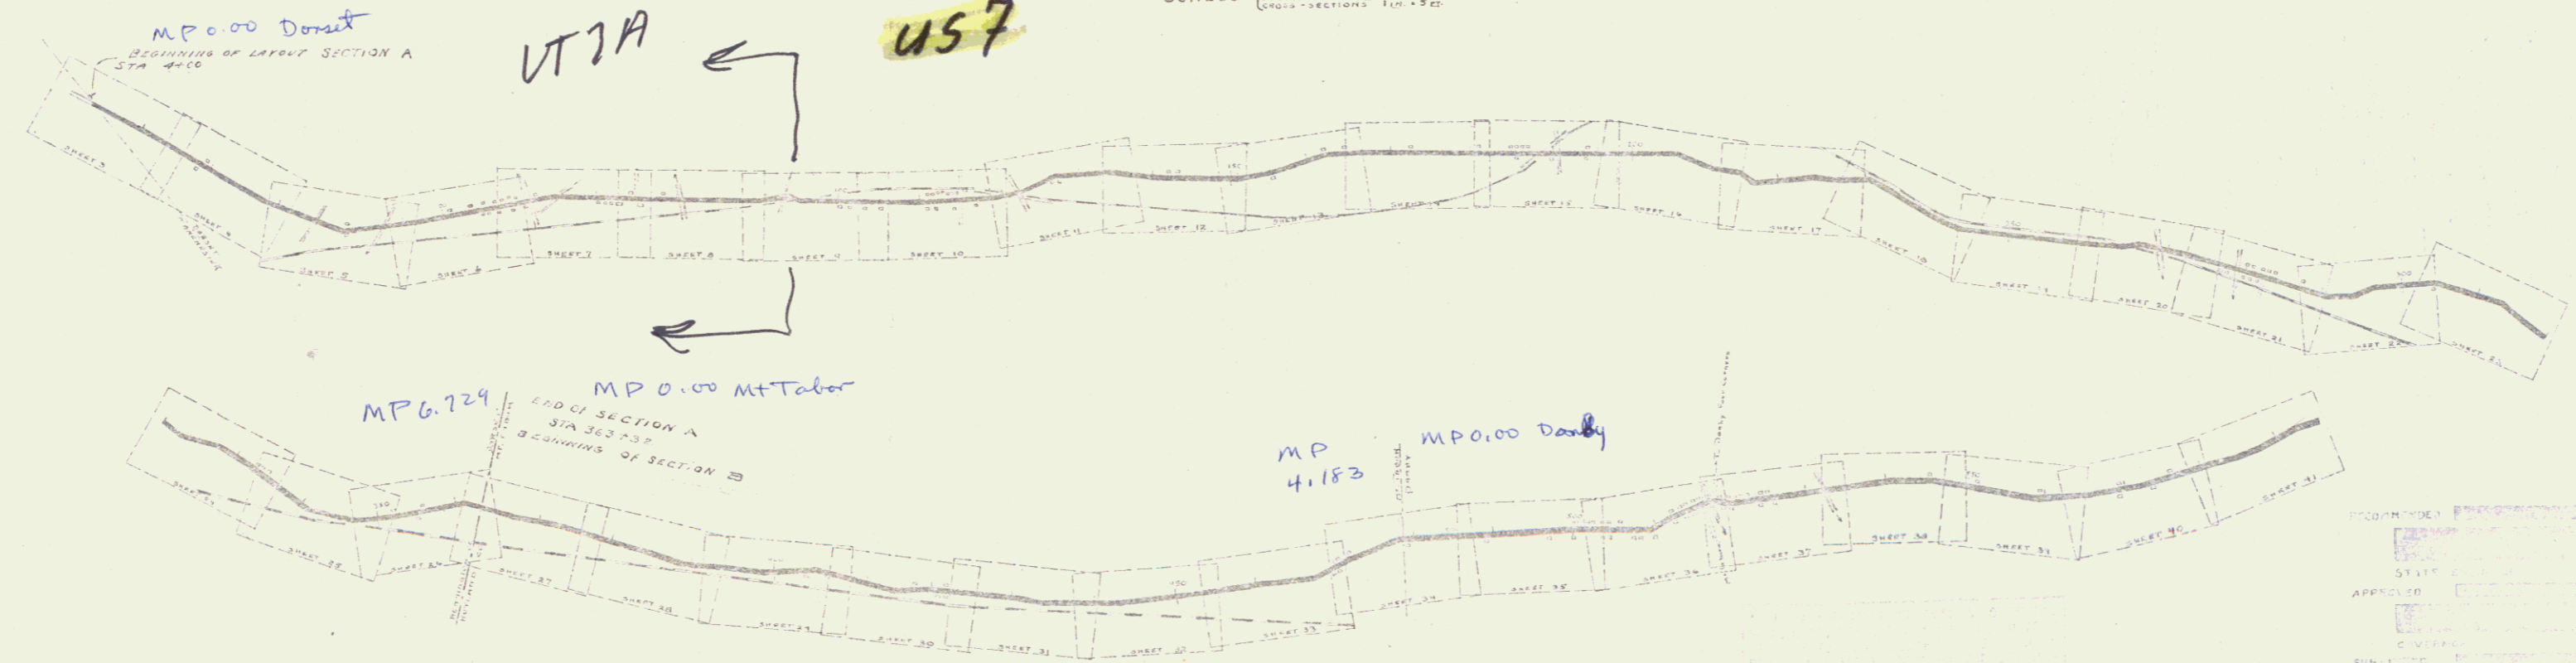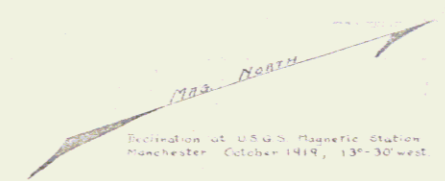

CONVENTIONAL SIGNS

COUNTY LINE	---	GROUND ELEVATION	RAISED	GRADE
TOWN LINE	---	GRADE ELEVATION	RAISED	GRADE
SECE LINE	---			
STONE WALL	---			
INTENDED PROPERTY	---			
QUAD MAIL	---			
TRAVELLED WAY	---			
RAILROAD	---			
ATTENDING WALL	---			
3/4" OR SURVEY LINE	---			
CULVERT	---			
DITCH	---			
DRIVEWAY	---			
TRUCK STOP	---			
TELEPHONE POLE	---			
WIRE	---			
BRIDGE	---			

CURVE DATA	DEFLECTION ANGLE	Δ
	DEGREE OF CURVE	D
	RADIUS OF CURVE	R
	TANGENT DISTANCE	T
	LENGTH OF CURVE	L
	EXTERNAL DISTANCE	E
	POINT OF INTERSECTION P.I.	P.I.
	POINT OF CURVE	P.C.
	POINT OF TANGENT	P.T.



RECORD PLANS

APPROVED

RECORDED

INDEXED

FILED

STATE HIGHWAY DEPARTMENT

RIGHT-OF-WAY DIVISION
TOWN FILE
PERPETUAL
Form of US 7
(To Be Returned To R.O.W. Division)

1/1/20 Project No. F 12

DIST. # 1 PLANS