



FEDERAL DIST. NO.	STATE	FED. RD. DIST. NO.	PROJECT NO.	SHEET NO.	TOTAL SHEETS
9	VT	12	100-10	3	133

GUARD RAIL REQUIRED
 19+00 ON LEFT
 Sta 19+00 to Sta 19+02 Length 24ft
 " 25+03 " 26+12 " 24ft
 19+00 ON RIGHT
 " 19+00 to Sta 19+02 " 24ft
 " 25+03 " 26+12 " 24ft
 " 29+00 " 30+24 " 224ft 371
 TOTAL THIS SHEET 556

NEW CULVERTS REQUIRED
 19+25 14' 30
 Sta 19+25 16" Cor Iron Pipe 28ft
 Concrete Headwalls 1-2-4 10cuyds.
 " 26+00 16" Cor Iron Pipe 28ft
 Concrete Headwalls 1-2-4 10cuyds.

UL Davis ENDRY 1914

1914
 1914
 1914
 1914

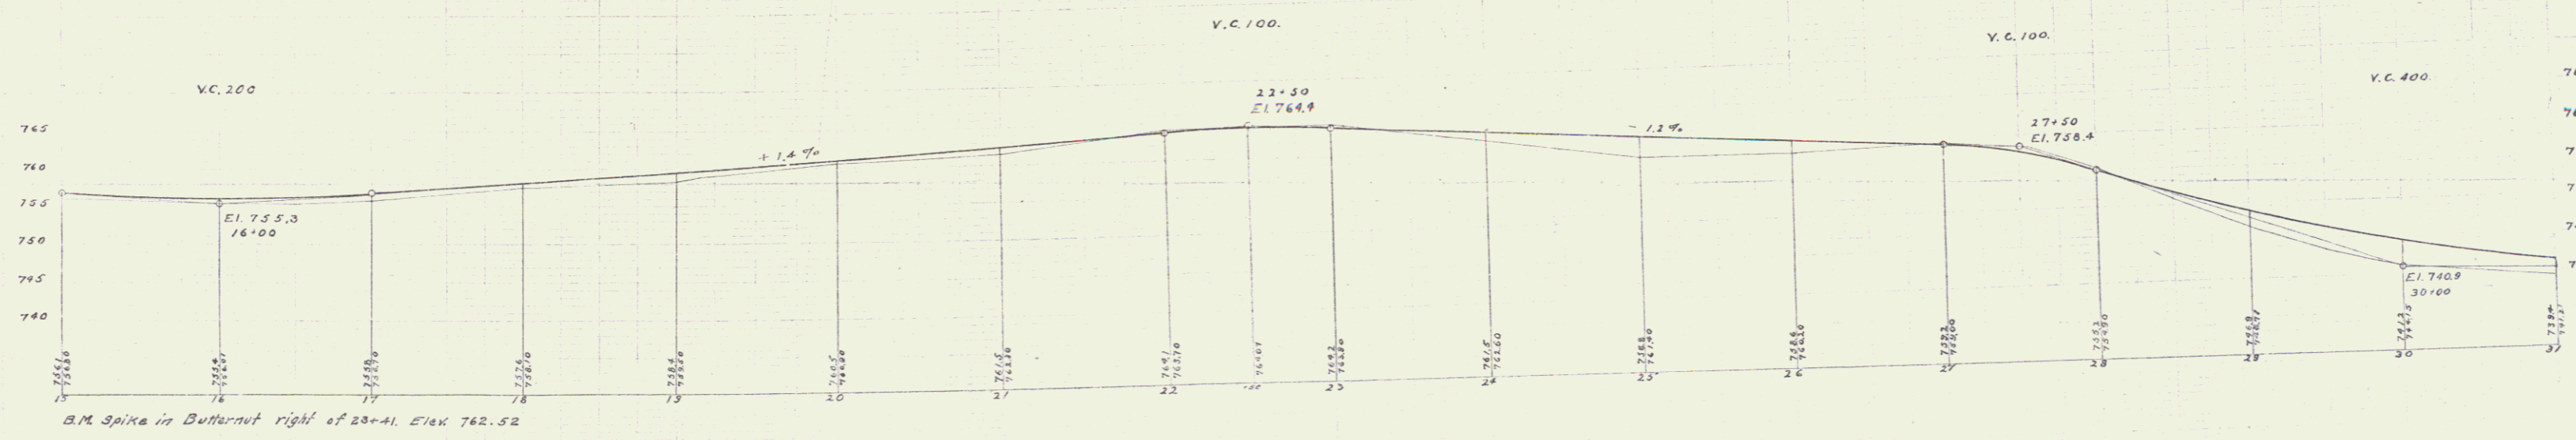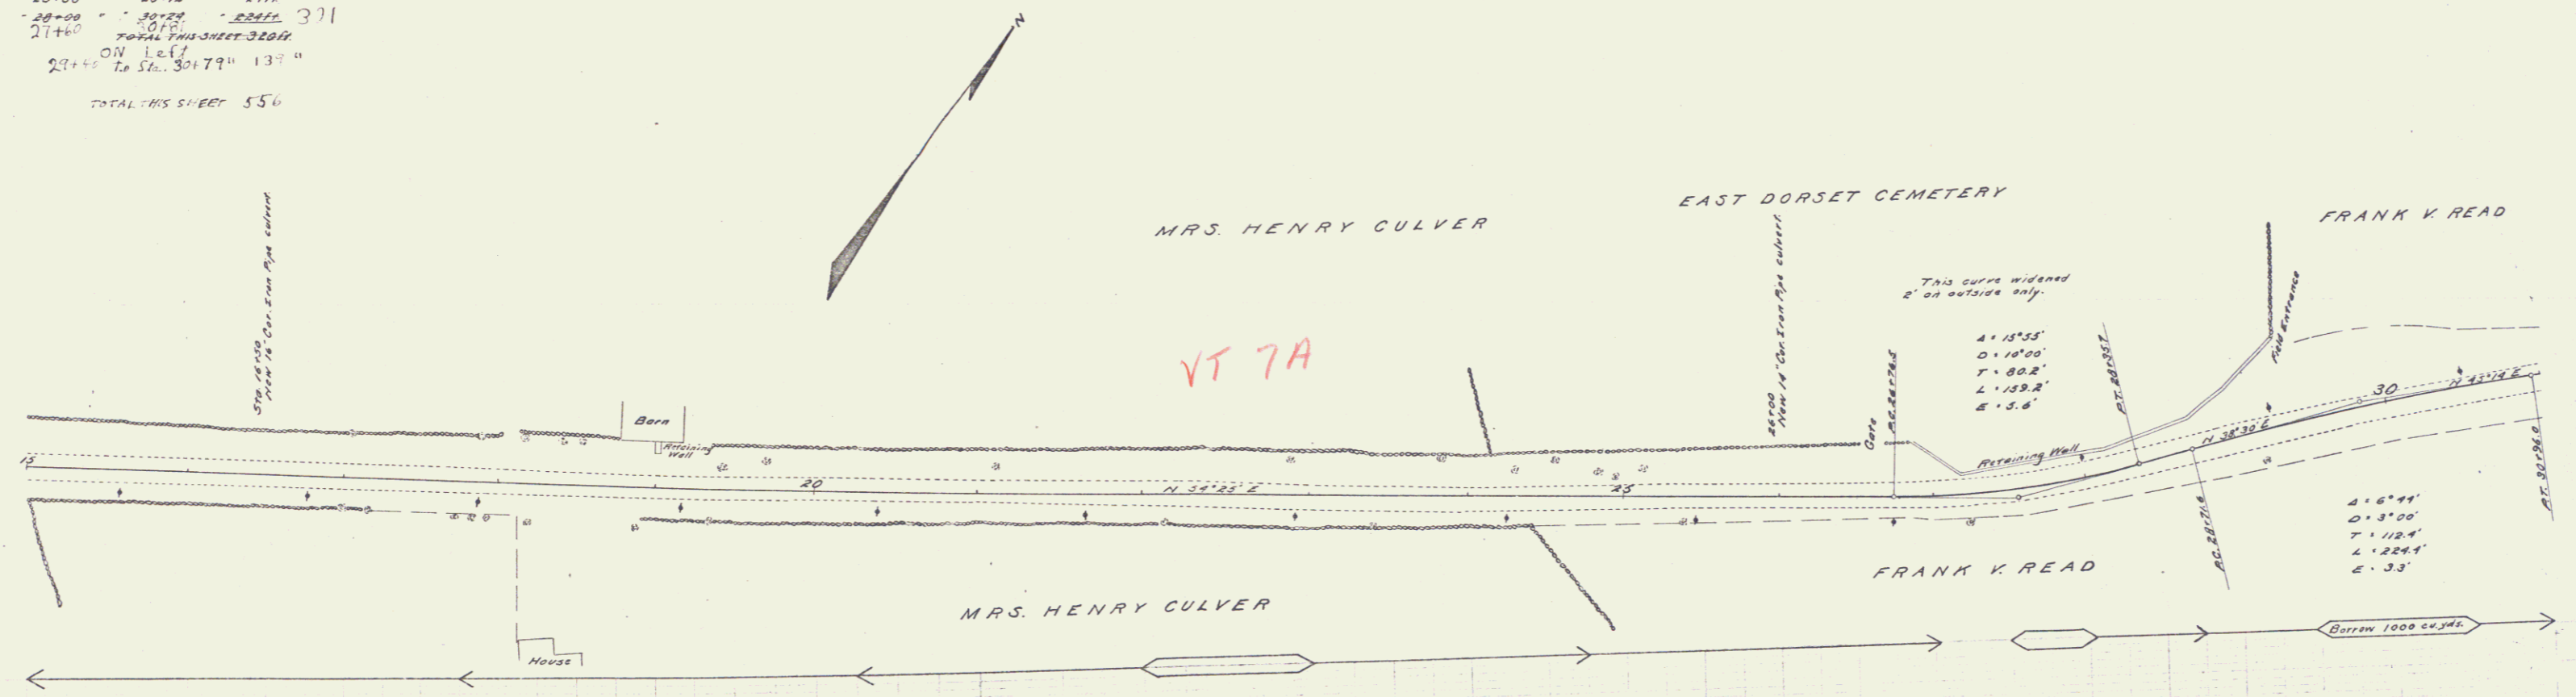

Drawn by [Signature] 1914