



GUARD RAIL REQUIRED
 ON RIGHT
 STA 80+00 TO 81+20 = 49% 20ft
 ON LEFT
 STA 80+00 TO 81+20 = 20"
 TOTAL THIS SIDE 40ft.

FIG. NO.	STATE	ED. NO.	ED. YEAR	SHEET NO.	TOTAL SHEETS
3	VT	12	1918-21	0	133

M.L. C. 100
 M.L. 100
 M.L. 100

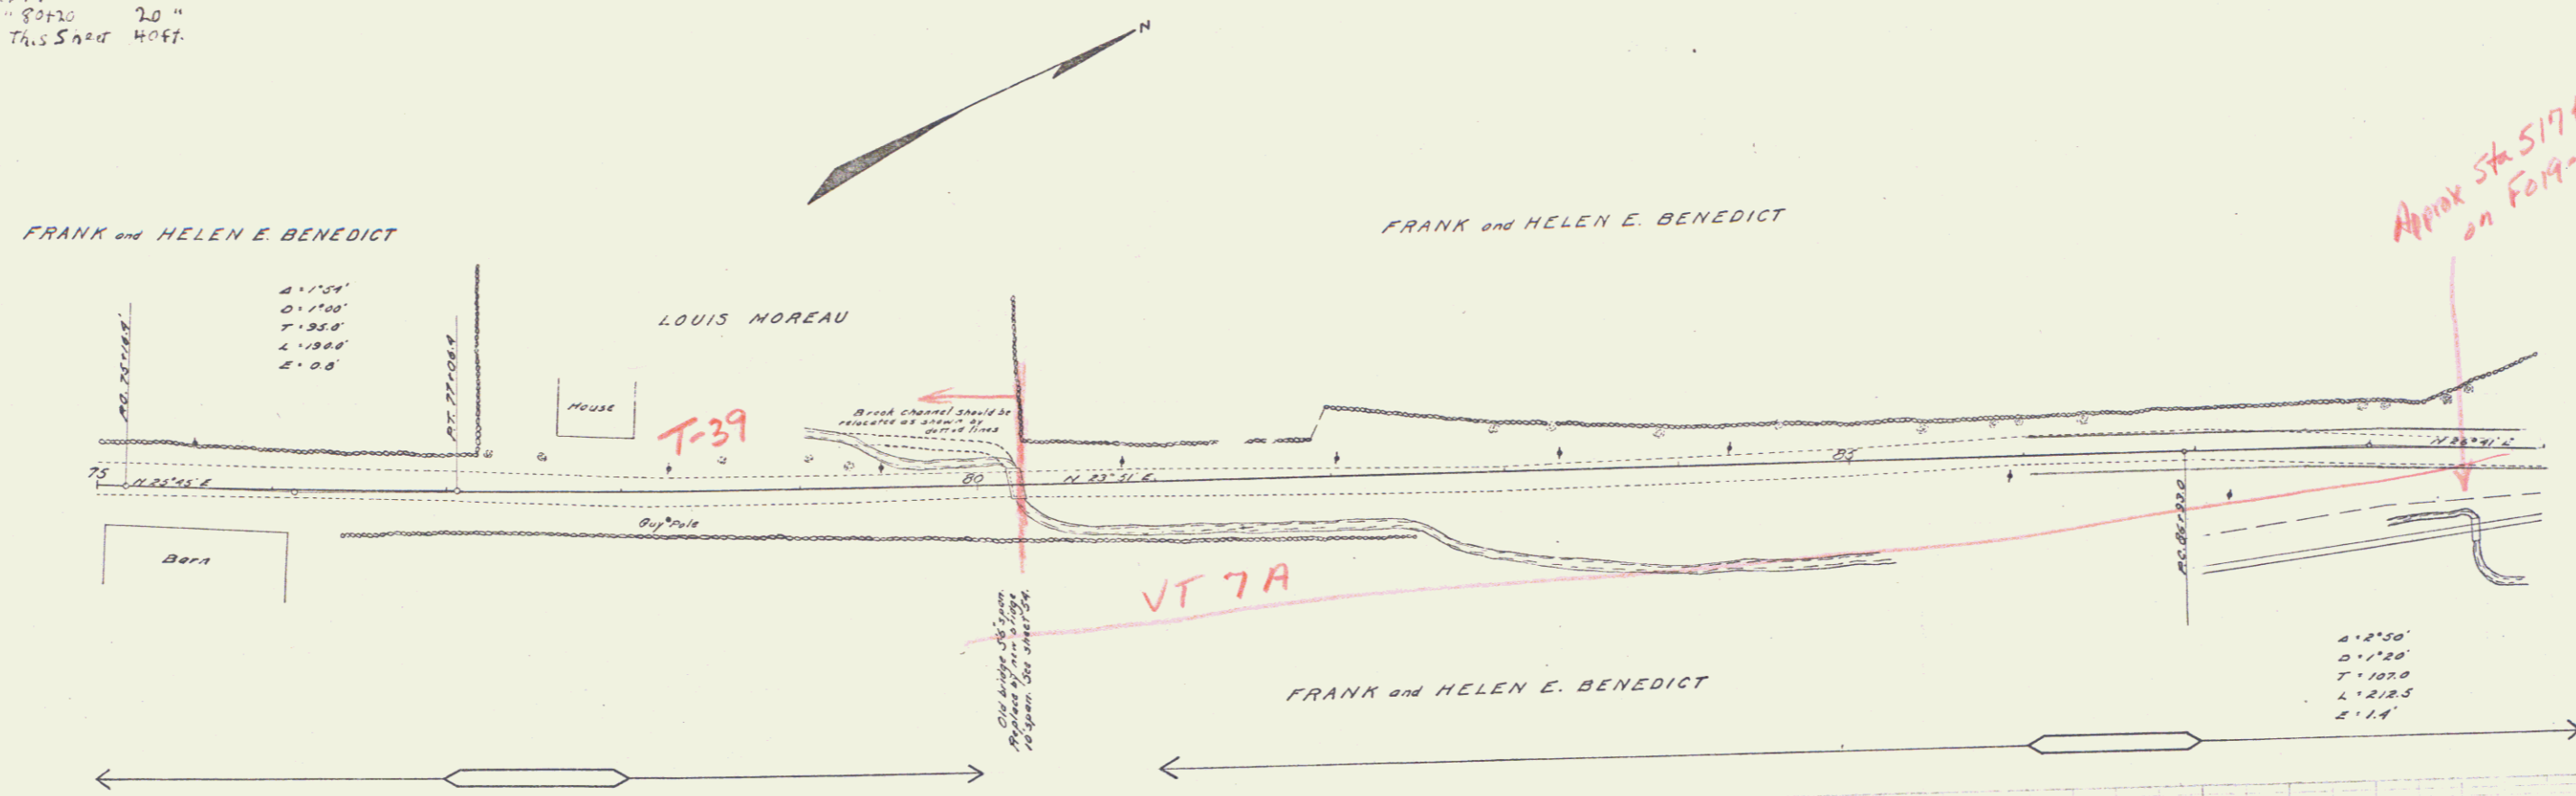

M.L. C. 100
 M.L. 100
 M.L. 100

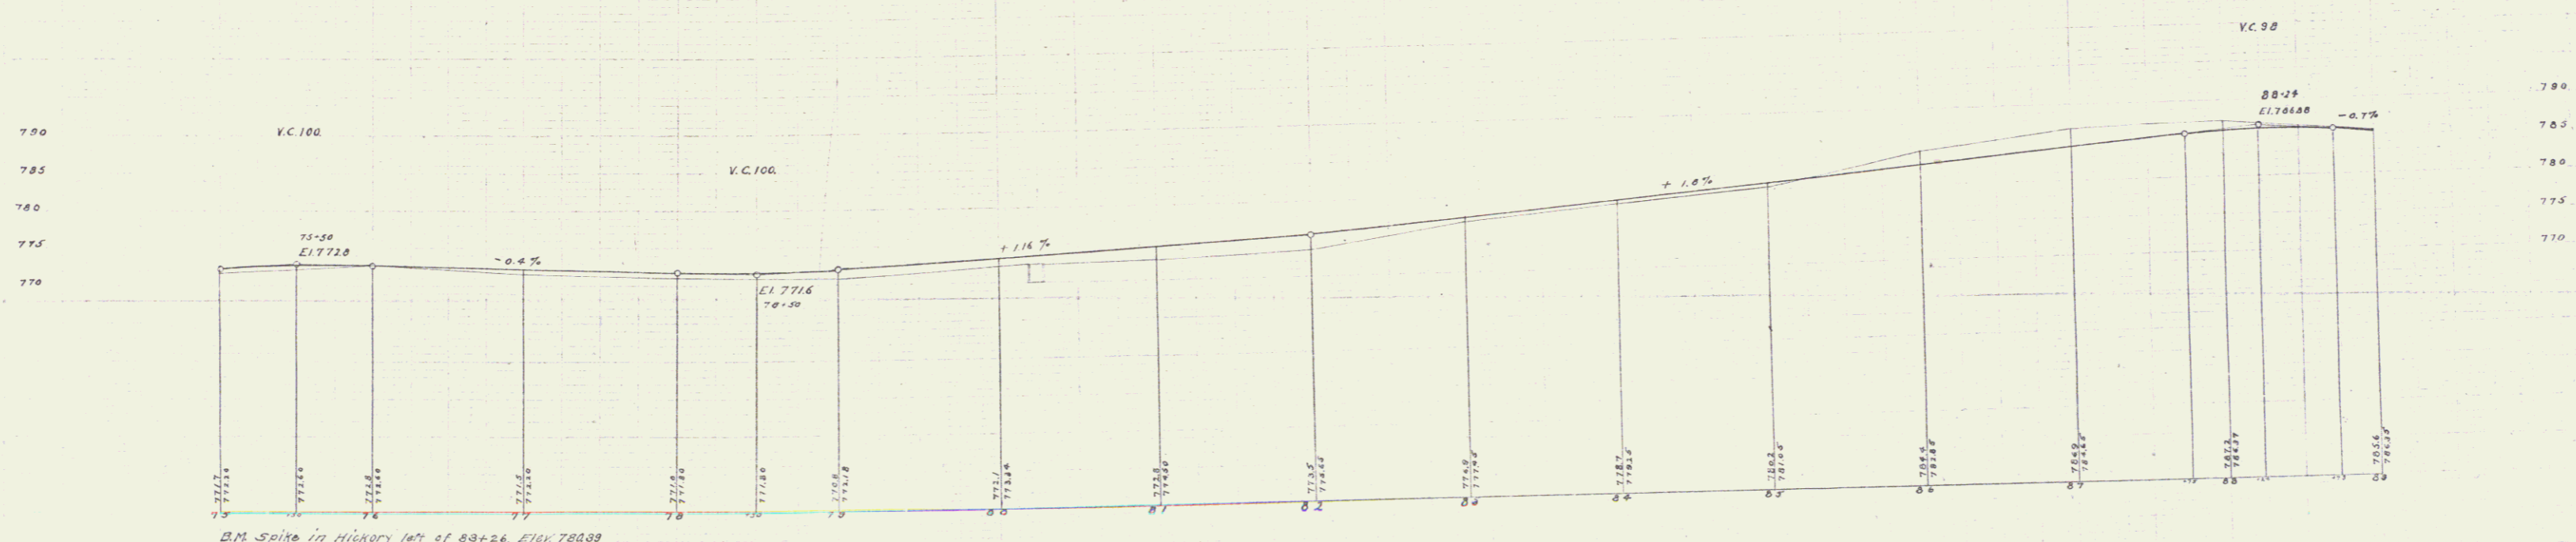

Series F. 100
 Sheet 3 of 133