
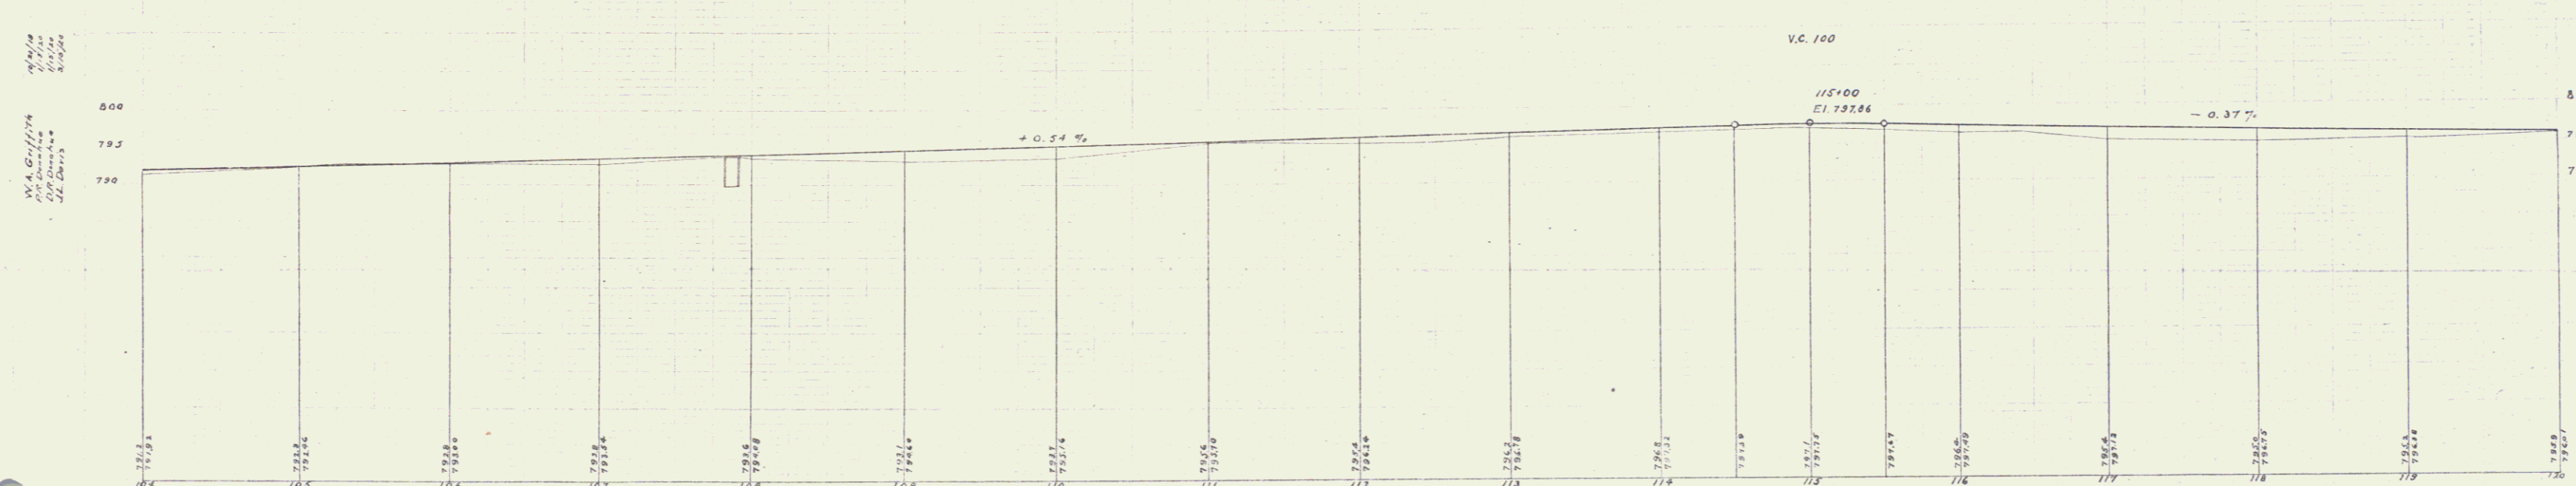


LEACHING BASINS REQUIRED
1 on left of Sta 118+23.8

GUARD RAIL REQUIRED
ON LEFT
ON RIGHT
Total This Sheet 64

REQUIRED Wings ON
Old Bridge at Sta. 107+80
1-3-6 Concrete 3-9 Du Yds

PER. NO.	STATION	FO. AND P. DIST.	SHEET NO.	TOTAL SHEETS
9	12	10	10	133

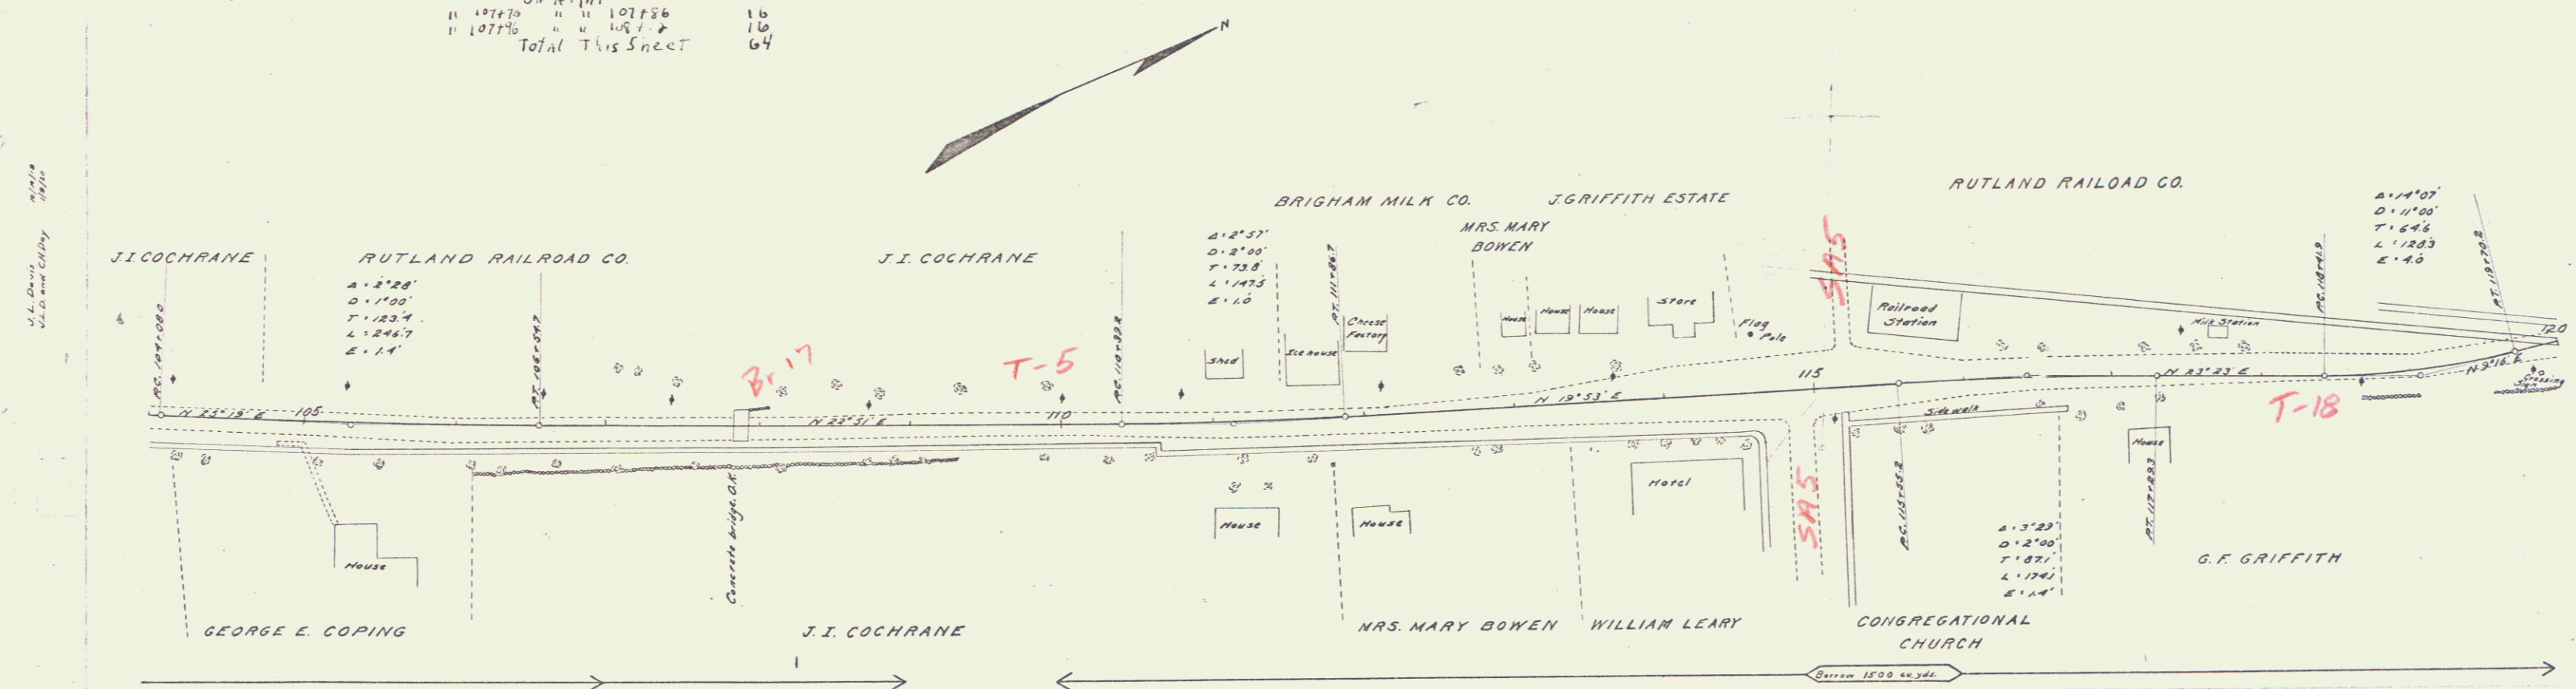

B.M. Corner of Wheel Guard at S. End of Concrete bridge Right of 107+83. Elev. 794.09
B.M. N.E. Corner of Marble Box, 1-9 wide, of Water trough left of 114+93 Elev. 798.29