

GUARD RAIL REQUIRED



ON LEFT

Sta 187+00 to Sta 188+00	Length 20 ft	
- 187+00	- 187+00	- 187+00
- 187+25	- 187+25	- 187+25
- 187+50	- 187+50	- 187+50
- 187+75	- 187+75	- 187+75
- 188+00	- 188+00	- 188+00
TOTAL THIS SHEET 575		

NEW CULVERTS REQUIRED

Sta 185+00 14" Cor Iron Pipe 26 ft
 12" Concrete Headwalls 2 cays

PG. NO.	STATE	FISCAL YEAR	SHEET NO.	TOTAL SHEETS
9	VT	12 1894-95	15	133

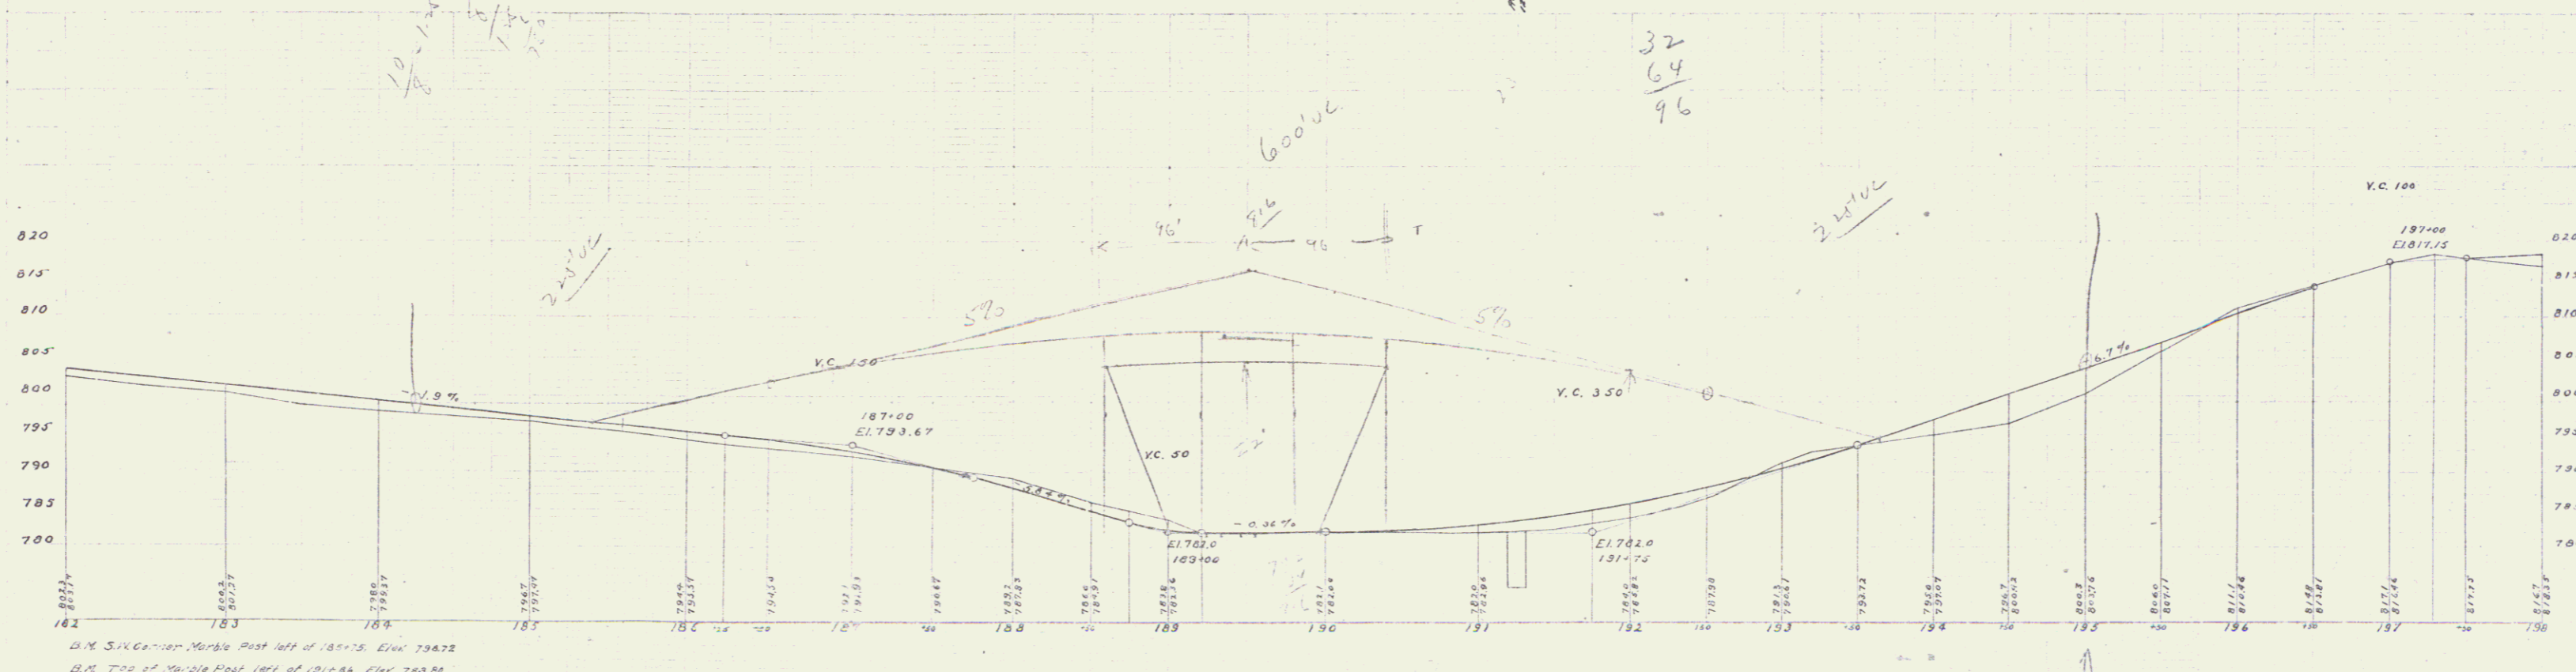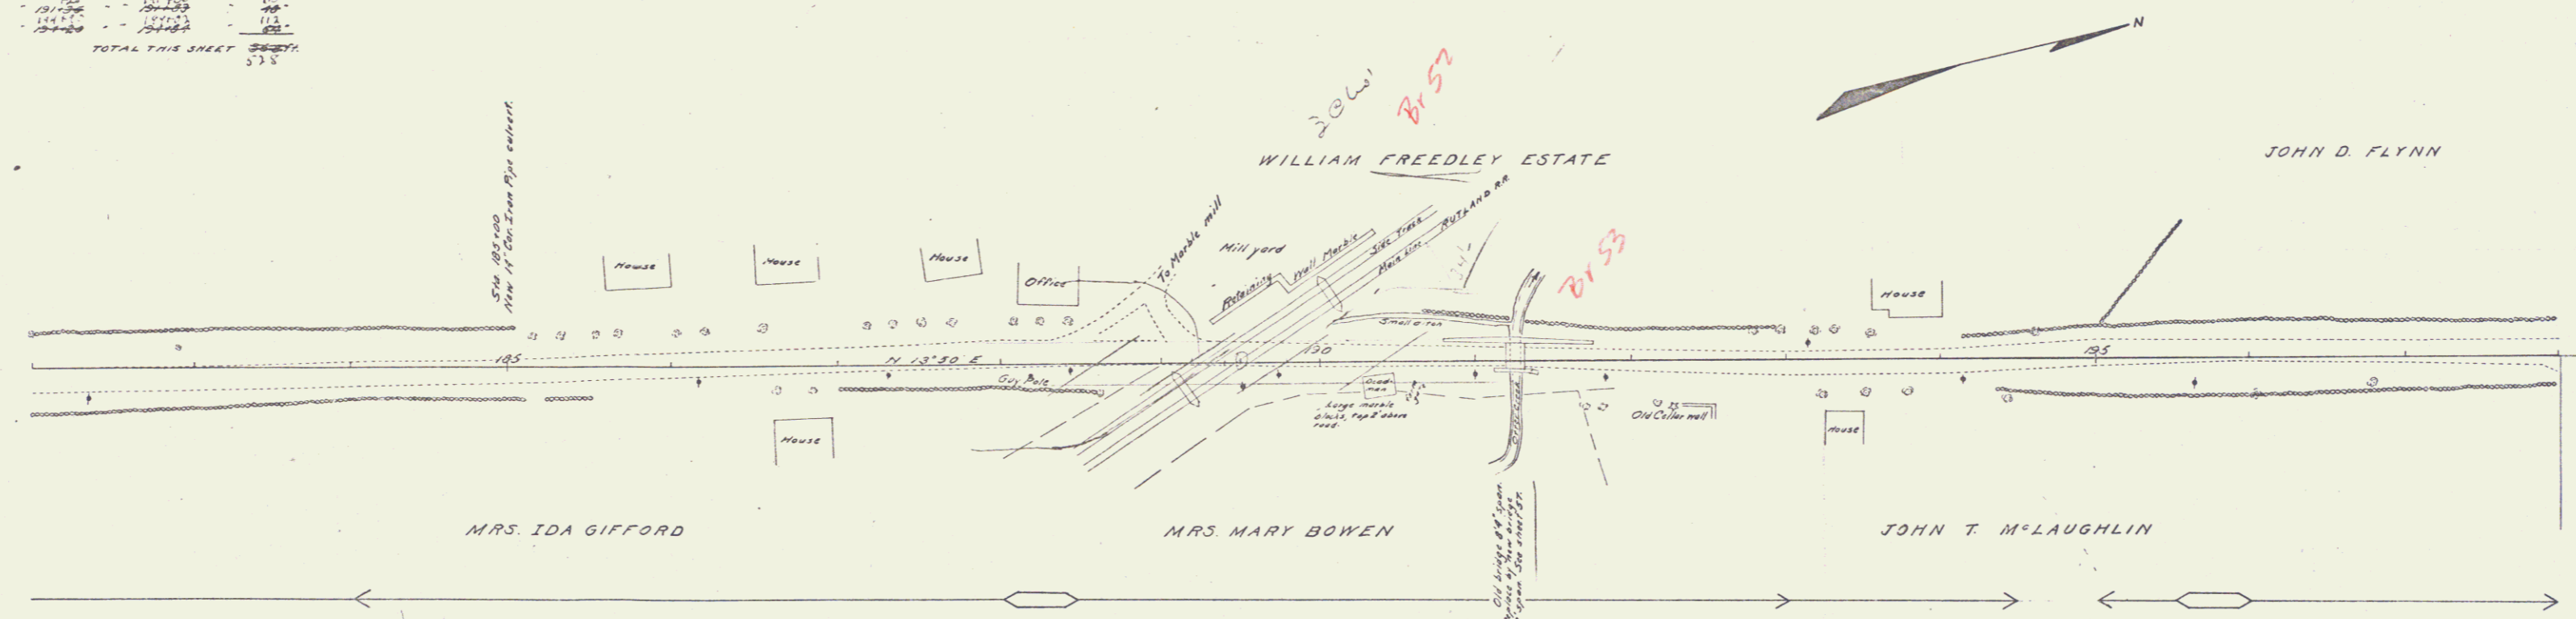

D.M. Six Corner Marble Post left of 187+75. Elev 796.72
 D.M. Top of Marble Post left of 187+66. Elev 788.86

Series 100-100-100