
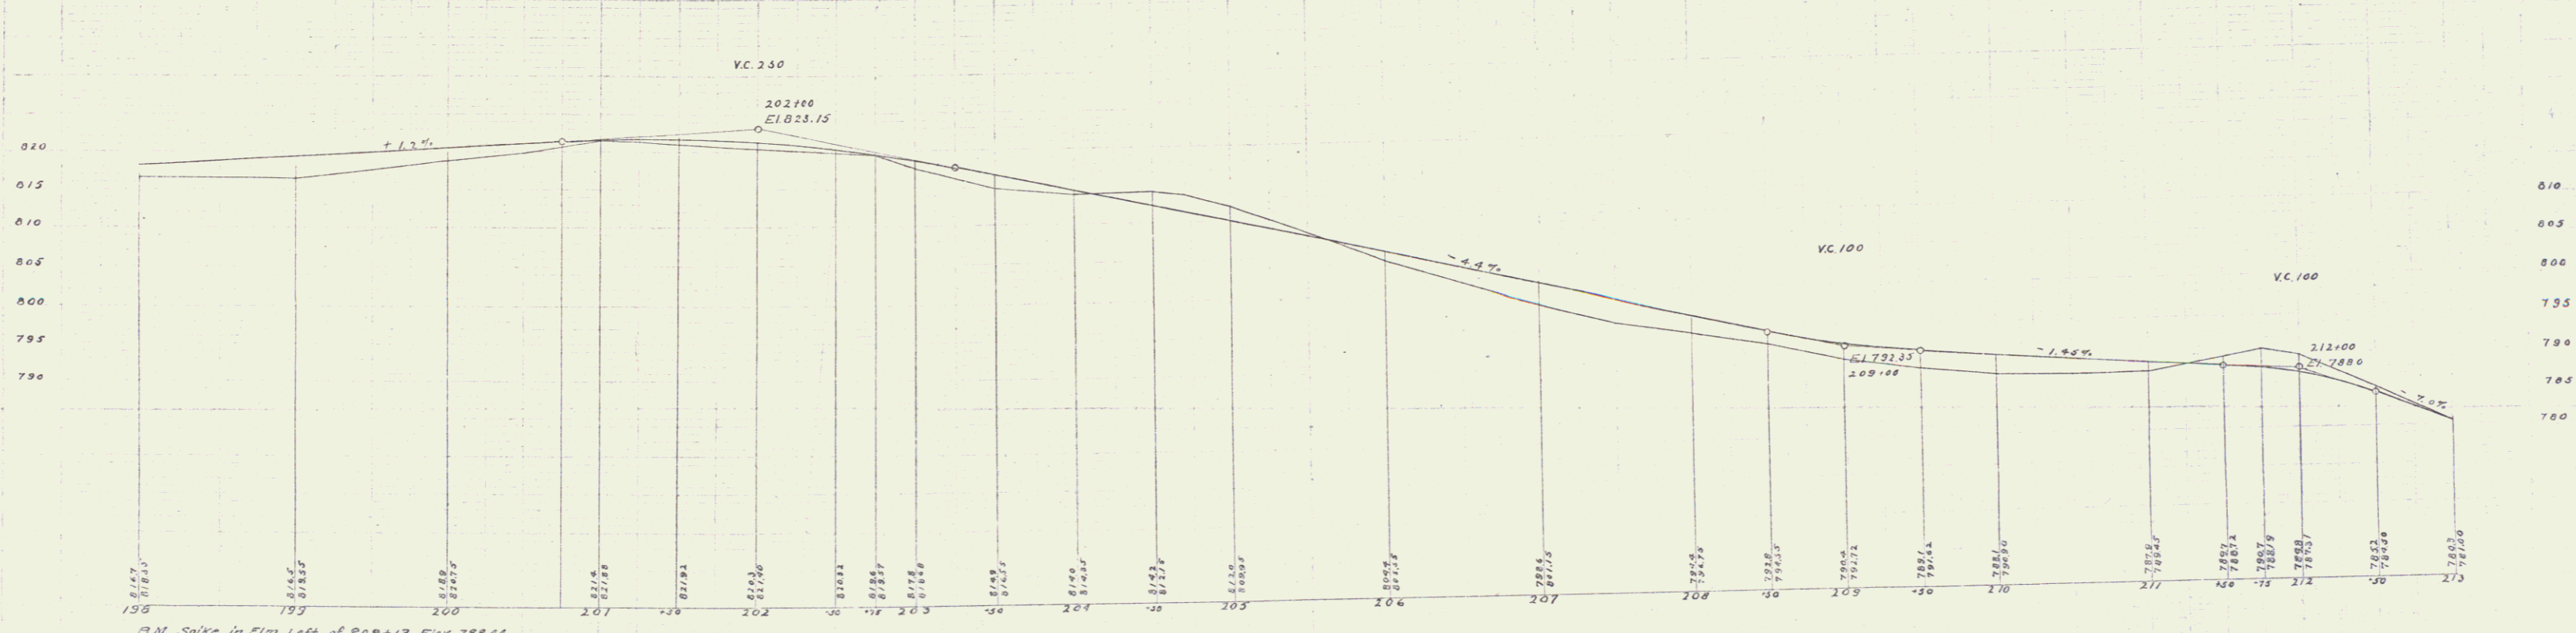


**GUARD RAIL REQUIRED**  
 ON LEFT  
 Sta 205+00 to 205+100 Length 100 ft  
 ON RIGHT  
 Sta 205+00 to 205+100 Length 100 ft  
 TOTAL THIS SHEET 200 ft

**NEW CULVERTS REQUIRED**  
 Sta 205+00 12" Cor. Iron Pipe 28 ft.  
 1-2-4 Concrete Headwalls 10 cu yds.  
 Sta 210+50 12" Cor. Iron Pipe 28 ft.  
 1-2-4 Concrete Headwalls 10 cu yds.

**CONCRETE RETAINING WALL REQUIRED**  
 Sta 212+45 to Sta 213+60 Length 115 ft.  
 1-3-6 Concrete 40 cu yds  
 Steel 7.0 lbs

FED. ROAD DIST. NO.	STATE	FED. AID PROJ. NO.	FISCAL YEAR	SHEET NO.	TOTAL SHEETS
8	VT.	12	1918-19	16	133

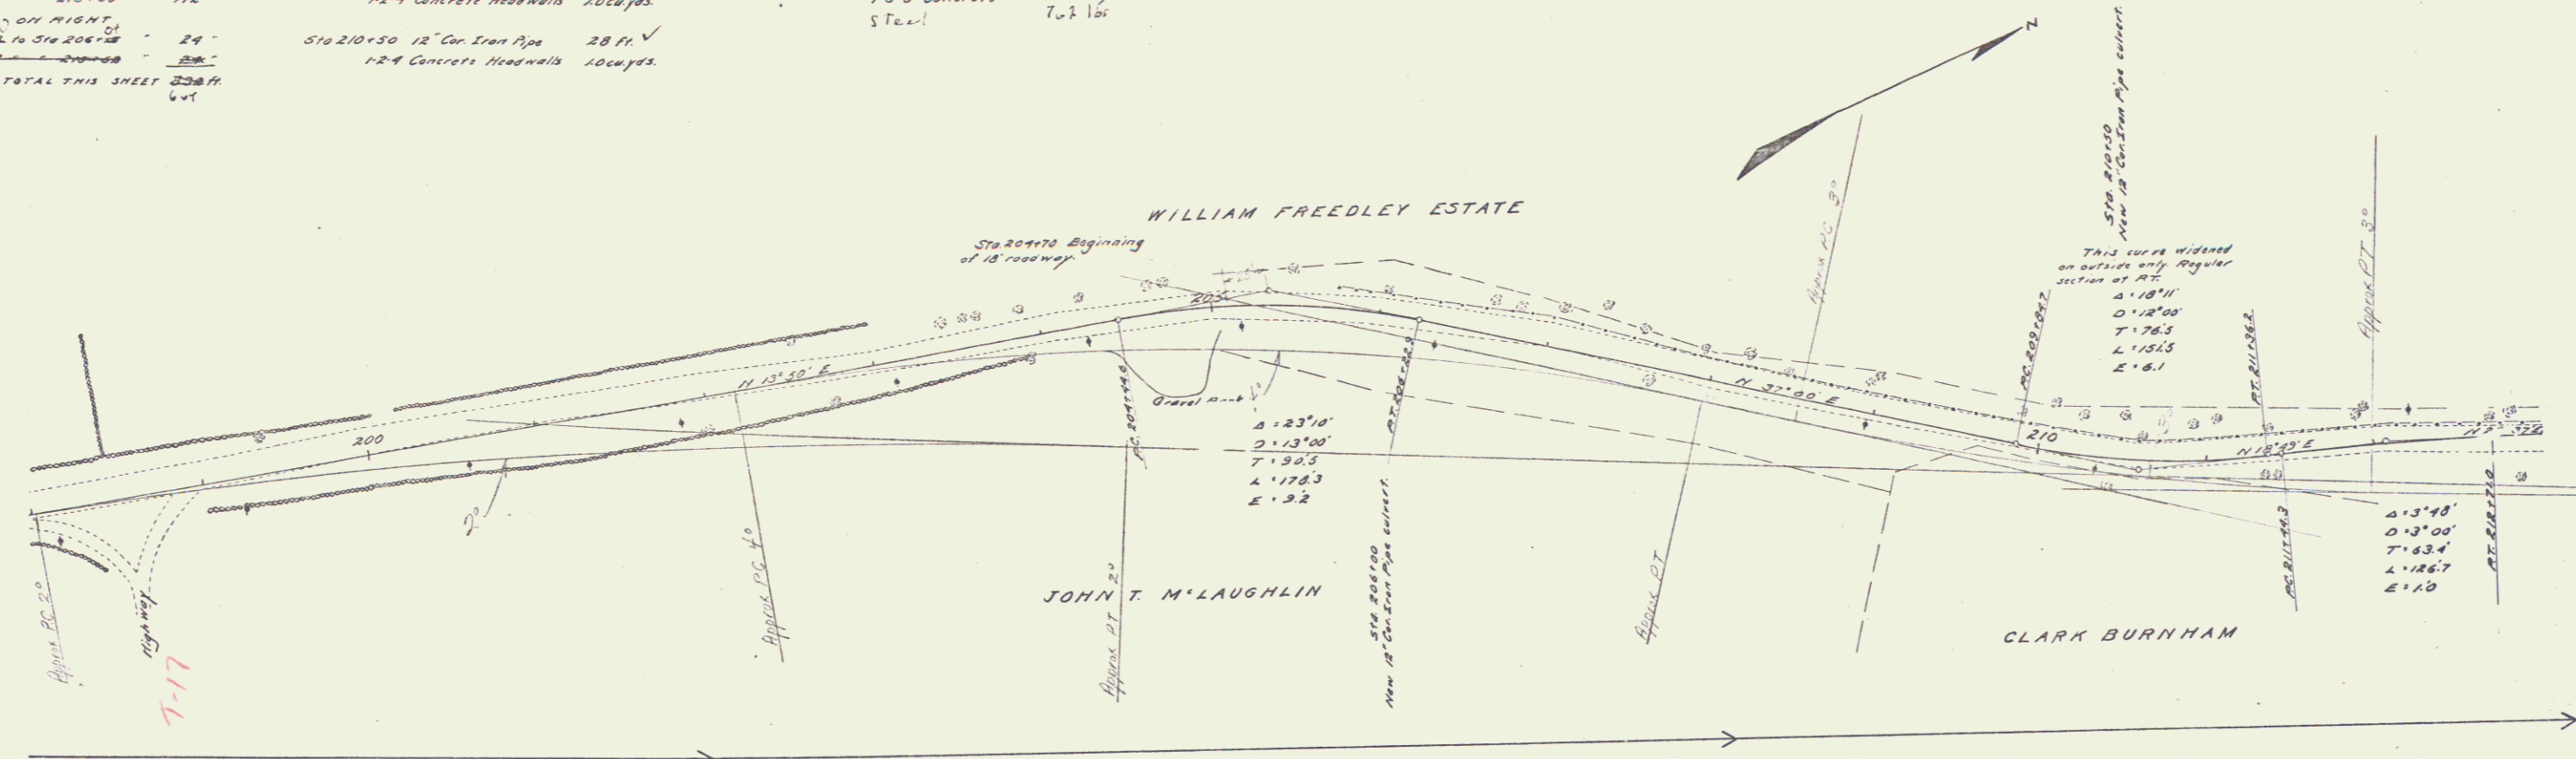

B.M. Spike in Elm. Left of 209+13, Elev 788.44  
 B.M. Spike in pole. Right of 199+23, Elev 816.73

Series F. 1912. 1913  
 1914 1915