

GUARD RAIL REQUIRED

Sta 322+00 to 322+10	Length 10 ft	24 ft
Sta 322+10 to 322+20	Length 10 ft	24 ft
Sta 322+20 to 322+30	Length 10 ft	24 ft
Sta 322+30 to 322+40	Length 10 ft	24 ft
Sta 322+40 to 322+50	Length 10 ft	24 ft
Sta 322+50 to 322+60	Length 10 ft	24 ft
Sta 322+60 to 322+70	Length 10 ft	24 ft
Sta 322+70 to 322+80	Length 10 ft	24 ft
Sta 322+80 to 322+90	Length 10 ft	24 ft
Sta 322+90 to 323+00	Length 10 ft	24 ft
TOTAL THIS SHEET	900 ft	216 ft

STONE BASE REQUIRED

Sta 322+00 to 322+10	Length 10 ft	300 cu yds
Sta 322+10 to 322+20	Length 10 ft	300 cu yds
Sta 322+20 to 322+30	Length 10 ft	300 cu yds
Sta 322+30 to 322+40	Length 10 ft	300 cu yds
Sta 322+40 to 322+50	Length 10 ft	300 cu yds
Sta 322+50 to 322+60	Length 10 ft	300 cu yds
Sta 322+60 to 322+70	Length 10 ft	300 cu yds
Sta 322+70 to 322+80	Length 10 ft	300 cu yds
Sta 322+80 to 322+90	Length 10 ft	300 cu yds
Sta 322+90 to 323+00	Length 10 ft	300 cu yds
TOTAL THIS SHEET	900 ft	2700 cu yds

NEW CULVERT

Sta 322+00	12.4	12.4
Sta 322+10	12.4	12.4
Sta 322+20	12.4	12.4
Sta 322+30	12.4	12.4
Sta 322+40	12.4	12.4
Sta 322+50	12.4	12.4
Sta 322+60	12.4	12.4
Sta 322+70	12.4	12.4
Sta 322+80	12.4	12.4
Sta 322+90	12.4	12.4
Sta 323+00	12.4	12.4



VERTS REQUIRED

- Cor Iron Pipe 32 Ft
- Concrete Headwalls 10 cu yds

CULVERT REPAIRS REQUIRED

- Cor Iron Pipe (Extending 6 Ft)
- Concrete Headwalls 10 cu yds

PROJECT NO.	STATE	FED AID	CIRCUIT
3	VT	12	100-10

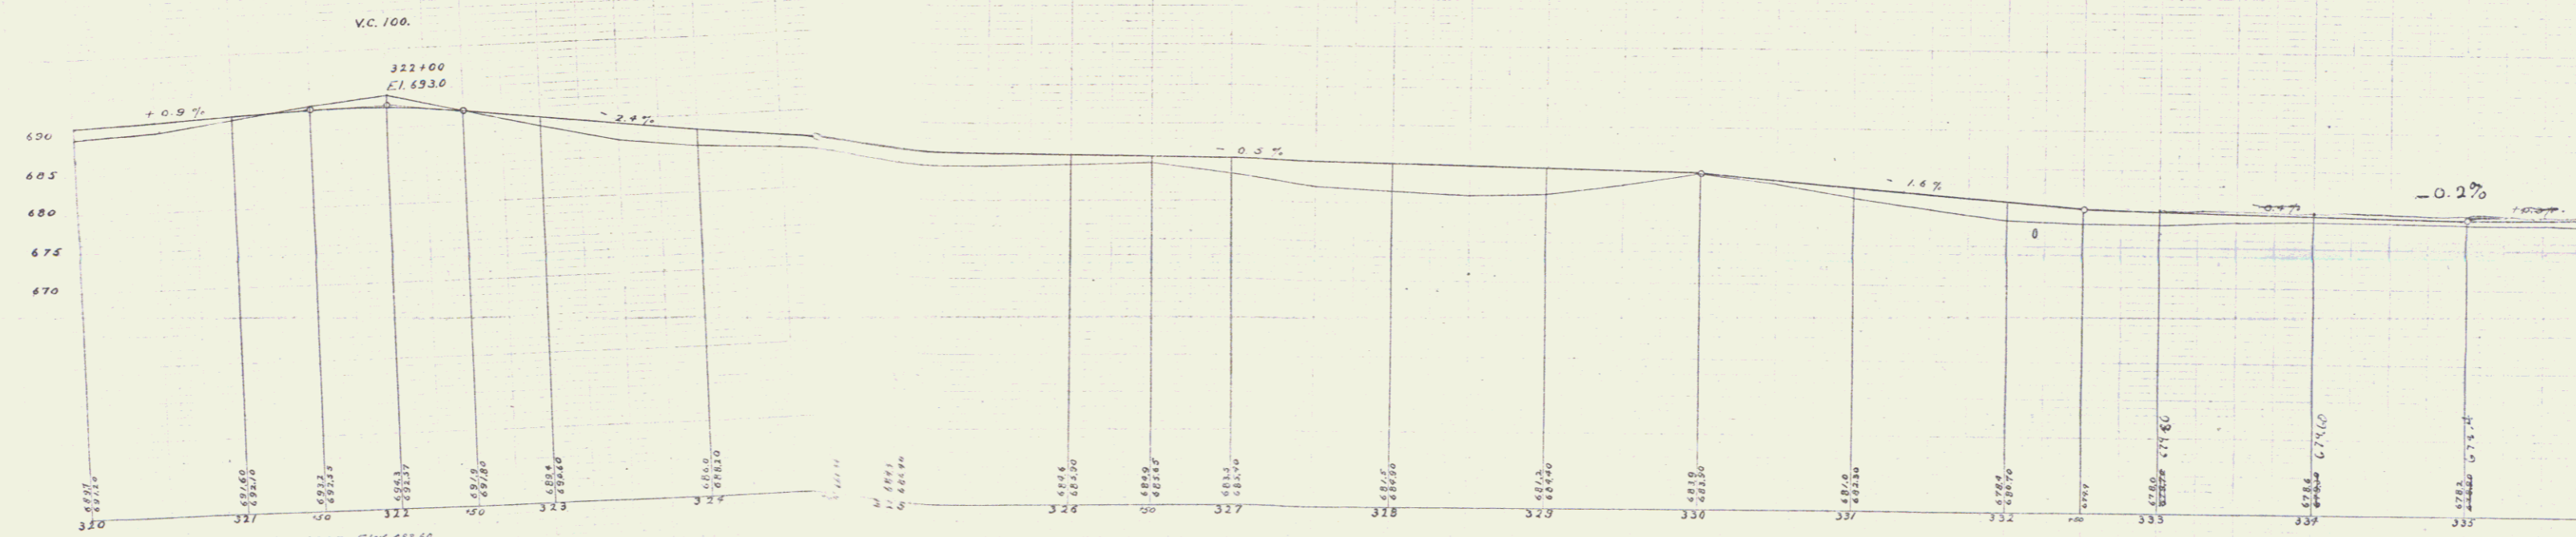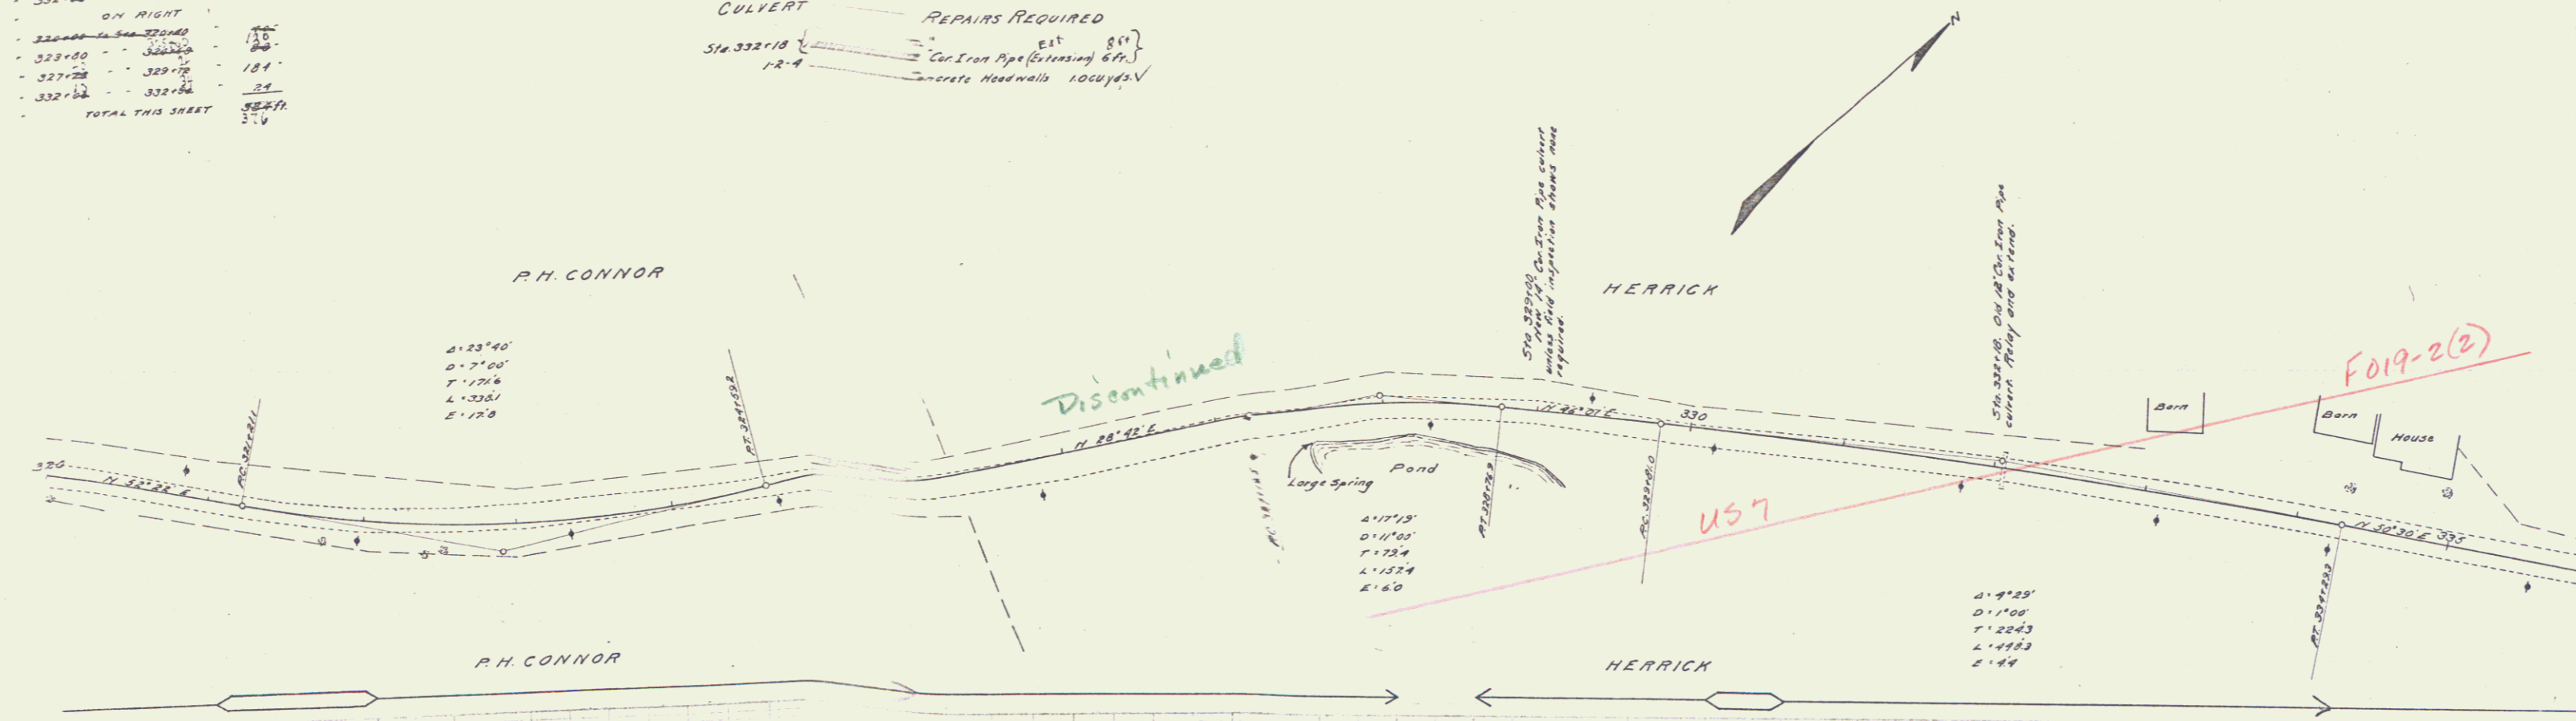

B.M. Spike in Pole left of 322+35. Elev 682.60
 D.M. SE corner middle Stone of 400' steps 1/4 of 324+57. Elev 682.18