

GUARD RAIL REQUIRED

ON LEFT

Sta 336106 to Sta 336130	Length 24ft	
337141	337171	24
339145	339169	24

ON RIGHT

336106 to Sta 336130	24	
337141	337171	24
339145	339169	24
341148	341172	24
343148	343172	24

ON LEFT

345108	345132	24
347108	347132	24

TOTAL THIS SHEET 240ft

STONE BASE REQUIRED

Sta 336100 to Sta 341100 Length 500ft

NEW CULVERTS REQUIRED

near Sta 337139 3'x2' Reinforced concrete
1-2-4 Concrete 33 cu yds
1-3-6 " " 28 " "
Steel 112 lbs.



Sta 339137 12" EA⁺ 21'
1-2-4 Concrete 10
1A 4ft
345+80 14" EA⁺ 4ft
1-2-4 " 10
12 cu yds.

349+05 14" Cor. Iron Pipe 26 ft
1-2-4 Concrete 10 cu yds.

FED ROAD DIST. NO.	STATE	FED AID PROJ. NO.	FISCAL YEAR	SHEET NO.	TOTAL SHEETS
8	VT	12	1952	25	123

W.H. Davis
C.H. Day

W.H. Davis
C.H. Day
P.M. Stevens
J.L. Davis

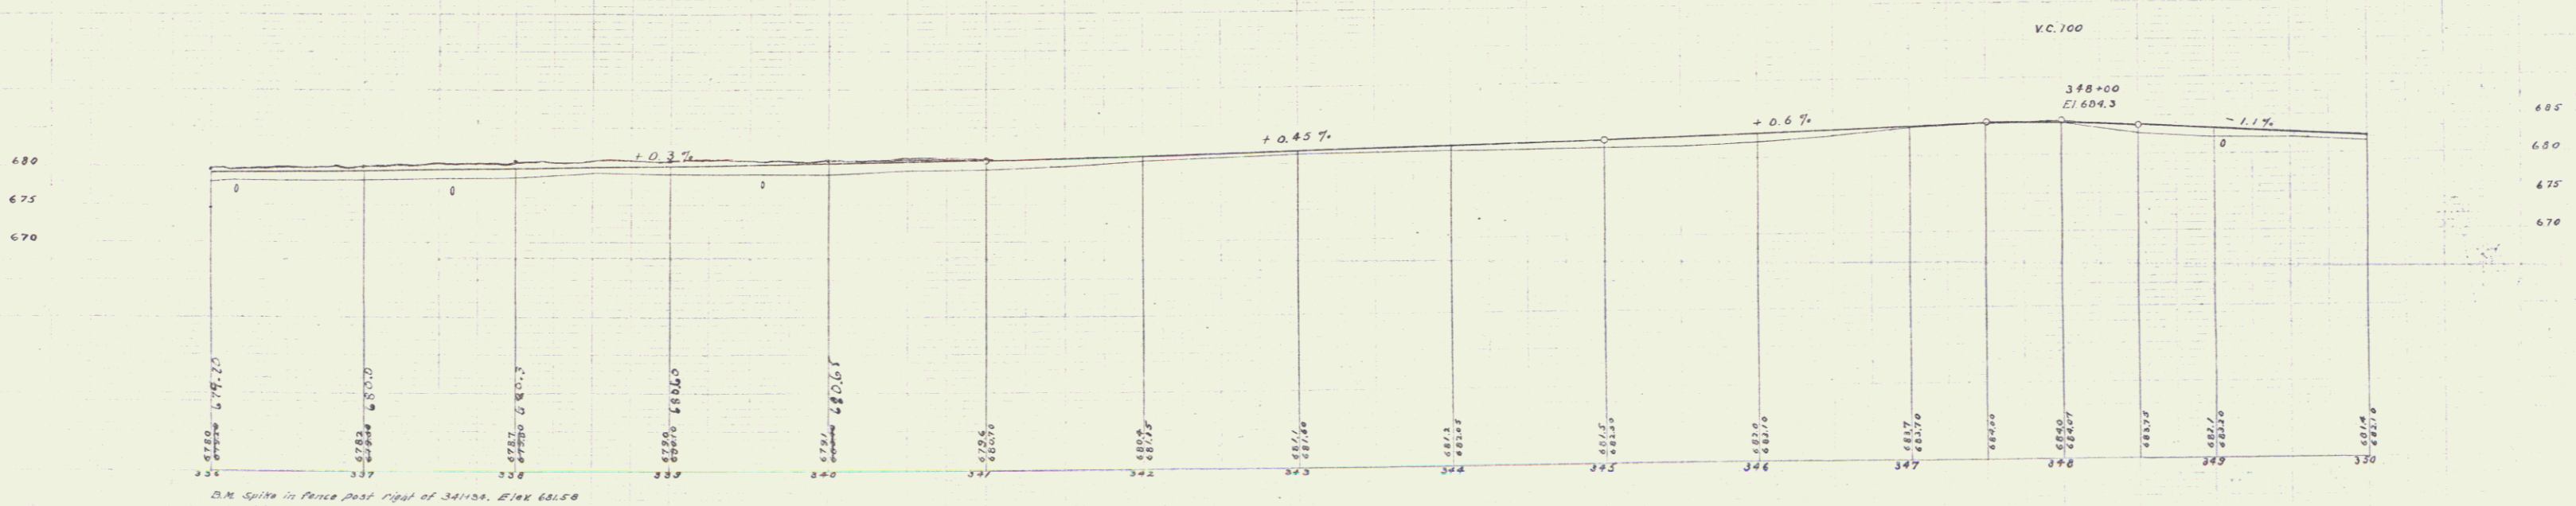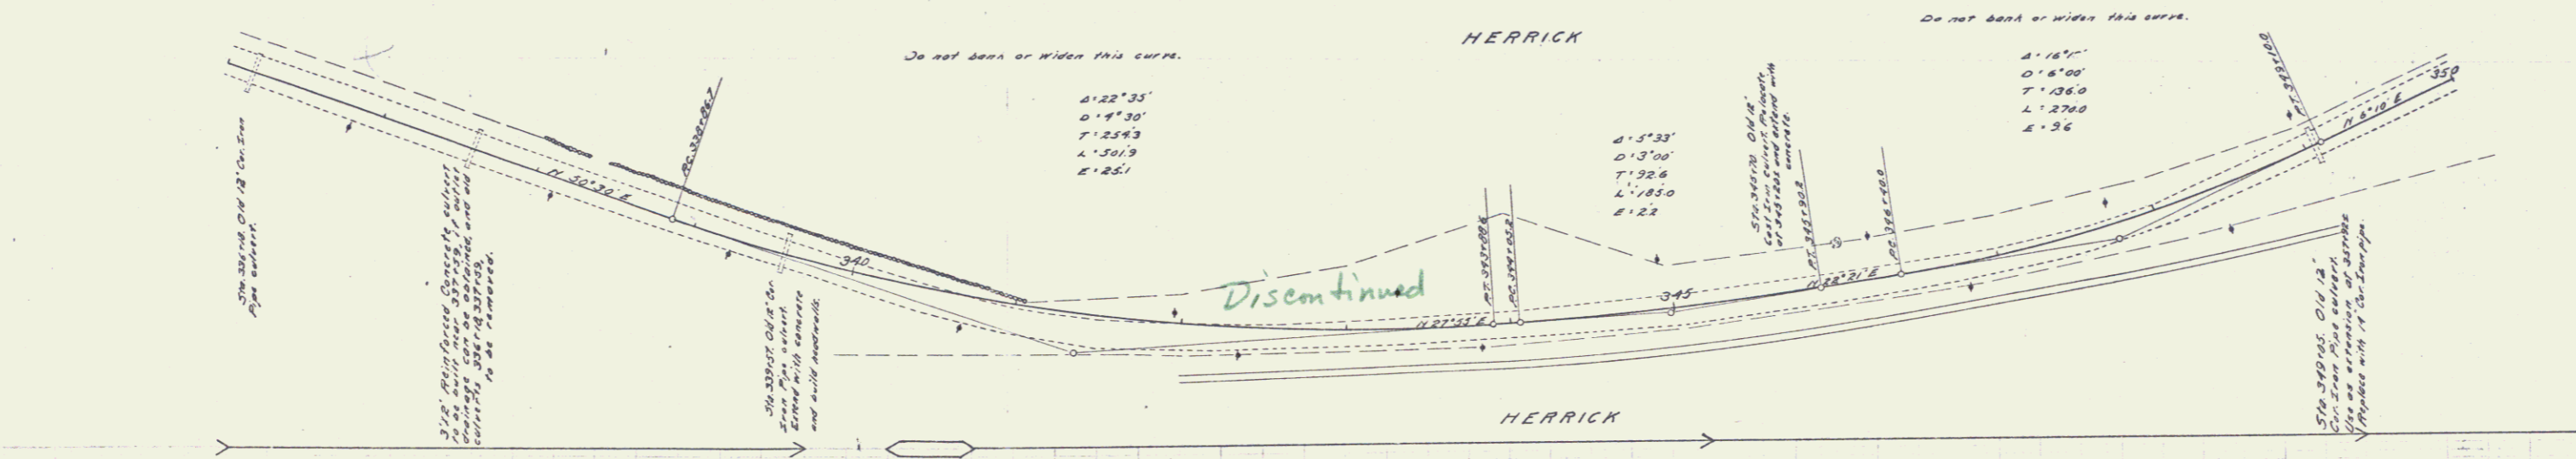

Series F 10/20/52
Sheet 25 of 123