

BM 1-A
 30' MAPLE
 ELEV 794.05

CURVE
 Δ 23'-10 1/2"
 D 33
 R 1637.5
 T 330.6
 L 632.4
 E 33.1

J.H. BEEBE
 PI 0.056
 D 33.0
 R 1637.5
 T 330.6
 L 632.4
 E 33.1

SPRING 3+06 LT
 The following agreement between property owner John H. Sweeney and the State Highway Board is to be carried out by the Contractor during construction as part of his contract. For project WPGH 12A.


AGREEMENT:
 WPGH 12A, ON RUTLAND-MANCHESTER ROAD, ROUTE US 7
 Spring to be completely sealed by concrete box with 6" Galvanized Metal Pipe, outlet across old road to the property of Mr. Sweeney, as shown on plans.
 Spring to be dug deeper to give some water storage as at present.
 Pipe to be skewed towards house all that is practicable.

J.H. BEEBE &
 INC. IN DEED
 J.M. BEEBE
 Mortgages E Dorset

CURVE
 Δ 23'-10 1/2"
 D 33.0
 R 1637.5
 T 330.6
 L 632.4
 E 33.1

NOTE 6:00-12:00 P.M.
 Dike to be graded back to carry water back to cul at 6:00.

NOTE
 Much encountered on this project shall be removed as shown on the Typical Sections and backfill to be with approved borrow Item 10-11. The much shall be disposed of in fill outside of road metal and flattening slopes on the project as shown on the Typical Sections, and at such locations as directed by the Engineer.

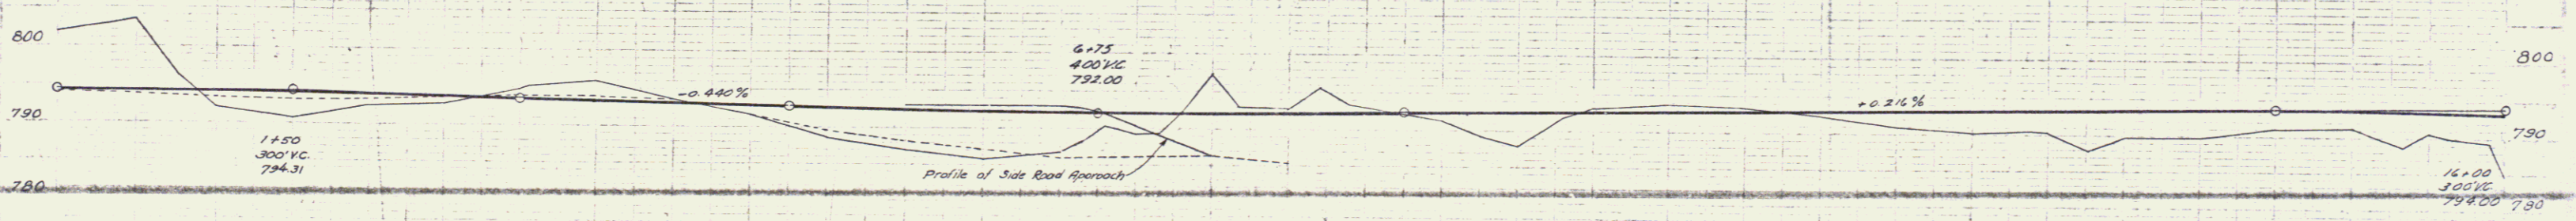

STA 0+00-16+00
 12" SUB-BASE OF GRAVEL

PARCEL	INSTRUMENT	DATE	GRANTOR	GRANTEE	RECORDED DOORSET	REMARKS
A	O.C.D.	11-19-36	J.H. & J.M. BEEBE	J.P. Y.	BOOK PAGE DATE	
A'	N.D.	9-14-36	CHARLES G. WETTER	"	35 420 11-22-36	
A"	N.D.	11-27-36	VERMONT MARBLE CO.	"	35 388 9-26-36	

STATION	ELEVATION	STATION	ELEVATION
0+00	794.05	10+00	792.00
1+00	794.31	11+00	792.00
2+00	794.31	12+00	792.00
3+00	794.31	13+00	792.00
4+00	792.00	14+00	792.00
5+00	792.00	15+00	792.00
6+00	792.00	16+00	794.00

BM 1-A SPIKE IN ROOT OF 30' MAPLE 44' LT. OF STA 0+20 ELEV 794.05
 BM 1 SPIKE ON TOP OF CONG. CULV. HD. 10' LT. STA 3+46 ELEV 798.50
 BM 2 SPIKE ON TOP OF CONG. CULV. HD. 10' LT. STA 6+00 ELEV 786.46
 BM 3 SPIKE IN ROOT OF 12' LLM 60' RT. OF STA 14+60 ELEV 792.48