


12-A
D. MACCHI
9/87

WPGH
12-A 1987 7 37

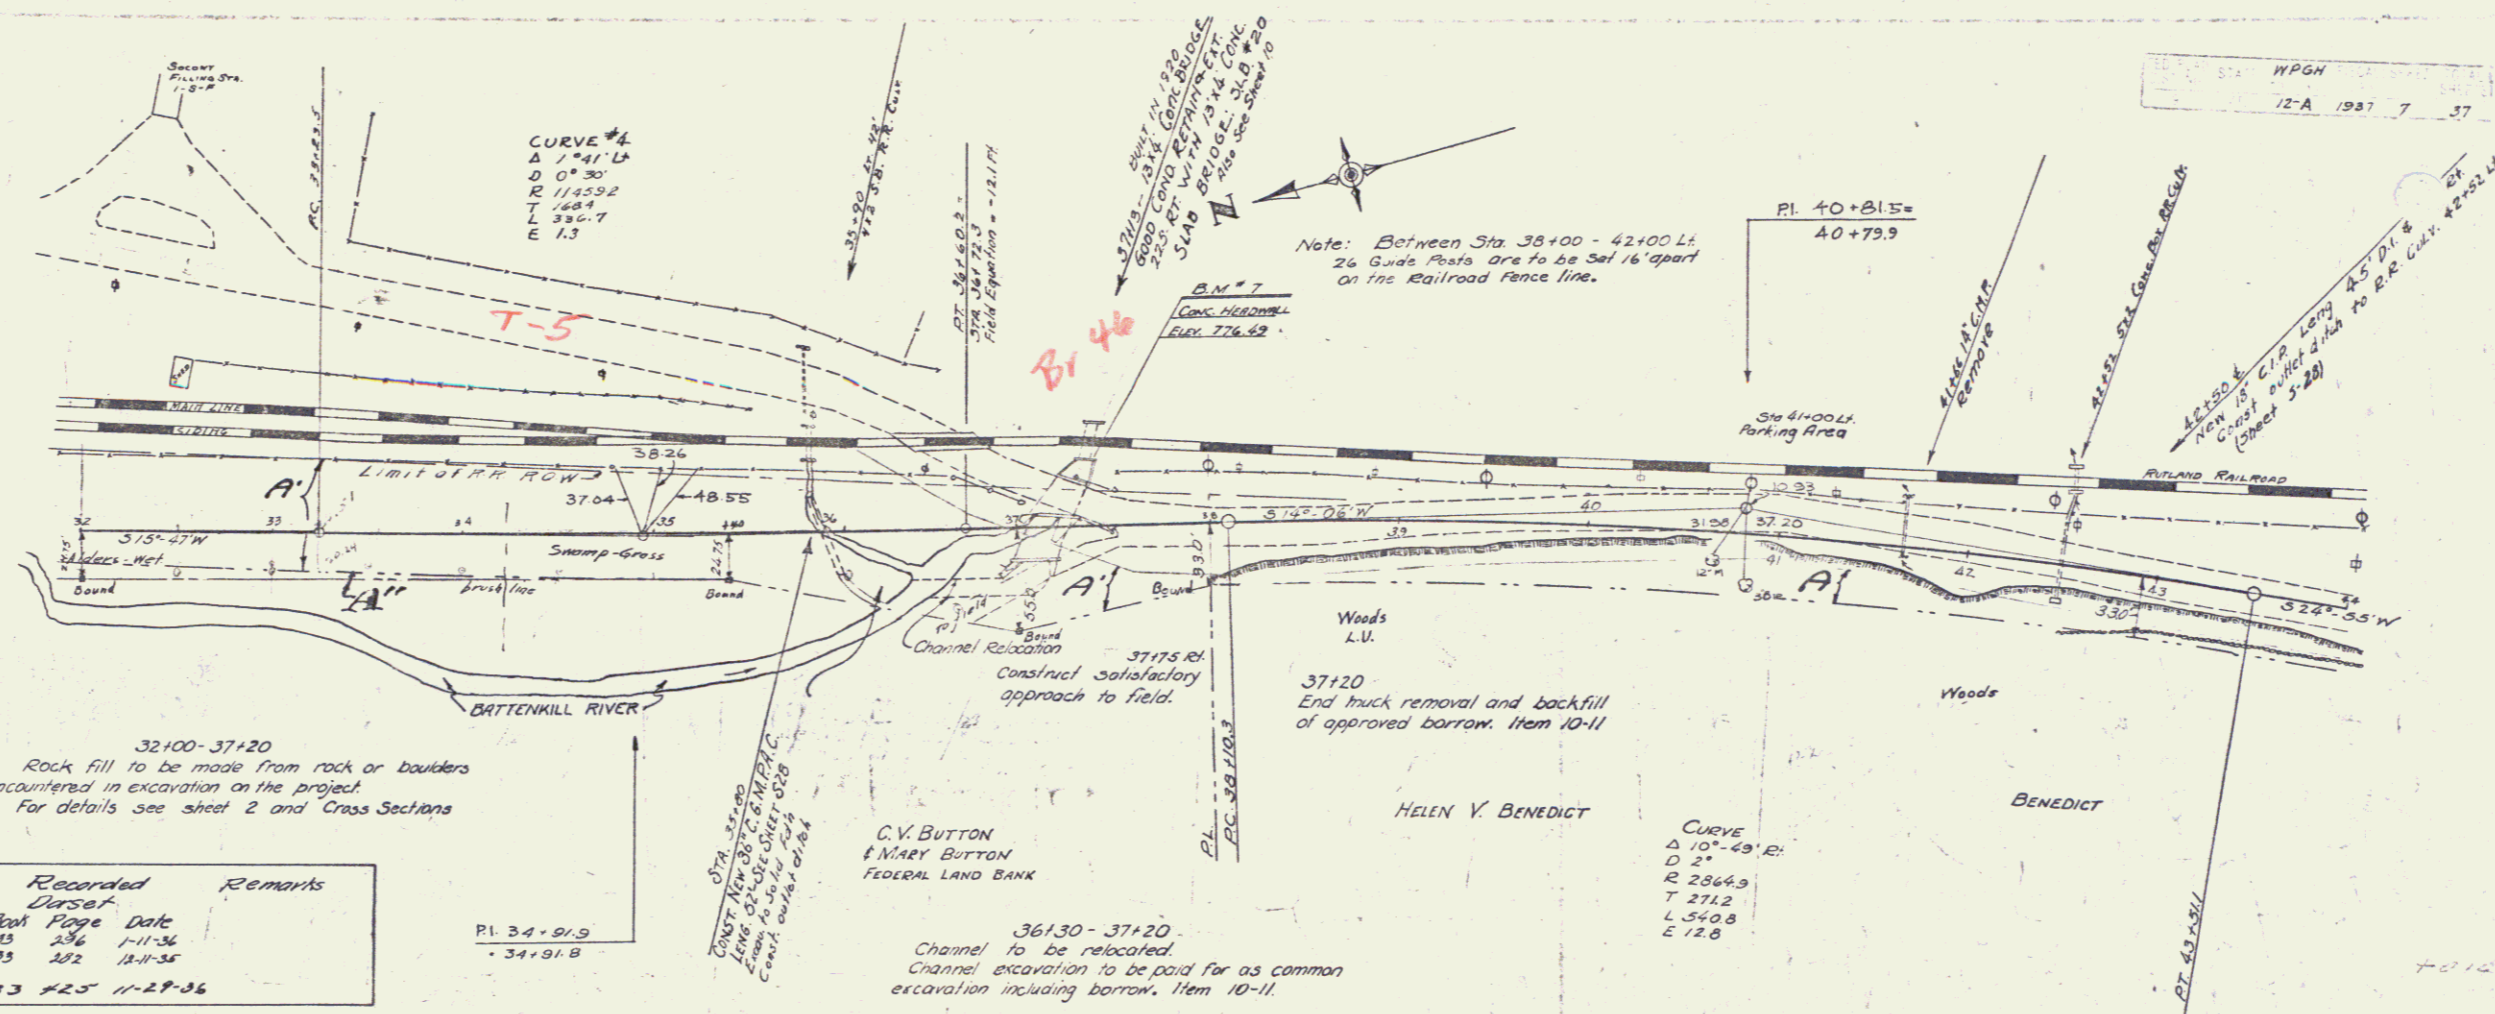


32+00-37+20
Rock fill to be made from rock or boulders encountered in excavation on the project. For details see sheet 2 and Cross Sections

36+30-37+20
Channel to be relocated. Channel excavation to be paid for as common excavation including borrow. Item 10-11.

Parcel	Kind of Instrument	Date of Instrument	Grantor	Grantee	Recorded	Remarks
A'	G.C.D.	1-8-36	C.V. Mary Button	Steff	33 236	1-11-36
A	"	12-6-35	Helen V. F.W. Benedict	"	33 292	11-11-35
A''	G.C.D.	11-17-36	C.V. & MARY BUTTON	"	33 425	11-27-36

12-A
D. MACCHI

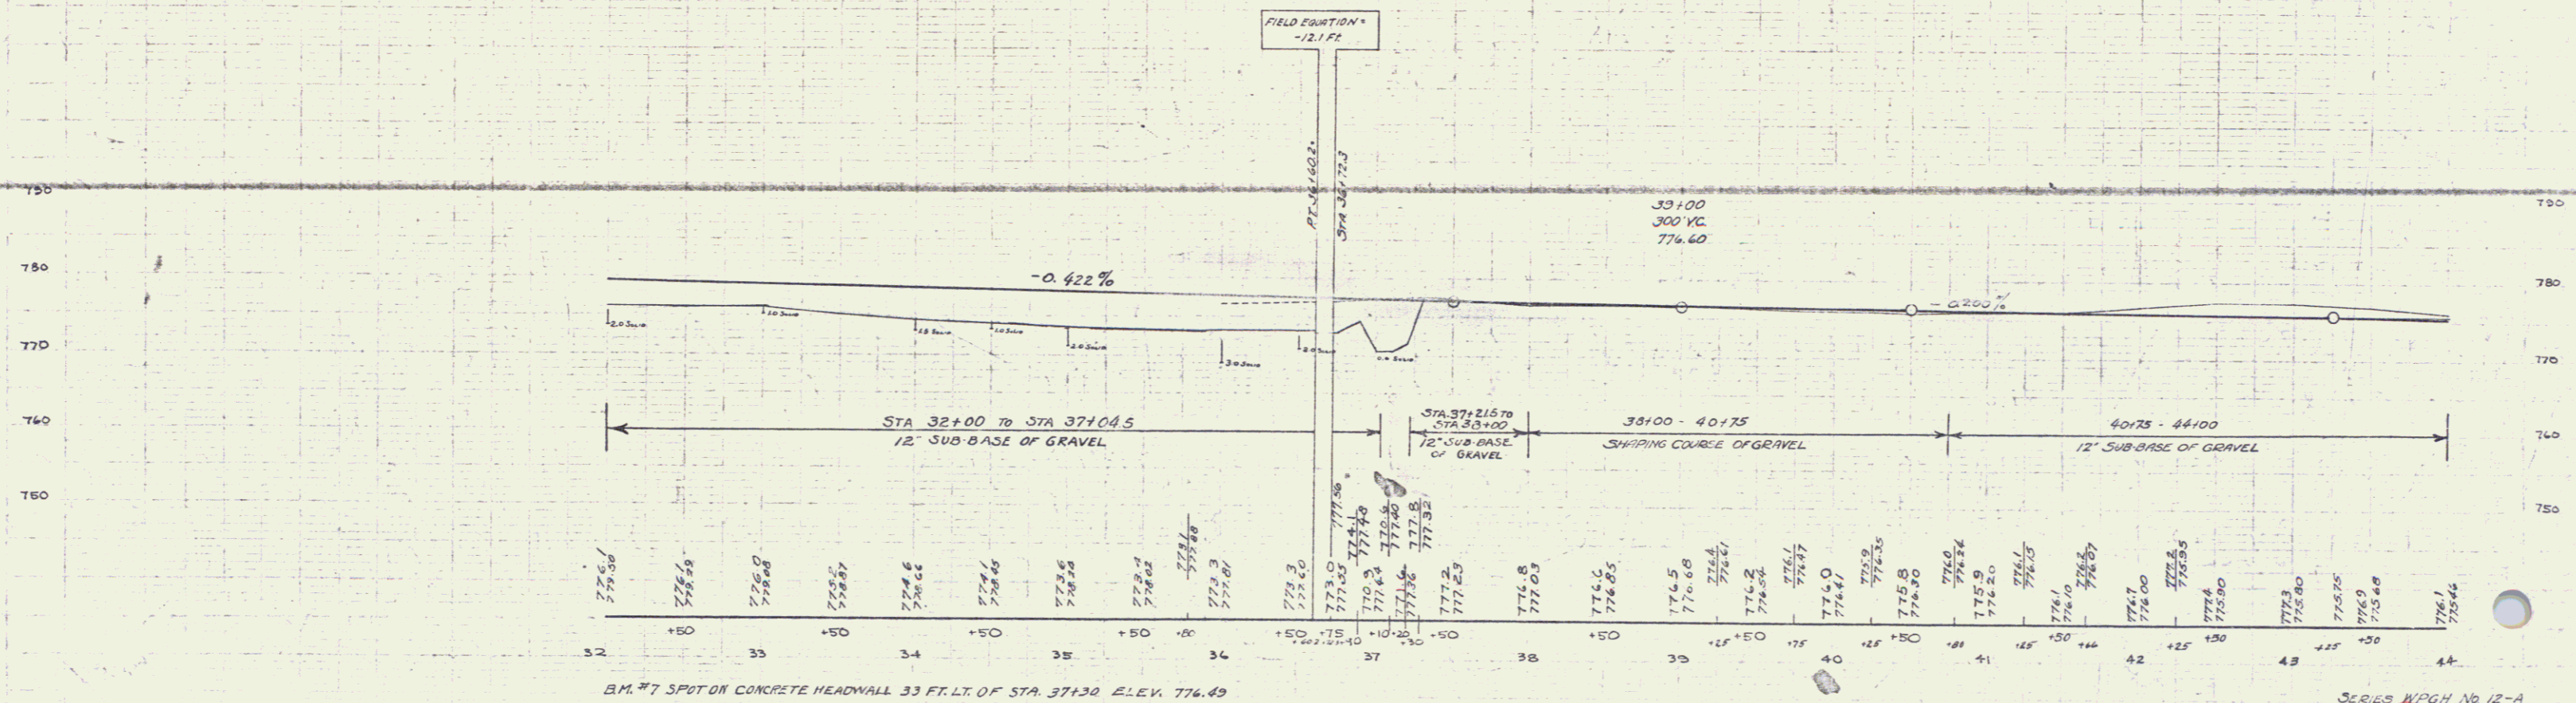

B.M. #7 SPOT ON CONCRETE HEADWALL 33 FT. LT. OF STA. 37+30. ELEV. 776.49

SERIES WPGH No 12-A
SHEET 7 OF 37

5