


Parcel	Kind of Instrument	Date of Instrument	Grantor	Grantee	Recorded Dorsal	Remarks
A	W.D.	4-3-35	As. Mary Haley	Staff.	33 194	4-3-35
A ¹	W.D.	1-21-35	As. Mary Haley	Staff.	33 187-188	4-3-35
A ²	"	3-29-35	Nat. Aircraft Co.	"	33 191-193	4-3-35
A ³	"	3-11-35	E. H. & M. Carlisle	"	33 191	4-3-35

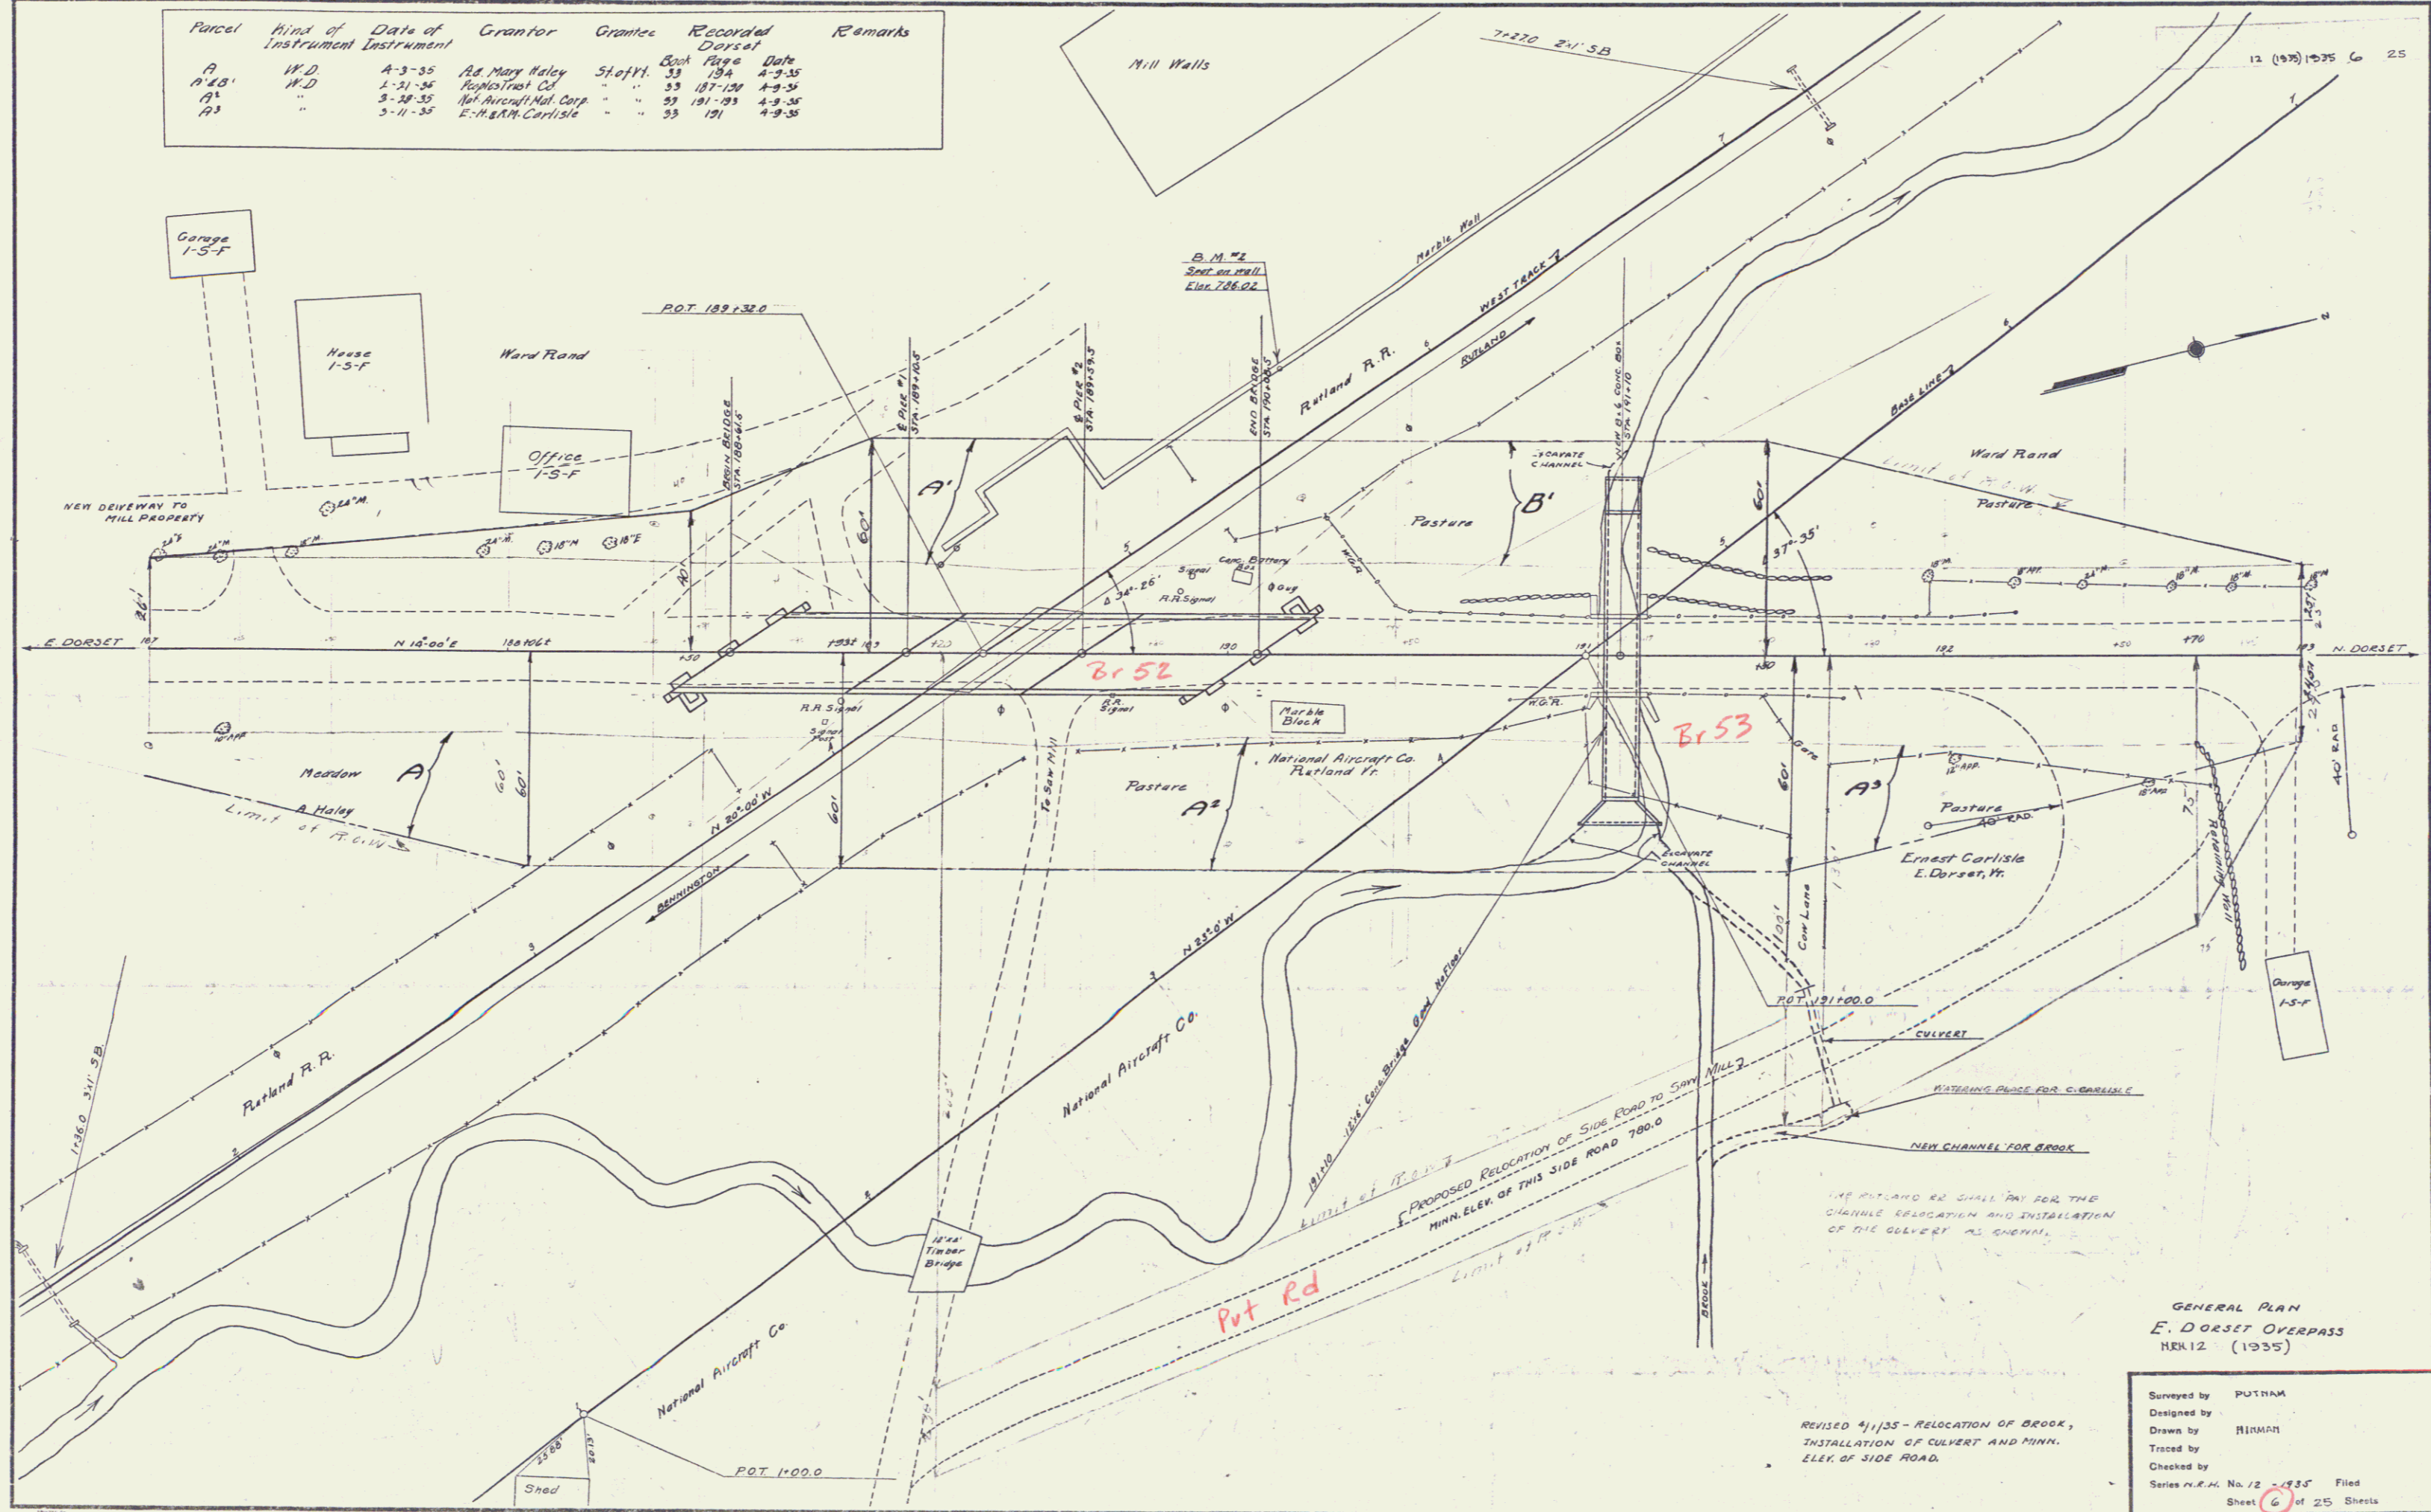

GENERAL PLAN
E. DORSET OVERPASS
SER. 12 (1935)

REVISED 4/1/35 - RELOCATION OF BROOK,
INSTALLATION OF CULVERT AND MINN.
ELEV. OF SIDE ROAD.

Surveyed by	PUTNAM
Designed by	HIRMAN
Drawn by	HIRMAN
Traced by	
Checked by	
Series P.E.M. No. 12	435 Filed
Sheet	6 of 25 Sheets