
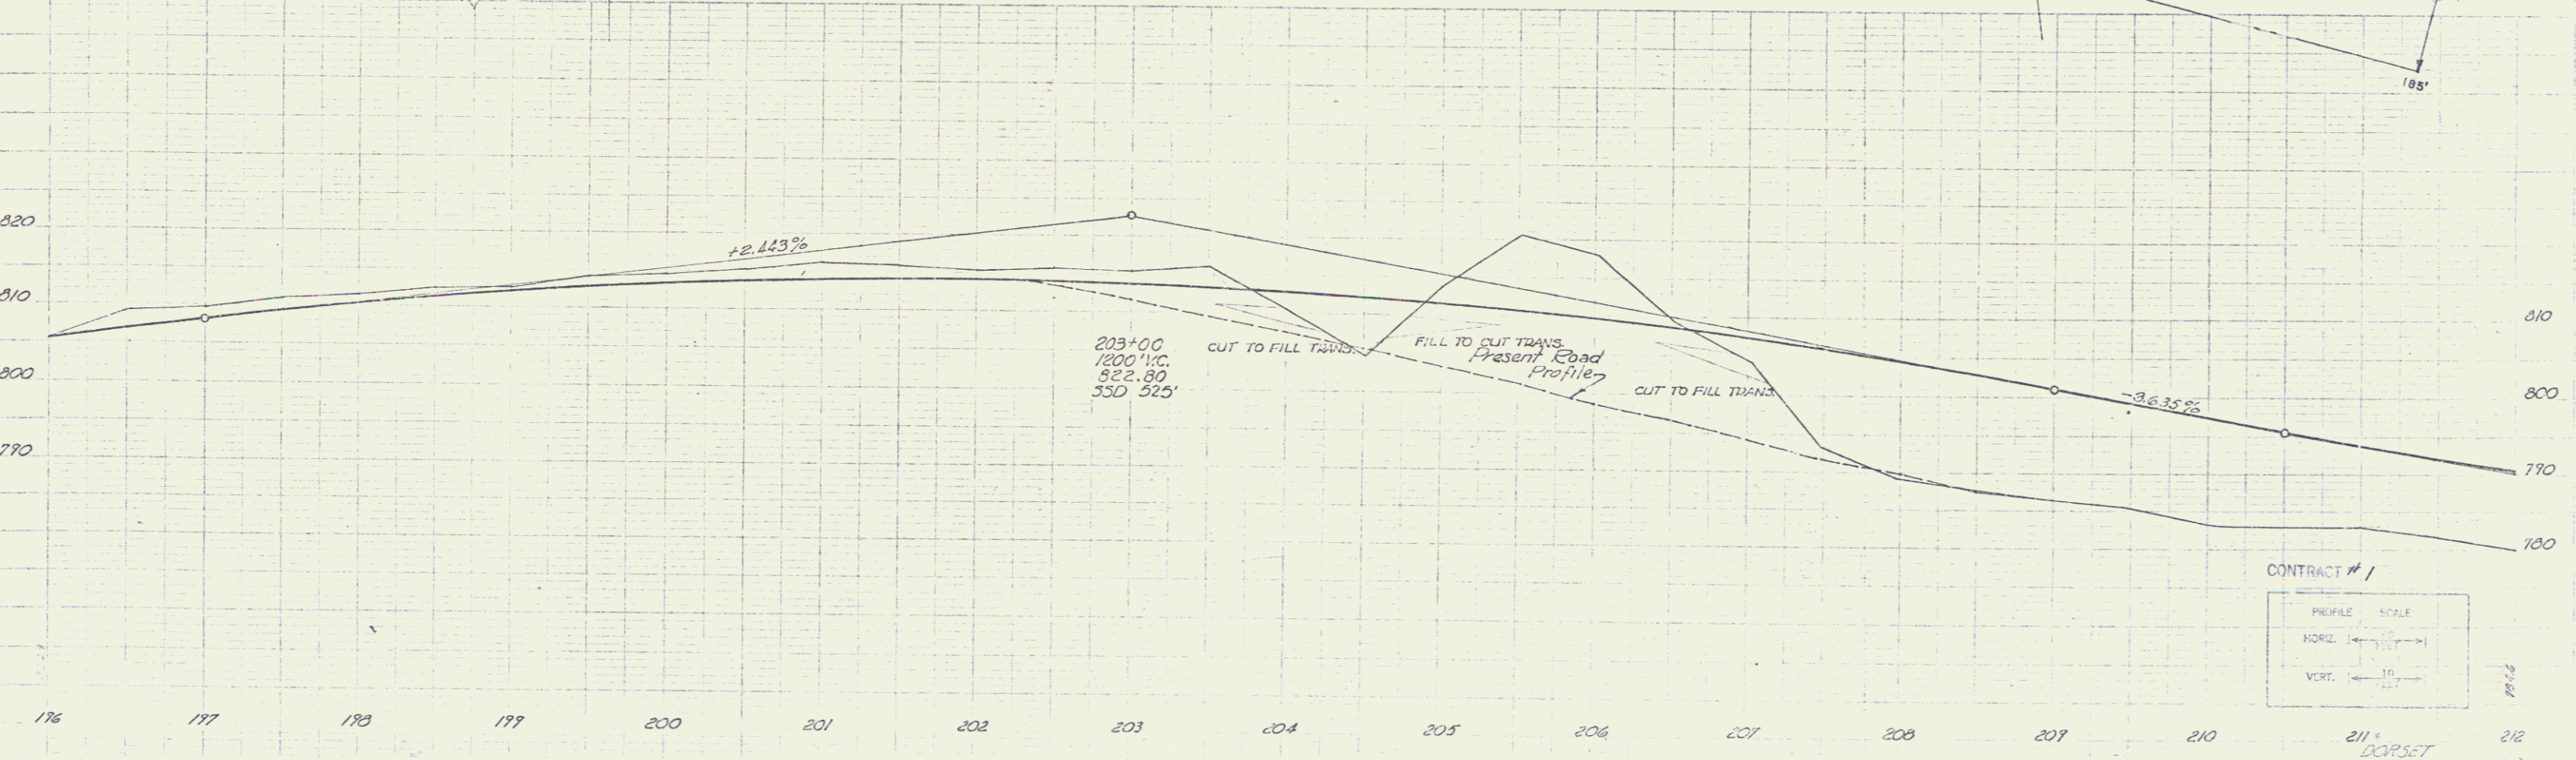


Three Cable Guard Rail w/ Steel Posts Item 543 204+00 - 212+00  
 Removal & Disposal of Present Guard Rail Item 550 198+00 - 211+00 LT  
 Construct Drive 198+00 LT 203+05 LT 208+25 LT  
 Treated Timber Curb Item 558 208+50 - 212+00 LT  
 Excavation and Removal of Road Surface on Roadways Item 118-A 203+00 - 206+00 LT  
 STATE OF VERMONT FISH & GAME SERVICE  
 Construct Approach Town Road 198+00 - 212+00 LT 111+45 ft

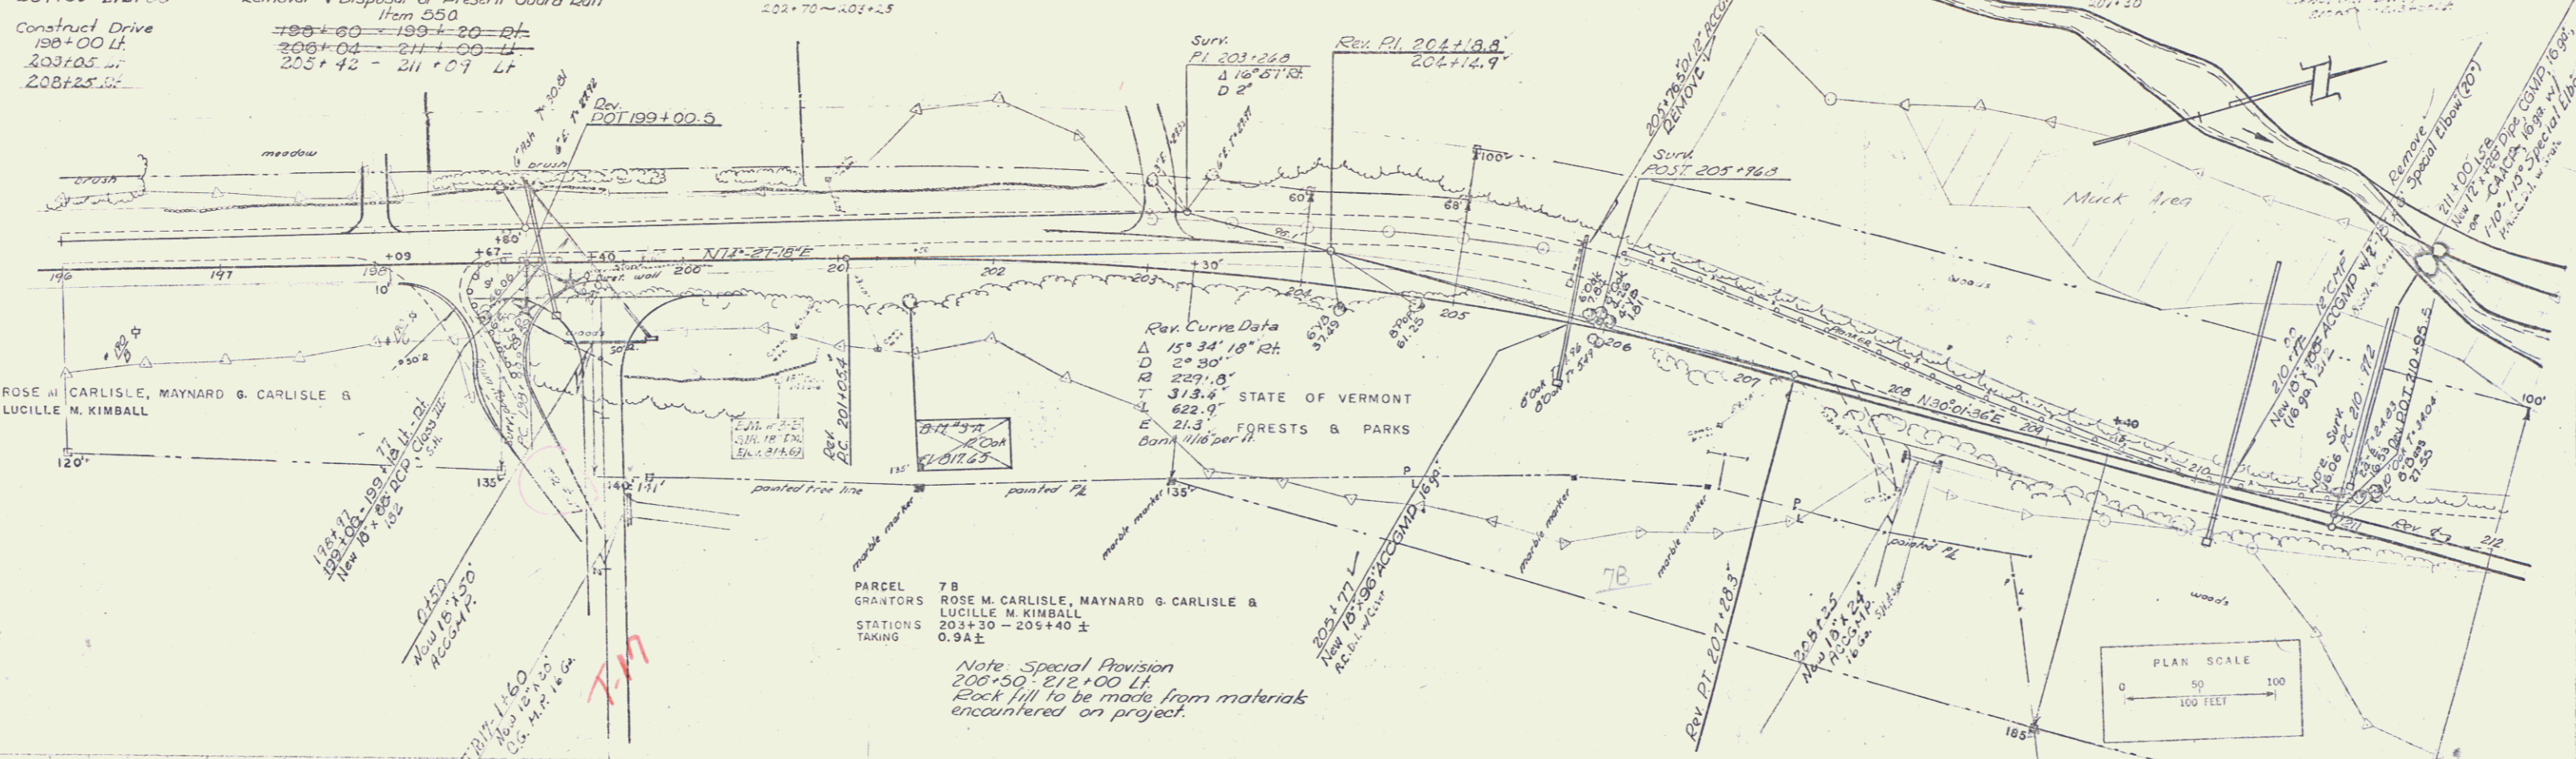

CONTRACT # 1  
 PROFILE SCALE  
 HORIZ. 1" = 100'  
 VERT. 1" = 10'  
 DORSET  
 10  
 130