





Three Cable Guard Rail w/ Steel Posts, Item 543
228+00 - 244+00

Drilling & Blasting of Solid
Rock Subgrade, Item 114
227+00 - 244+00
333+33 - 244+00

Excavation and Removal of Road
Surface on Roadways, Item 113-A
227+25 - 243+50 Lt.

Construct Drive
230+20 - 240+00

Seeding, Item 611
Comm. Fert. for Grasses, Item 615
Topsoil, Item 621
230+50 - 238+00 Rt.

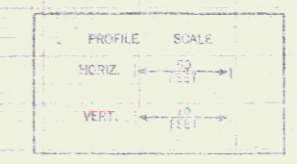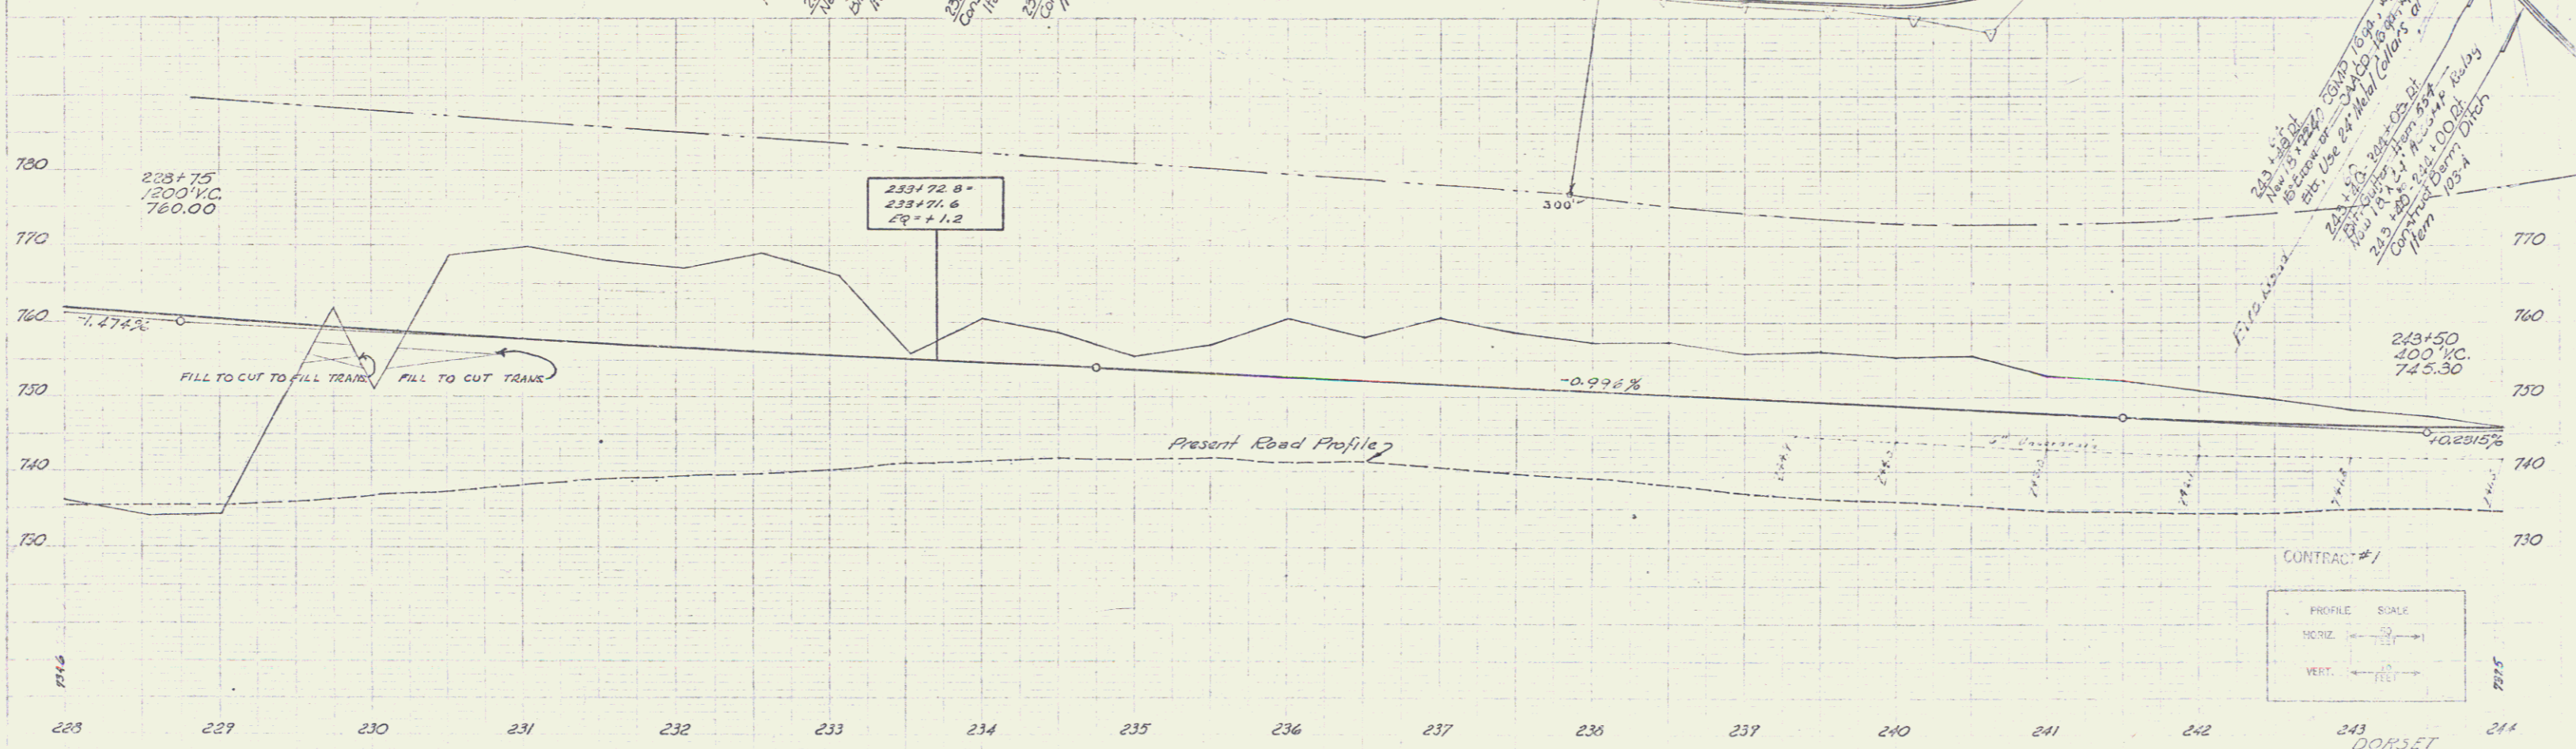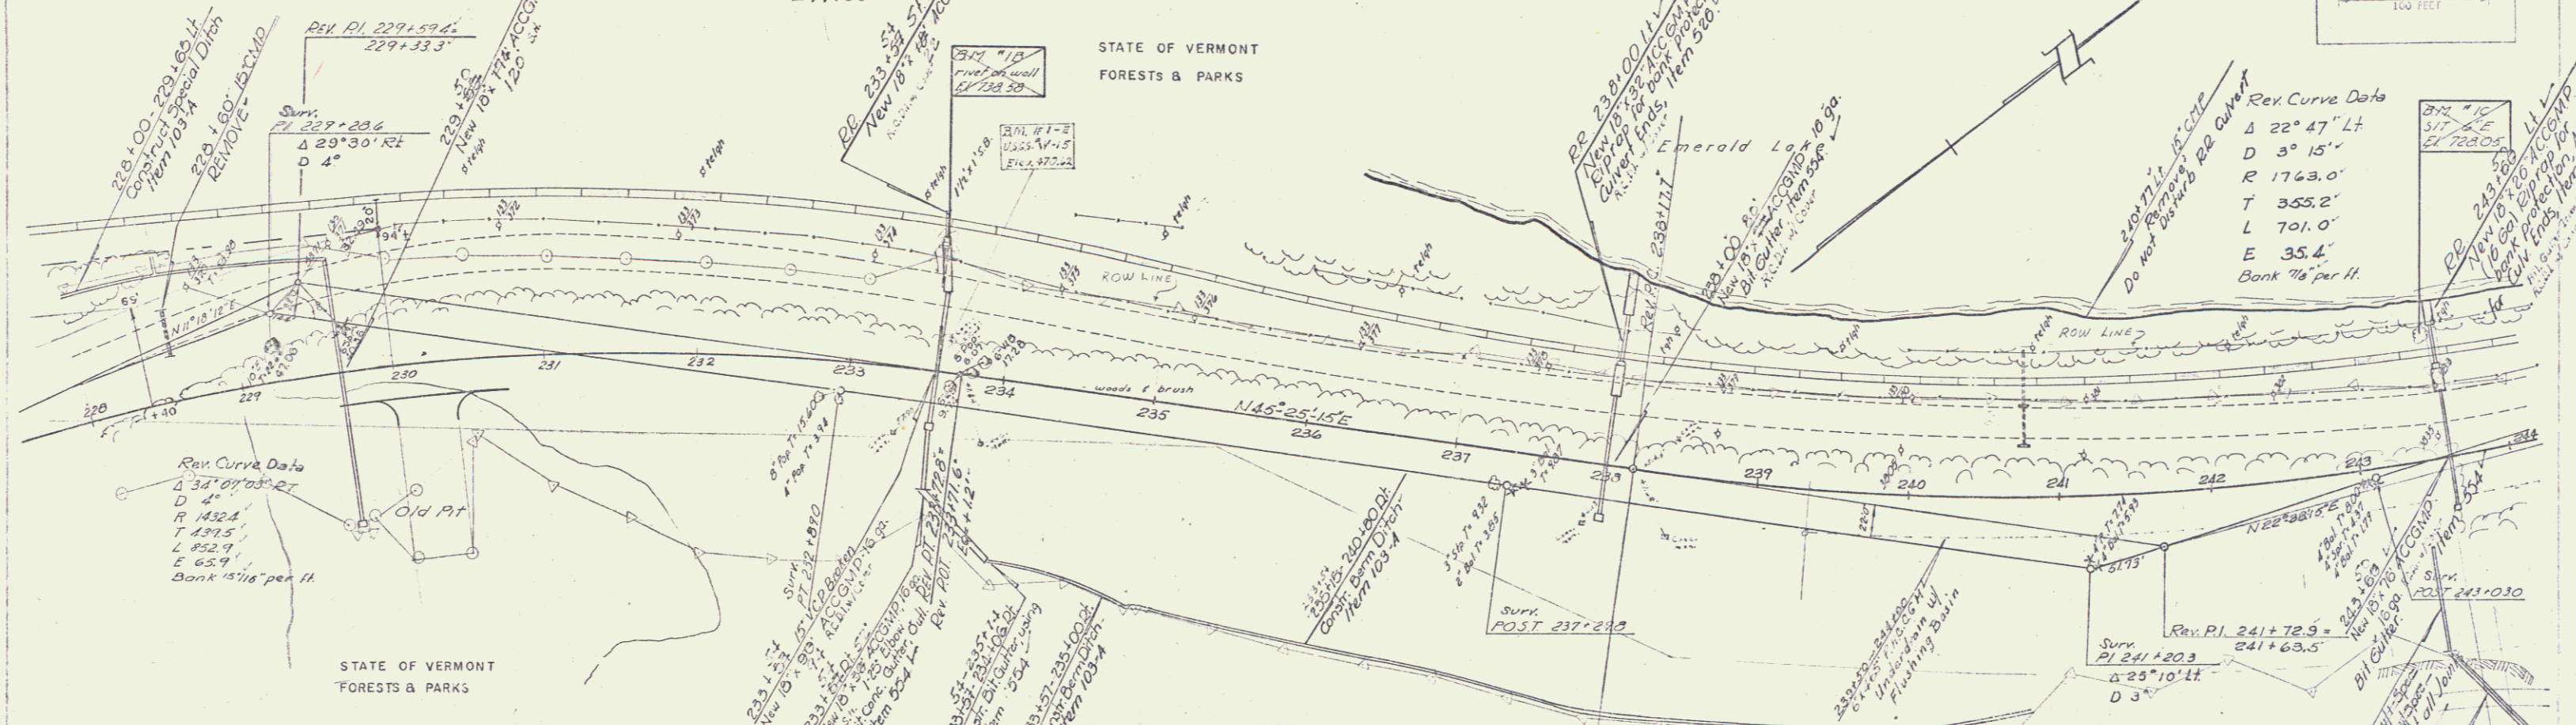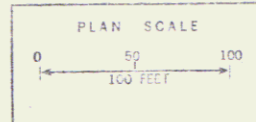

243 DORSET
Proj. No. 019-2(12)
Sheet 12 of 130

6