



PLAN
 BROWNELL
 1/2" = 1'-0"

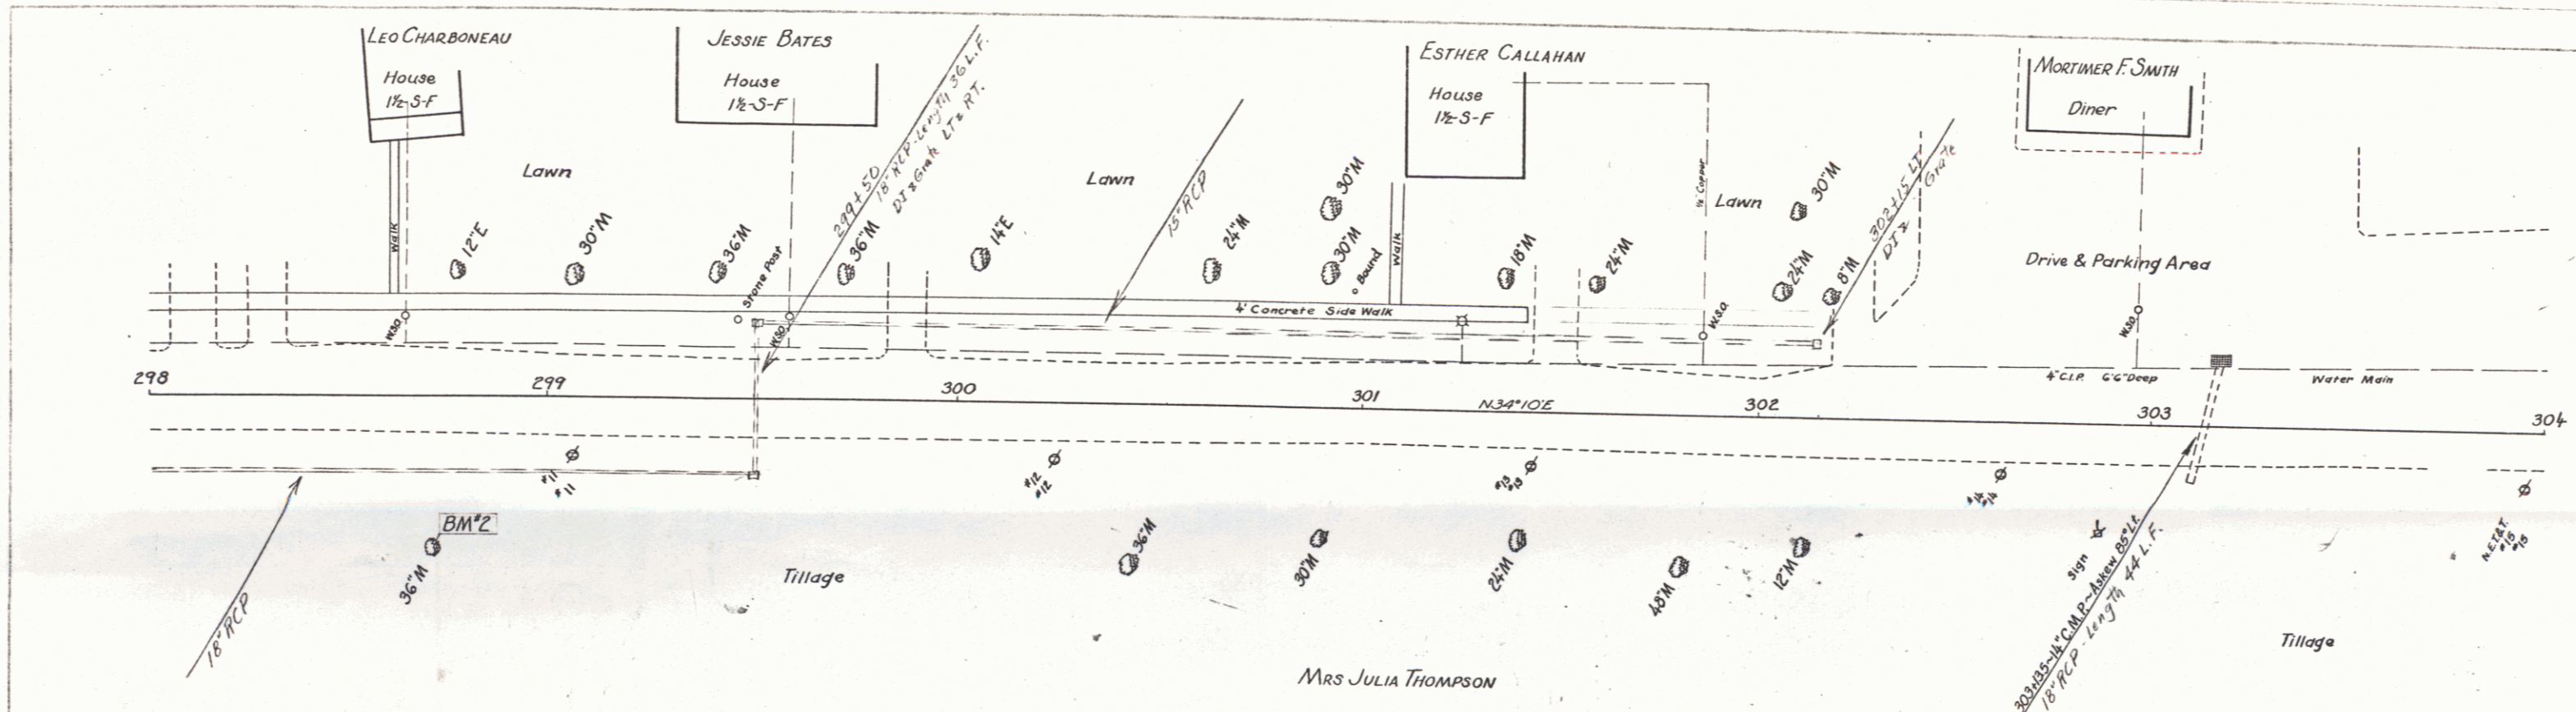

PLAN
 BROWNELL
 1/2" = 1'-0"

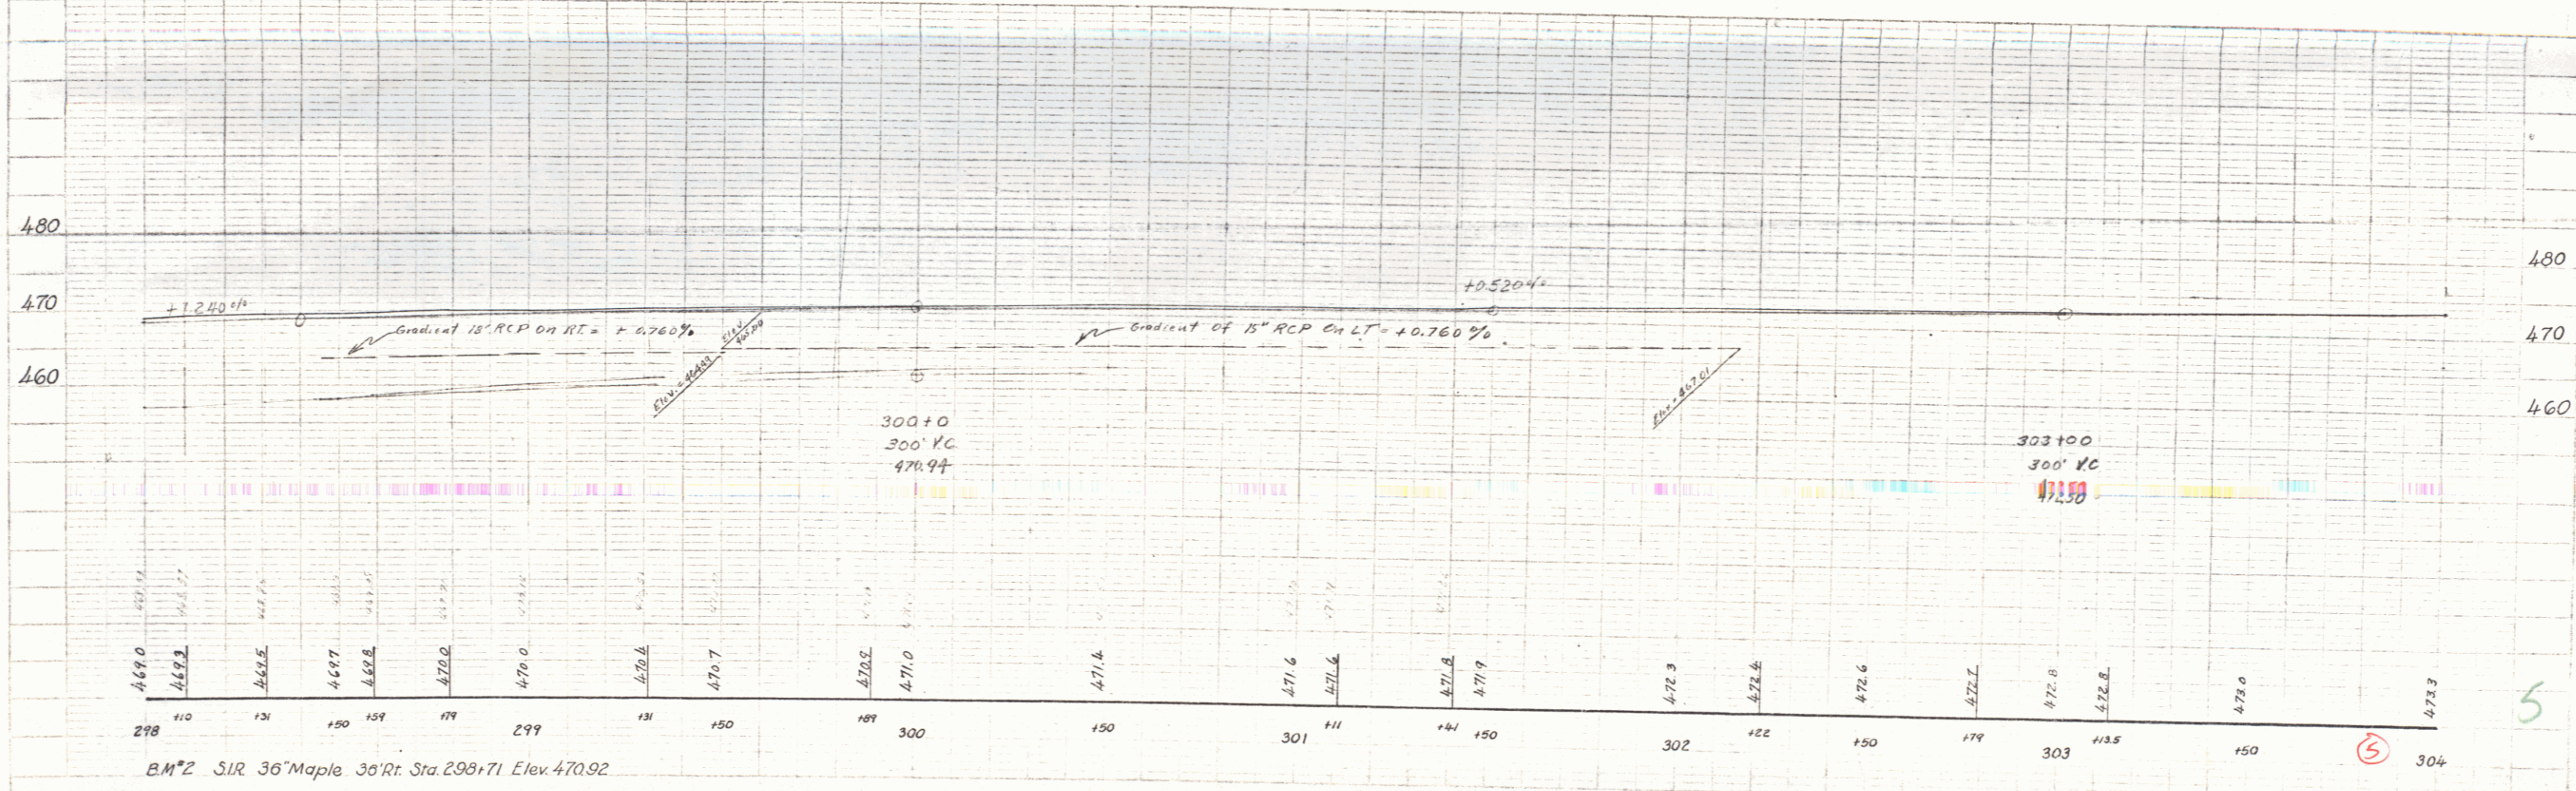

5