
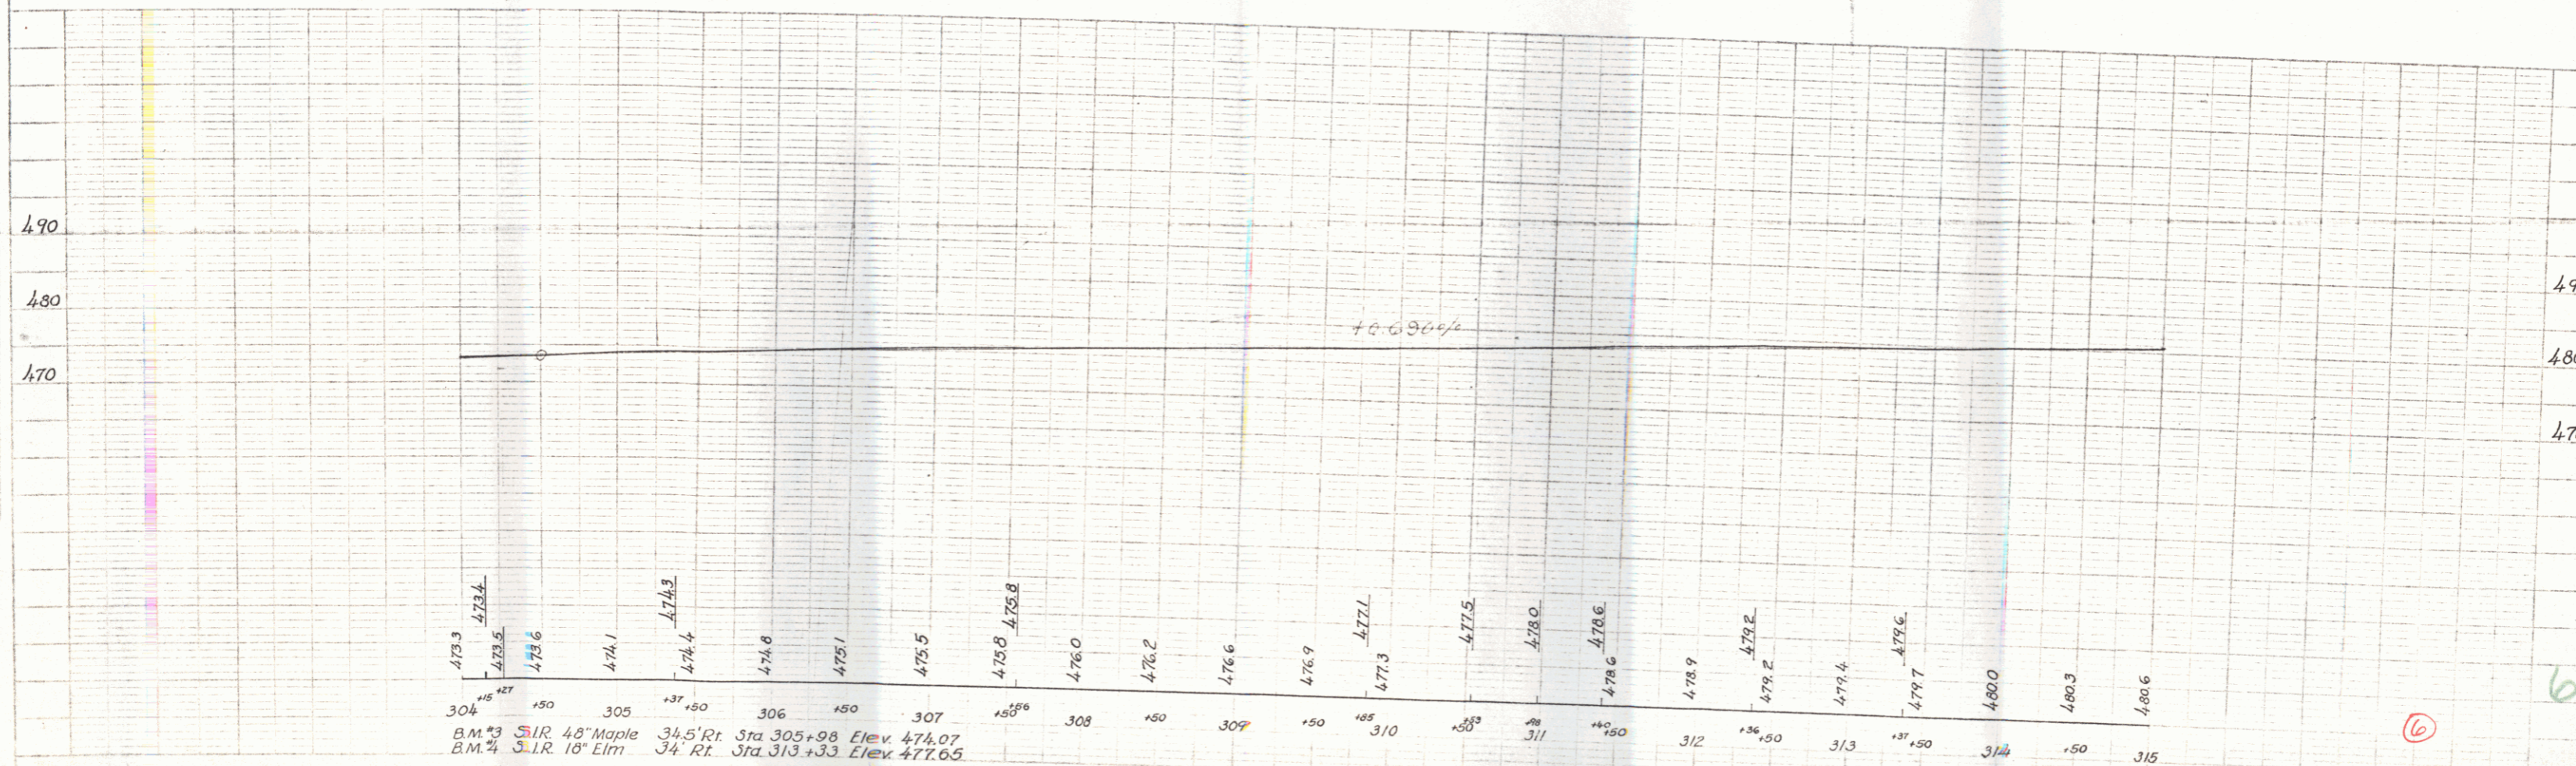


12-90
 1-11
 BIRNELL
 ADAMS
 1-11

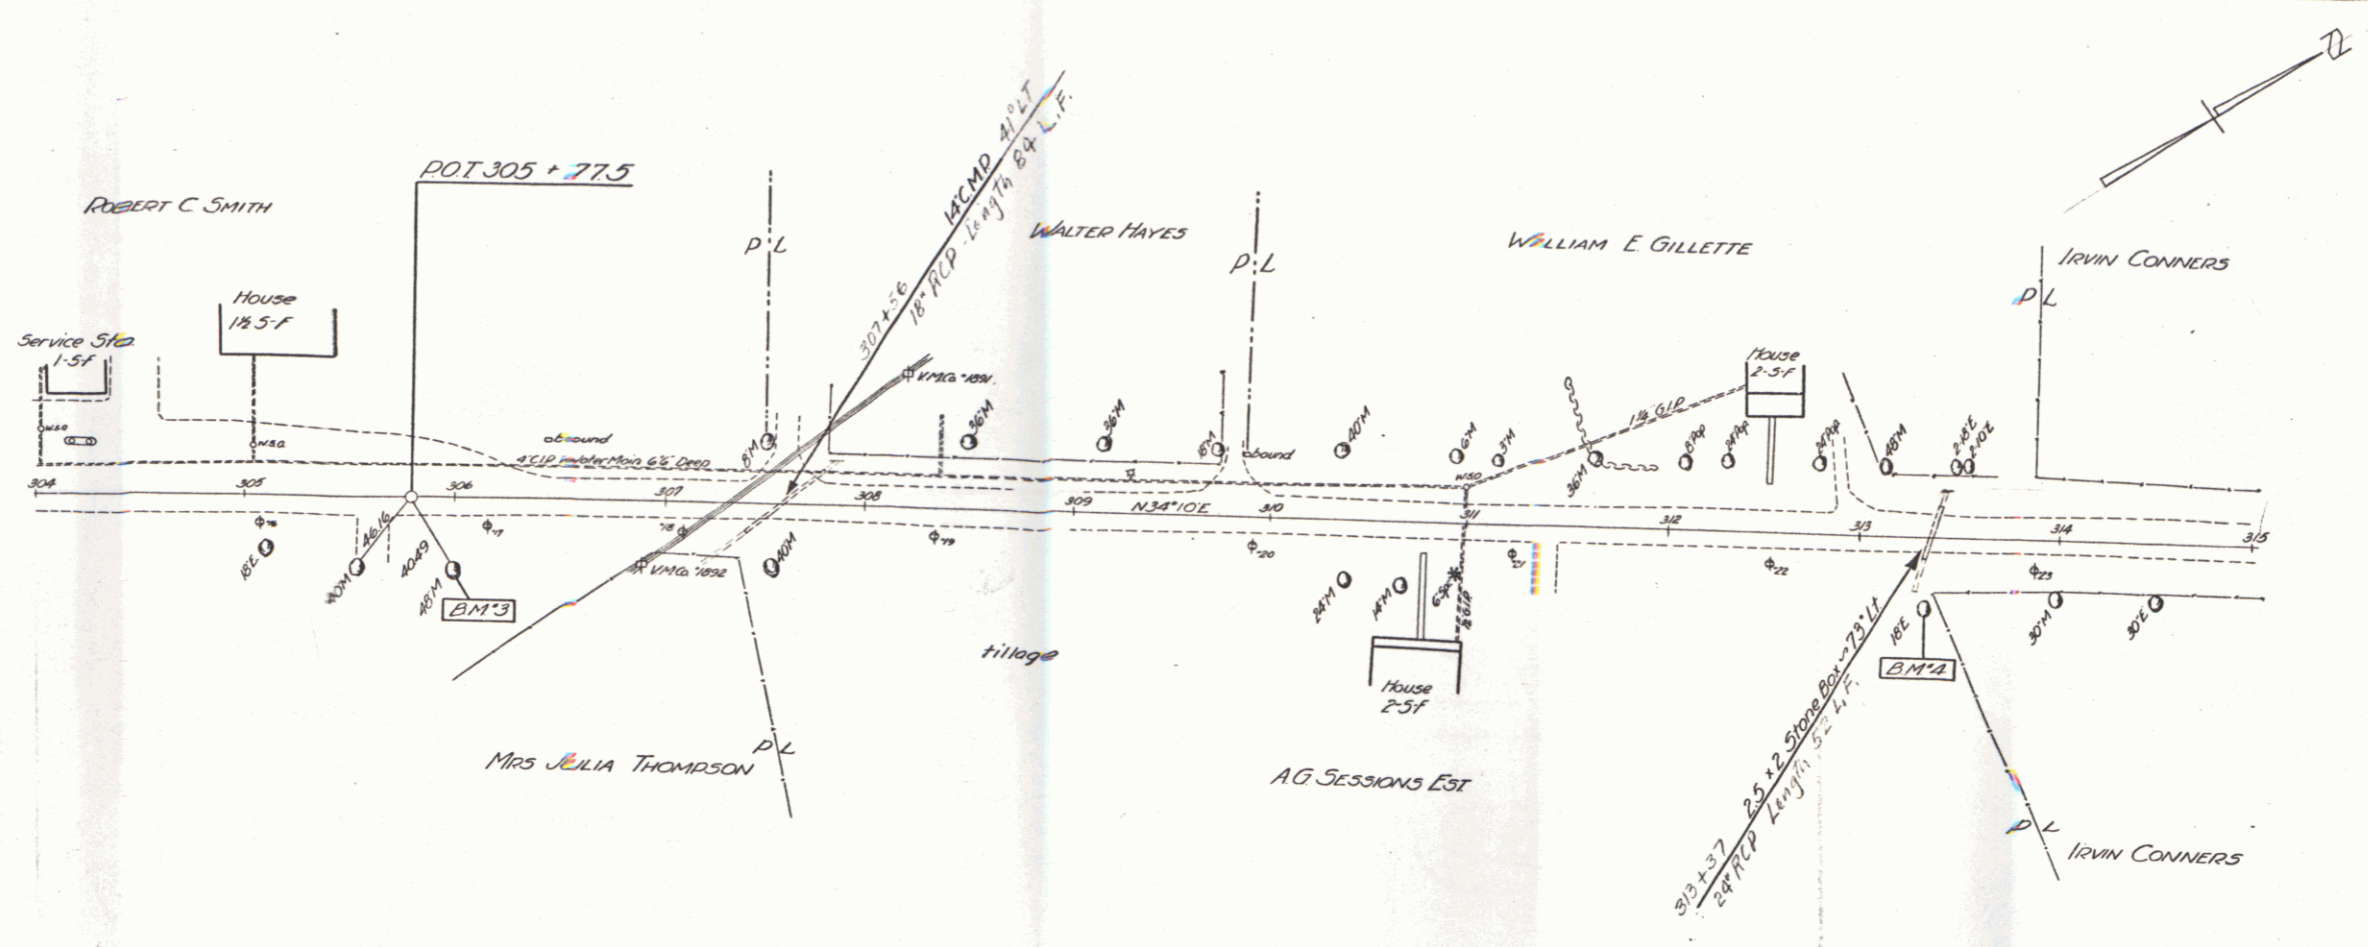

B.M. #3 S.I.R. 48" Maple Sta 305+98 Elev. 474.07
 B.M. #4 S.I.R. 18" Elm Sta 313+33 Elev. 477.65

6

MANCHESTER 92 M