
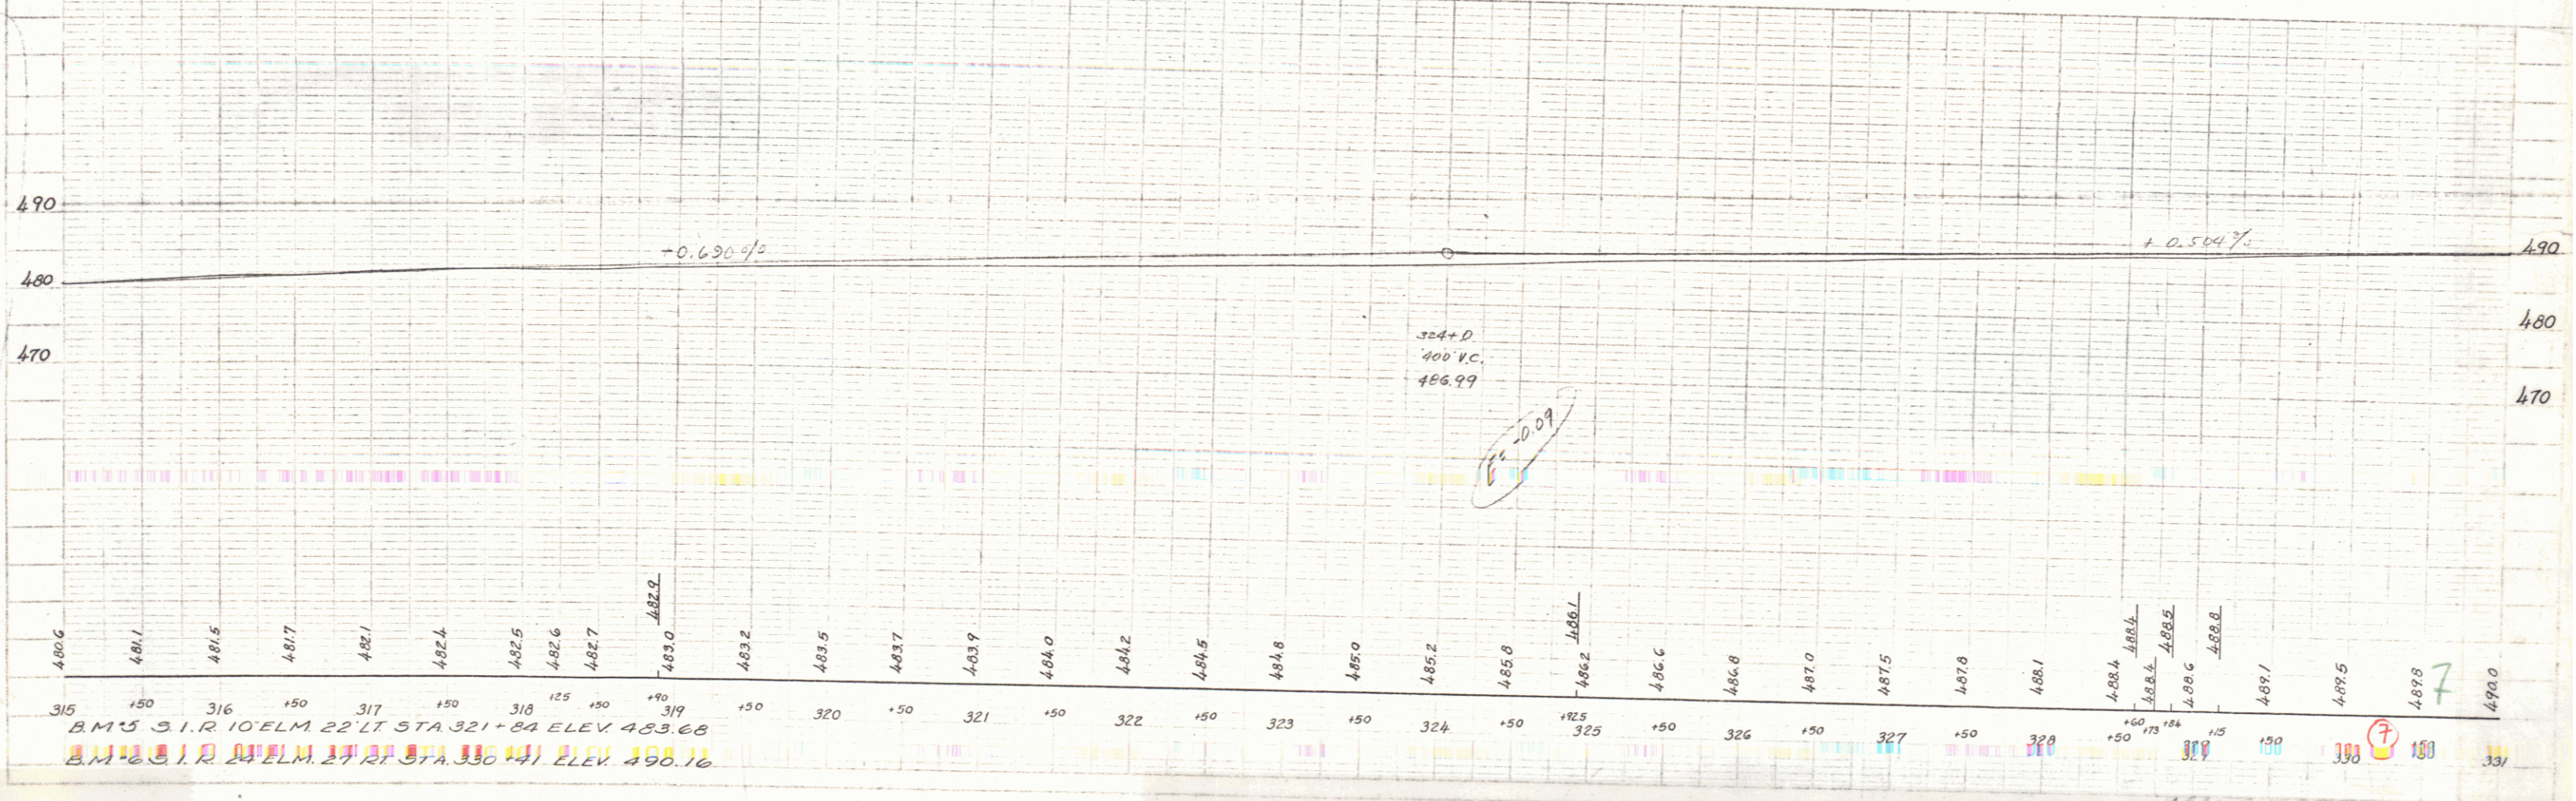


PLAN
 DATE 1949
 SCALE 1" = 40'
 PROJECT
 DRAWN BY
 CHECKED BY

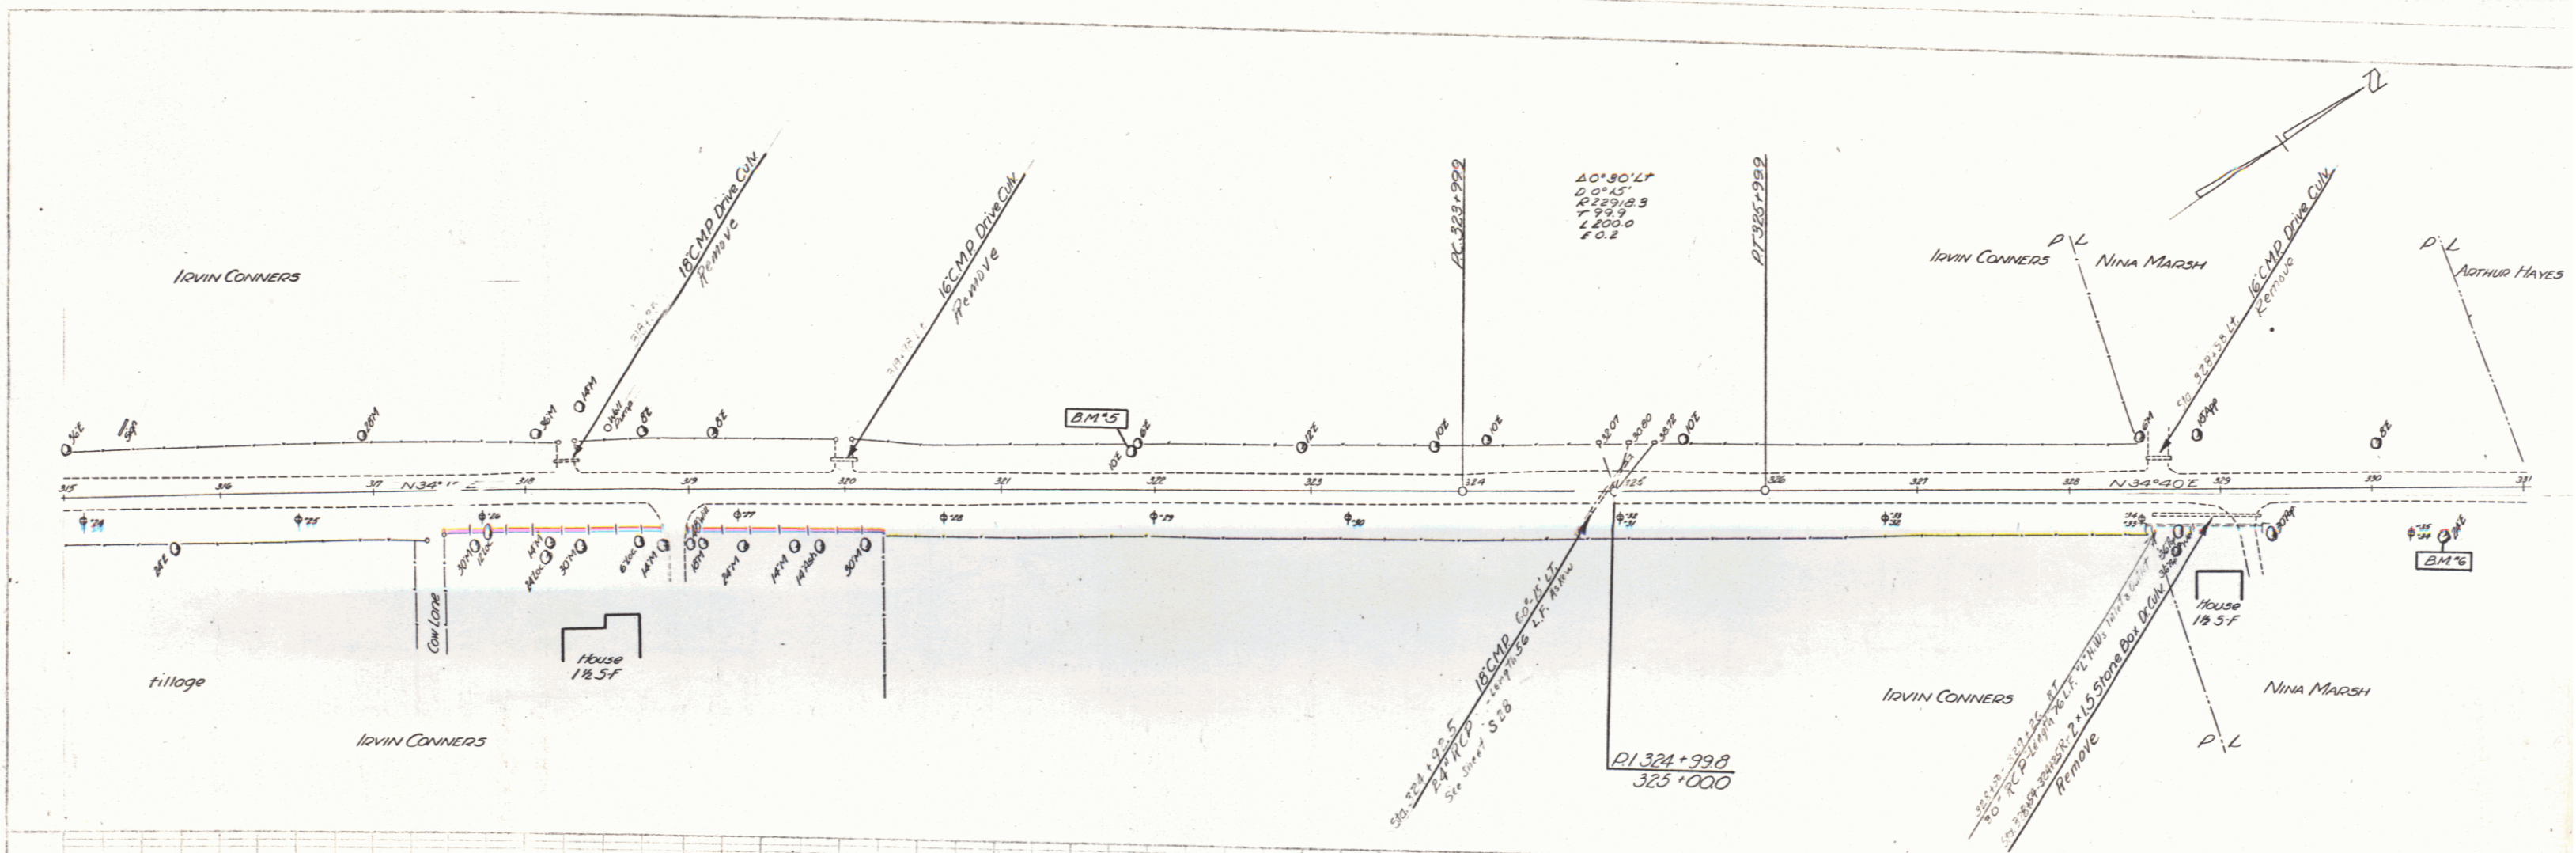

MANCHESTER ST 92' M