


PLAN
 DATE: Jan 16
 DRAWN BY: [illegible]
 CHECKED BY: [illegible]
 NOTE: [illegible]

PLAN
 DATE: Jan 16
 DRAWN BY: [illegible]
 CHECKED BY: [illegible]
 NOTE: [illegible]

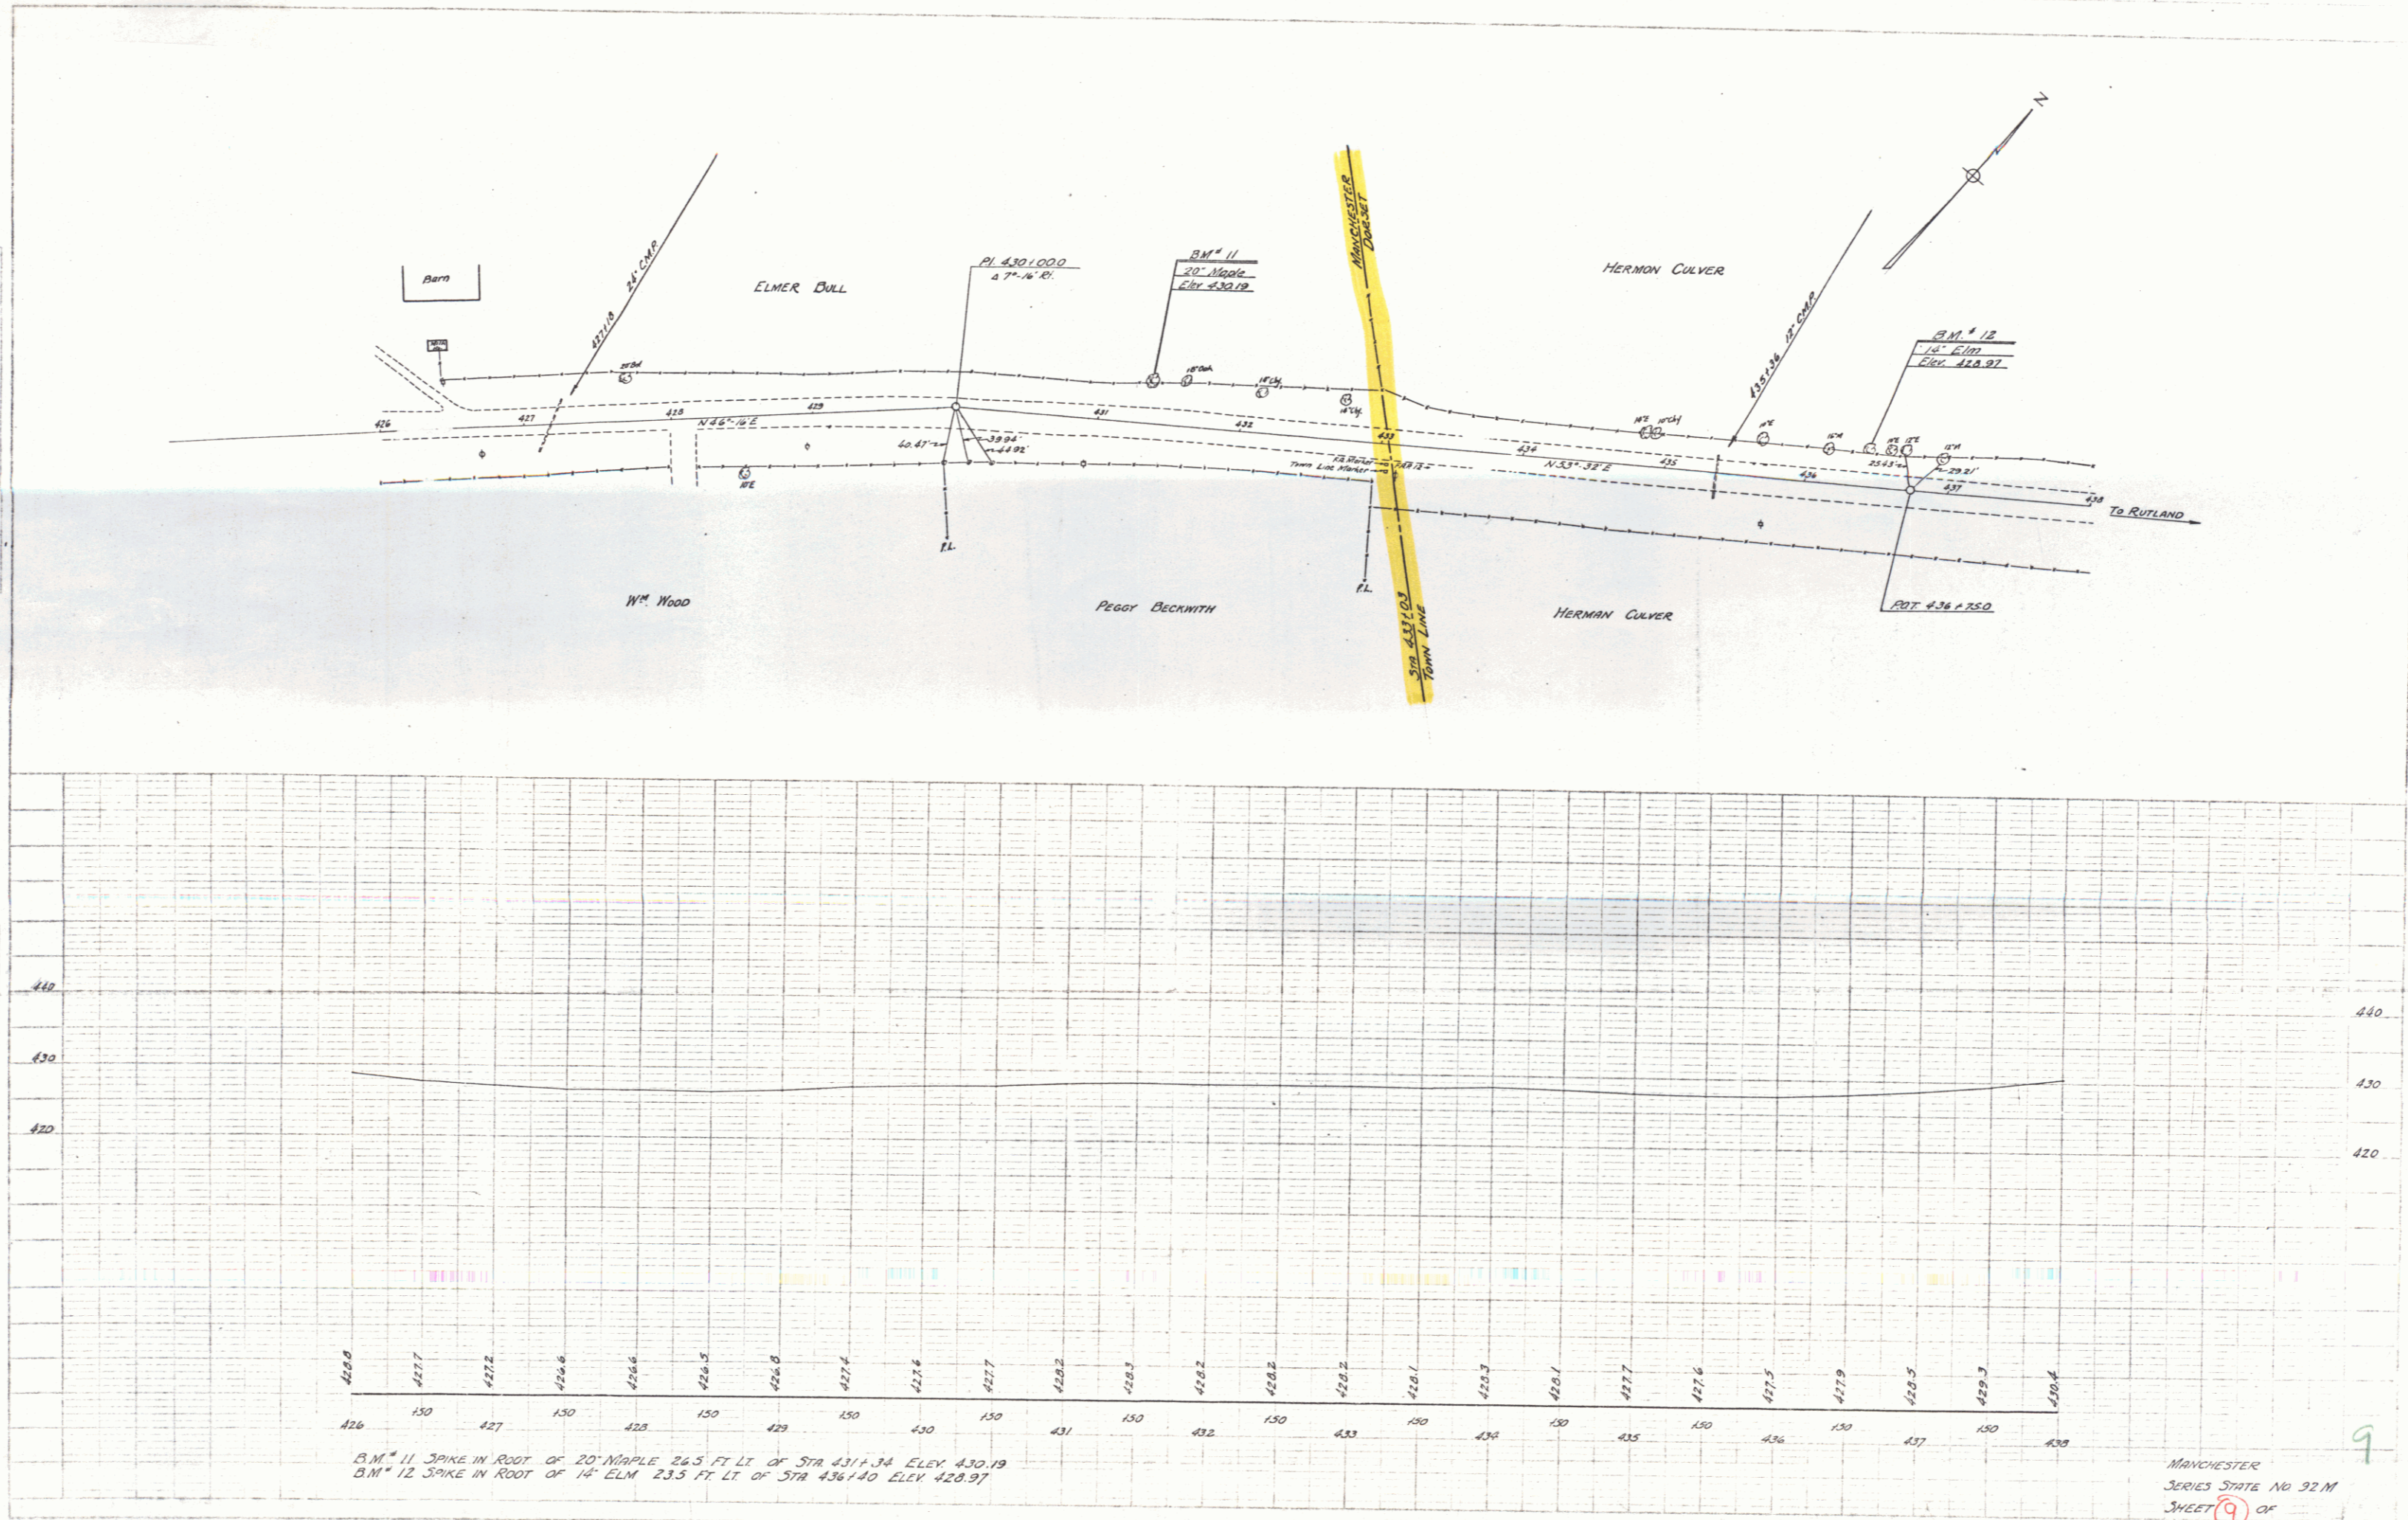

B.M. 11 SPIKE IN ROOT OF 20" MAPLE 26.5 FT LT OF STA 431+34 ELEV. 430.19
 B.M. 12 SPIKE IN ROOT OF 14" ELM 23.5 FT LT OF STA 436+40 ELEV. 428.97

MANCHESTER
 SERIES STATE NO 92.M
 SHEET 9 OF 9