

Town: Dorset  
 Route: US7  
 Project: S+12N  
 MP 3.62 - MP 4.21


Pin # 5  
 99RS  
 B.M. No 5  
 2 1/2" Elm  
 Elevation:

Curve 119  
 Δ 13° 23' 47"  
 D 2°  
 R 2564.3  
 T 336.1  
 L 663.2  
 E 13.7

B.M. No 3  
 16" Maple  
 Elevation: 82575

B.M. No 4  
 8" Butternut  
 Elevation: 82373

POT 210+500  
 (Traverse Sta 200+711)  
 (Δ 9° 22' 11" Eq 21.1)

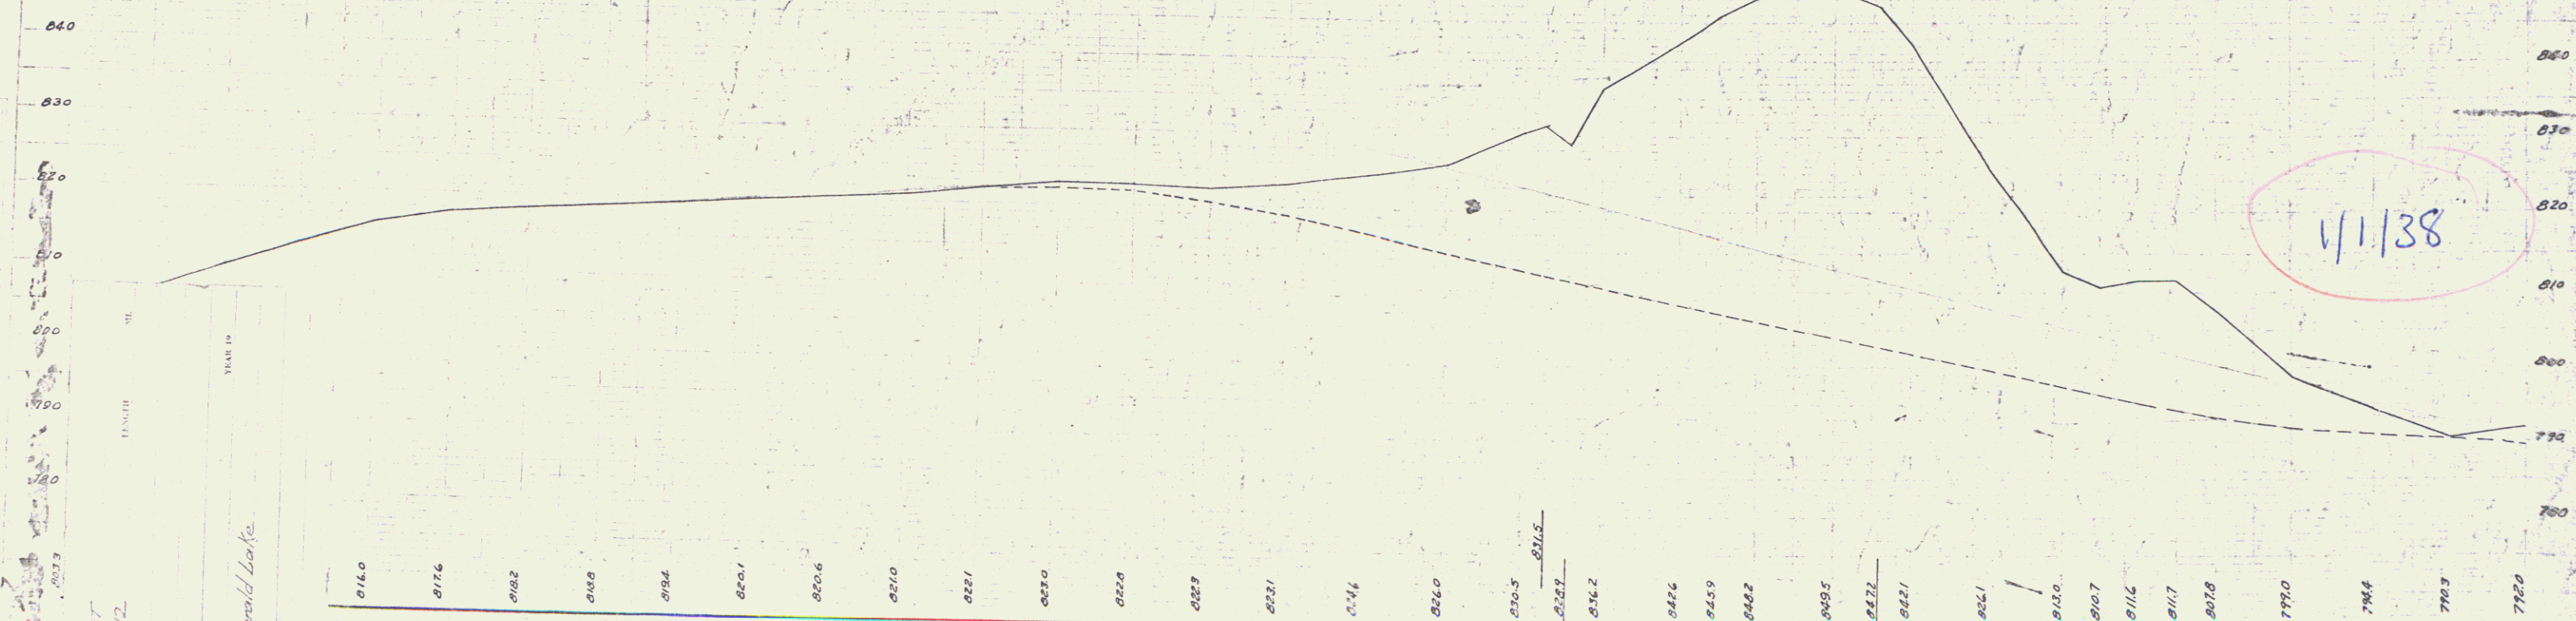

1/1/38

105 NR# 12 51R 18" Maple 27' H Sta 194+23 Elev 80575  
 4' 8" Butternut 47' H Sta 20+17 Elev 82373  
 30' Lf Sta 209+80 Elev 791.69

DIST. #1 PLANS