

STATE OF VERMONT
DEPARTMENT OF HIGHWAYS
RIGHT-OF-WAY PLANS
DETAIL SHEET
OF


TABLE OF PROJECT PROPERTY ACQUISITION

PARCEL NO.	GRANTOR	SHEET NO.	BEGINNING STATION	ENDING STATION	ACRES ±	REV ±	RIGHTS	TITLE TAKEN	DATE	TOWN OR CITY RECORDED	BOOK NO.	REMARKS	
1A	TOWN OF BENNINGTON	18-22	SA 3 31+80CL RT 7 CONN. 46+05 RT	RAMP B 38+9 RT SA 3 11+00CL	21.2 A	61.9A			COND	1-28-72	BENNINGTON	0-198 108	WATER PIPE LINE REMAINDER REFLECTS TAK- ING ON BENNINGTON F219-1(7)
B		18	SA 3 3+00CL SA 3 3+34RT	SA 3 11+00CL	0.6 A		DRAINAGE (P)						
C	DELETED												
D		18	SA 3 1+98CL	SA 3 6+00CL	N/A	N/A	CROSSING EASEMENT (P)					SA 3	
E		22	RAMP B 38+49 RT	482+32 RT	N/A	N/A	ALL R.T. S.I. TO TR 18						
F		22, 25	RAMP B 38+49 RT	TR 178 20+07	N/A	N/A	ALL RT S.I. TO TR 17						
G		28	542+35 LT	542+36 RT	N/A	N/A	ALL RT S.I. TO TR 14						
2	PORTER, KENNETH C. & BETSEY B.	22	490+11 LT	495+07 RT	2.5 A	NONE		WD	9-30-70	BENNINGTON	0-190 235	3 SHEDS, 1 SHOP, 1 HOUSE ADVANCED ACQ NON-PAR 3650 S.F. BENN TOWN EASE	
3A	LYONS, BALL L & EMILIE A	18-19	442+73 RT	461+42 RT	6.1 A	141.4 A		COND	11-18-71	BENNINGTON	0-195 145	4250 S.F. BENN TOWN EASE	
B		18	SA 3 1+00LT	SA 3 2+00LT	0.5 A		WELL & WATER LINE 0.14 AC BENN TOWN EASE						
		18	SA 3 0+25 LT	SA 3 1+75 LT			SLOPE (T) 950 S.F.						
		18	SA 3 0+75 RT	SA 3 1+25 RT			SLOPE (T) 430 S.F.						
		18	SA 3 0+25 LT				DRIVE (T)						
C		36	TR 17A 10+00 CL	TR 17A 19+44 RT	20 A		SLOPE (T) 0.16 AC					NON-PARTICIPATING 1000 S.F. BENN. TOWN EASE. WELL	
		36	TR 17A 13+00 LT	TR 17A 17+78 LT			SLOPE (T) 0.14 AC						
		36	TR 17A 15+00 RT	TR 17A 17+78 RT			DITCH (P)						
		36	TR 17A 17+00 LT				REMOVE PUMP HOUSE (T)						
		36	TR 17A 18+00 RT				REMOVE WELL (T)						

TABLE OF REVISIONS

REVISION NO.	SHEET NO.	DESCRIPTION OF REVISION	DATE	MADE BY	APPROVED BY
1	14, 18	Parcel #24 Change in Title Per Change Order # 1685	9-22-70	KMD	
2	13, 23	Parcel # 18A Showed Non- Participating On R.O.W. Plans 2014 Per Change Order # 1690	9-22-70	KMD	
3	9, 10, 14, 21, 24	MADE PARCELS # 30, 30, 35, 5, 7A, 1, 7B NON-PARTICIPATING PARCELS PER CHANGE ORDER # 1701	10-2-70	WJM	T.C.C.
4	13	PARCELS # 18B, 18C MADE NON- PARTICIPATING PER CHANGE ORDER # 1713	10-5-70	WJM	T.P.M.
5	15, 30 34, 2	PARCEL # 31 DIVIDED INTO 31A, 31A, 31A UNDER PROVISION PPM 80-1, PAR 70(2) PER CHANGE ORDER # 1721	10-20-70	WJM	T.P.M.
6	18, 19, 22, 24, 25	MADE VARIOUS PLAN (CORRECTIONS) CHANGES PER CHANGE ORDER # 1723	10-20-70	WJM	T.P.M.
7	13, 25 20, 2	PARCEL # 17A DIVIDED INTO 17A, 17D, 20, 21 MAKING 17D NON-PARTICIPATING PER CHANGE ORDER # 1725	10-20-70	WJM	T.P.M.
8	10, 11 23, 24 20, 1	PARCELS # 6A, 6B, 7C, & 7D REVISED P/L & NON-LIMITED ACCESS BETWEEN THE ABOVE PARCELS REVISED THE DIM & TAKE AREAS PER CO # 1749	11-3-70	KMD	T.P.M.
9	12, 13 25, 26 20, 14	PARCEL # 11D ADDED SPRING AT STA. RP 6" 24+79 LT AND LABELED AS 11D ALSO REMOVED 11D FROM SPRING AT STA. RP "H" 21+28 LT. PARCEL # 17A ADDED UNDER THE REMARKS COLUMN "SPRING HOUSE RP "S" 21+50 LT" AND "SPRING RP "H" 21+28 LT" PER CO # 1758	11-12-70	KMD	T.P.M.
10	25	PARCEL # 17 ADDED TRAILER, SEPTIC TANK AND WATERLINE ON PLANS PER CHANGE ORDER # 1765	11-24-70	KMD	T.P.M.
11		PARCEL # 37 CHANGED REMAINDER FROM 105.1A' TO 103.5A' DUE TO SALE OF LAND TO GRAS. PER CHANGE ORDER # 1766	11-15-70	RLS	
12	14, 17 28	PARCEL # 21 BONNE REVISE VALVE SYSTEM PER CHANGE ORDER # 1767	11-27-70	DEB	
13	13	PARCEL # 17 ADDED UNDER RE- MARKS "SAMUEL & MARTHA BASLEY CONNECTED TO SPRING AT PUMP "H" 21+28 LT" PER C.O. # 1772	12-30-70	KMD	T.P.M.
14	24	PLOTTED REVISED CENTER LINE PER CO # 1805	1-21-71	NBB	T.P.M.

MADE BY: W.C. DATE: 1-28-72
CHECKED BY: W.C. DATE: 1-28-72

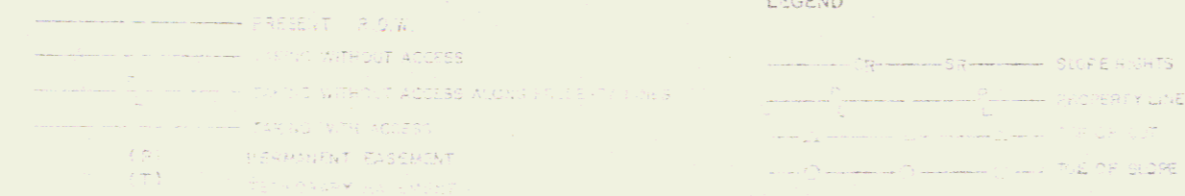

APPROVED: W.C. DATE: 1-28-72
APPROVED: W.C. DATE: 1-28-72
APPROVED: W.C. DATE: 1-28-72

PROJECT: BENNINGTON
NO: FO19-1(6)
SHEET: 9 OF 27