

*** JUTE MATTING - ITEM 523**

Rte. U.S. 7 Conn. Sta. 41+90 to 46+50 Rt.
 Rte. U.S. 7 Conn. Sta. 39+00 to 53+75 Mull.
 Ramp C Sta. 10+00 to 12+50 Rt.
 Ramp C Sta. 13+00 to 15+85 Lt.
 Ramp B Sta. 43+40 to 47+00 Lt.

STONE FILL FOR SLOPE PROTECTION
 (Light Type) - Item 512

Rte. U.S. 7 Conn. Sta. 4+00, Lt.
 Rte. U.S. 7 Conn. Sta. 52+70 to 53+50 Rt.
 Ramp C Sta. 16+00 Rt.
 Ramp C Sta. 15+85 to 17+50 Lt.
 Ramp C Sta. 12+50 to 15+00 Rt.
 Ramp C Sta. 14+95 to 15+20 Rt.
 Ramp B Sta. 47+80 to 47+80 Rt.

*** TREATED TIMBER CURB**
 ITEM 558

Ramp B Sta. 42+50 - 48+97, Rt.
 Ramp C Sta. 13+00 - 17+50, Rt.

*** DRILLING & BLASTING OF SOLID ROCK SUBGRADE - ITEM 115**


Rte. U.S. 7 Conn. Sta. 43+15 - 48+50
 Ramp C Sta. 10+00 - 12+55

*** THREE-CABLE GUARD RAIL, W/ LIGHT**
 STEEL - FOOTCANDY - ITEM 532

Ramp B Sta. 41+00 - 41+00, Lt.
 Ramp B Sta. 41+50 - 43+50, Rt.
 Ramp C Sta. 14+95 - 17+00, Rt.

PROFILES

Rte. U.S. 7 Conn. (Sheet No 54)
 Ramp B (Sheet No 55)
 Ramp C (Sheet No 57)

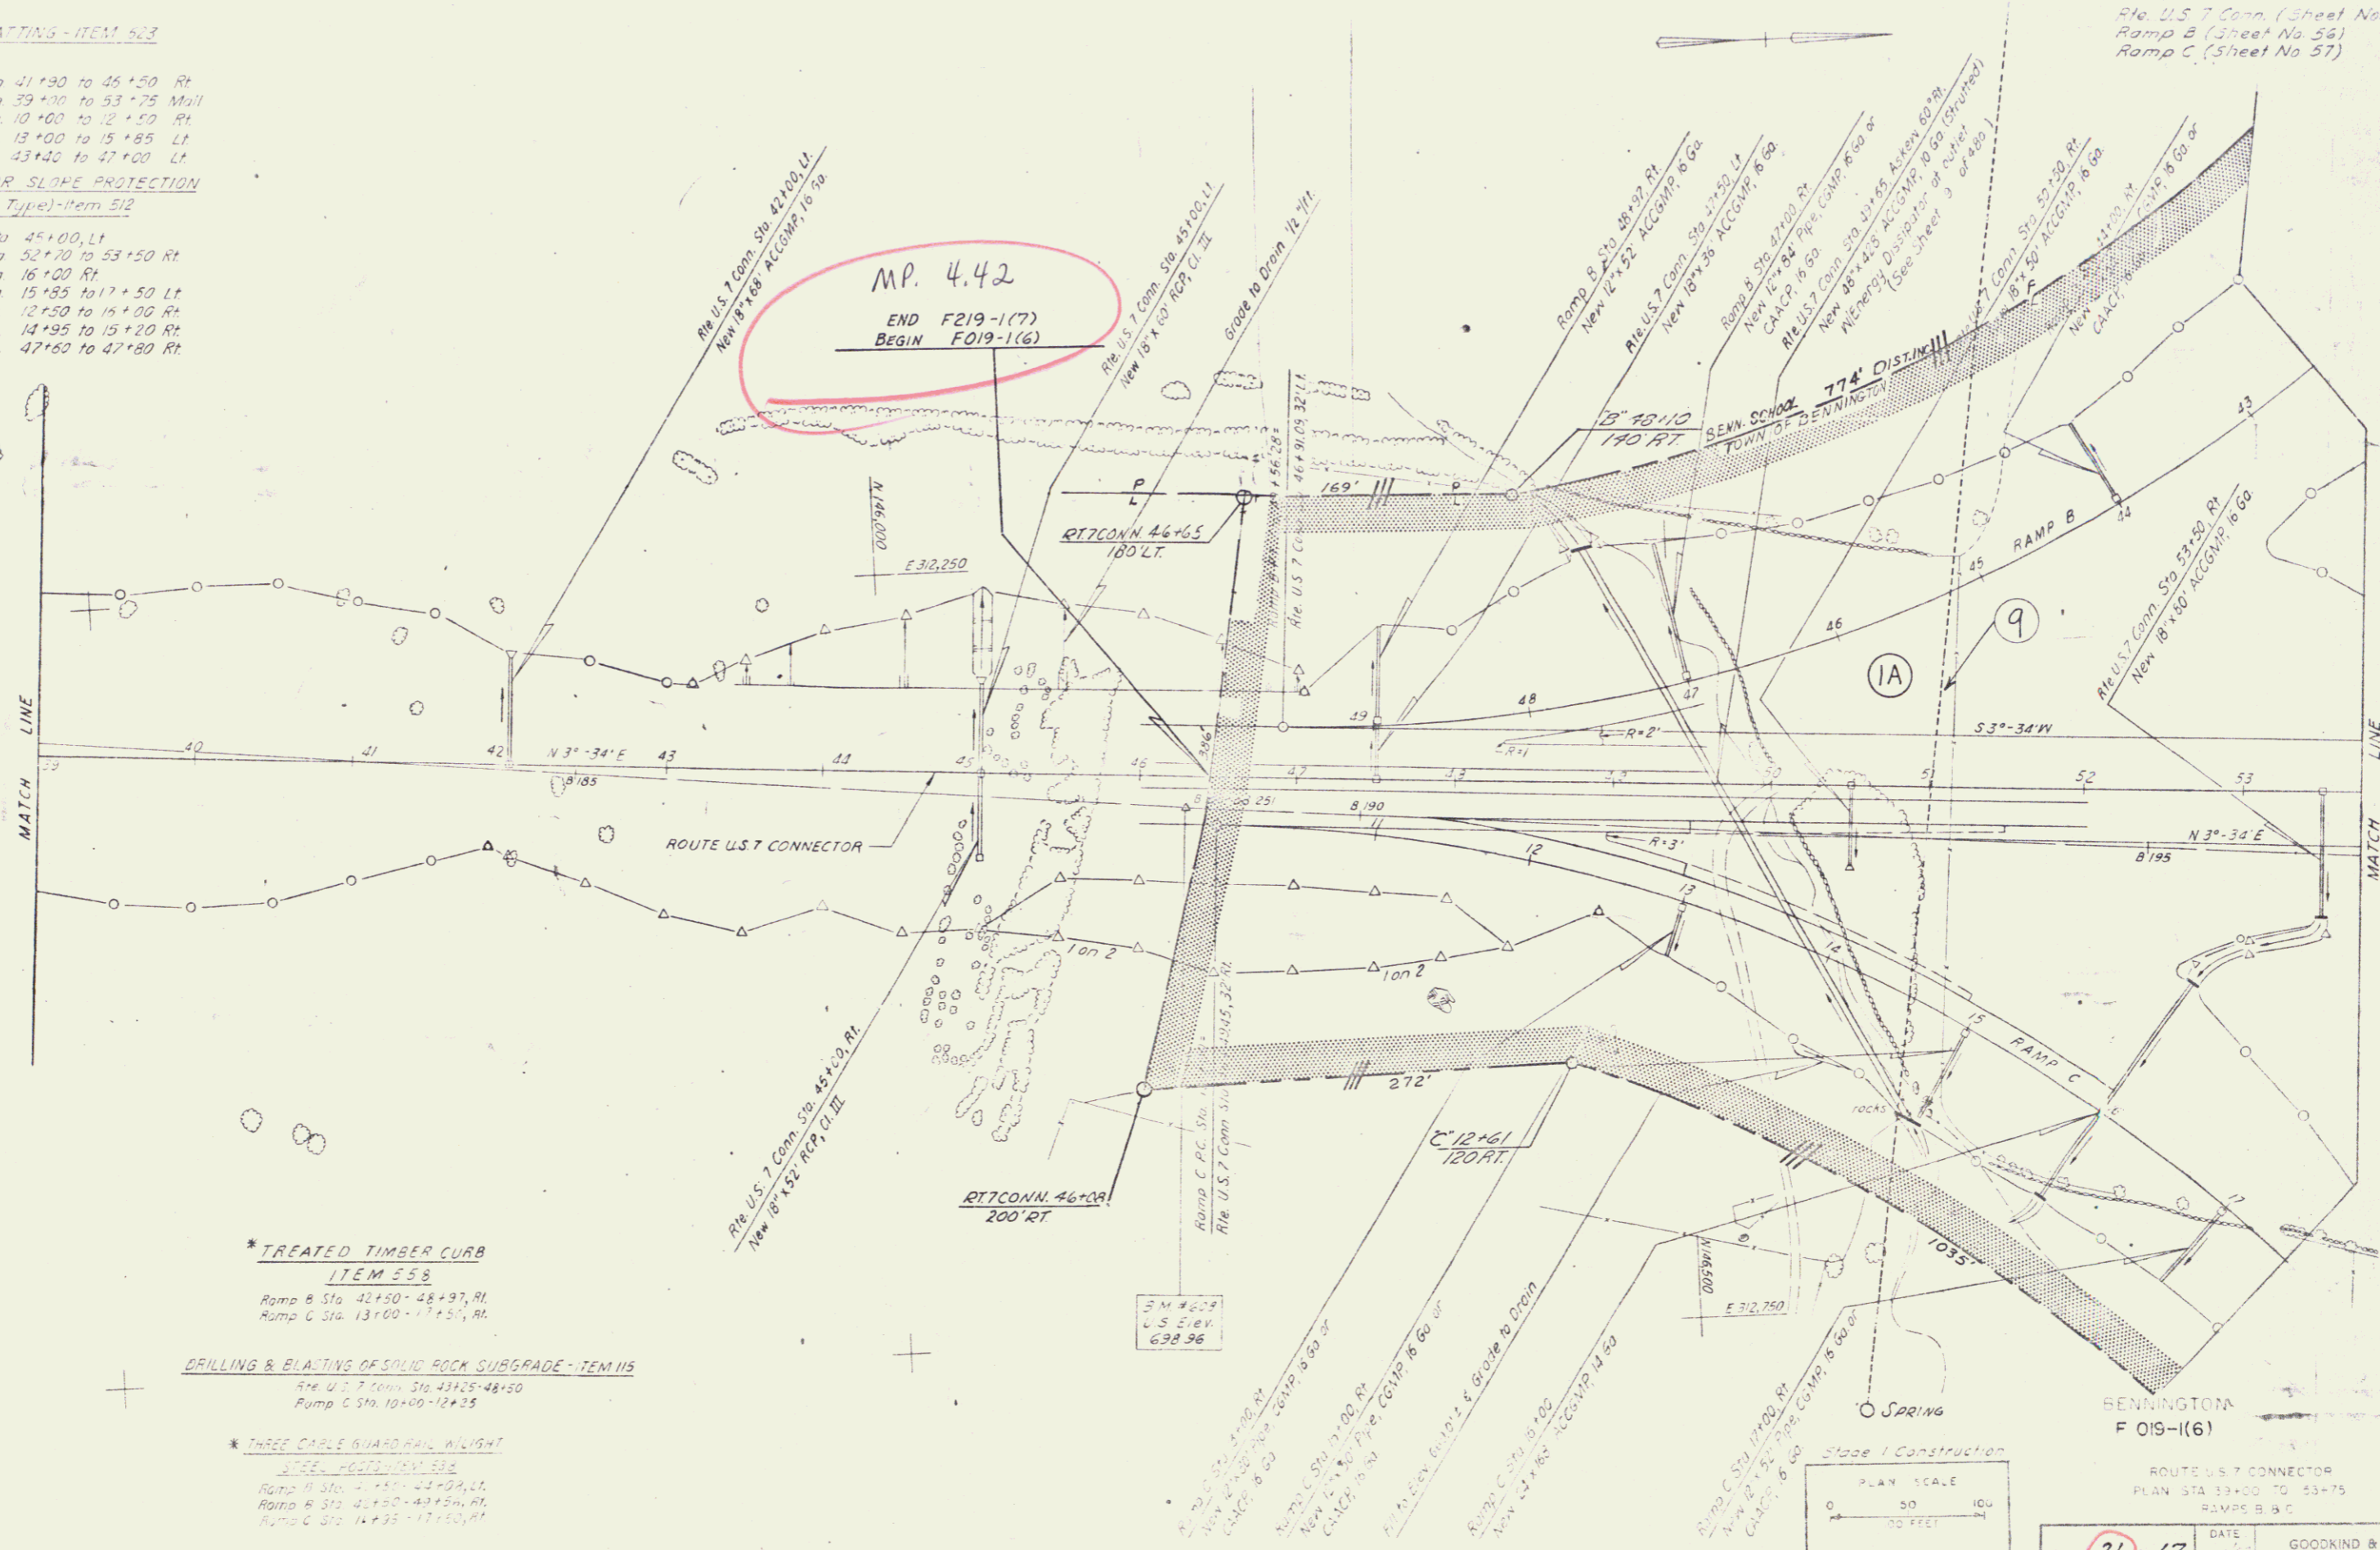

Sheet **21** of **67**

DATE

GOODKIND & ODEA
 CONSULTING ENGINEERS