

* JUTE MATTING - ITEM 623
 Ramp K Sta. 25+25 - 30+00, R1
 Ramp K Sta. 25+25 - 25+75, M11
 Ramp K Sta. 26+25 - 29+90, L1
 Ramp O Sta. 17+50 - 25+25, R1
 Ramp O Sta. 17+50 - 23+50, L1
 Ramp L Sta. 17+50 - 25+25, R1 & L1
 Ramp L Sta. 17+50 - 25+25, M11

STONE FILL FOR SLOPE PROTECTION (LIGHT TYPE) - ITEM 512
 Ramp K Sta. 29+90 - 30+00, L1
 DRILLING AND BLASTING OF SOLID ROCK
 SUBGRADE - ITEM 115
 Ramp L Sta. 17+50 - 25+25
 Ramp K Sta. 25+25 - 29+25
 Ramp O Sta. 18+25 - 25+25


RAMP L CURVE DATA

Δ	68°-45'-30" R1
D	18°-07'-54"
R	316.00'
T	216.20'
L	379.22'
E	66.88'
Bank	1'11" R1
P.I.	N 154,436.79
	E 311,515.39'

RAMP L CURVE DATA

Δ	70°-35'-08" R1
D	14°-19'-26"
R	400.00'
T	283.14'
L	432.78'
E	90.07'
Bank	1'11" R1
P.I.	N 154,925.32
	E 311,412.02

* GRANITE SLOPE EDGING
 ITEM 556-A
 Ramp L Sta. 17+50 - 25+25, M11
 Ramp L Sta. 17+50 - 25+25, R1
 Ramp K Sta. 25+25 - 25+88, M11
 Ramp K Sta. 25+25 - 30+00, R1

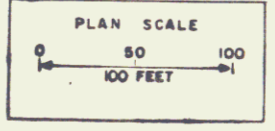

BENNINGTON
 F 019-1(6)
 RAMP S, K, L, B, O.

Sheet 33 of 67 DATE 11/10/67
 GOODKIND & O'DEA
 CONSULTING ENGINEERS

In Charge of
 A.L.P.
 Made by
 R.G.F.S.
 Checked by
 S.L.H.R.

* Indicates Stage 2 Construction