

NORTHBOUND CURVE DATA

Δ	66°-32'-00" Rt.
D	1704'-00"
R	5371.48'
T	2546.32'
L	6268.75'
E	1065.07'
Bank	1/2 MI RT
RI	N 155° 36' 16.60"
	E 310° 15' 1.87"

SOUTHBOUND CURVE DATA

Δ	63°-39'-00" Rt.
D	1702'-00"
R	5544.75'
T	3441.25'
L	6158.56'
E	981.07'
Bank	1/2 MI RT
RI	N 755° 40' 59"
	E 210° 06' 37.73"

*** TREATED TIMBER CURB-ITEM 558**

N.B. Sta. 587+50 - 589+00, Rt.
 S.B. Sta. 574+78 - 581+00, Rt.
 S.B. Sta. 587+50 - 590+27, Rt.
 Ramp M Sta. 15+30 - 22+10, Rt.

*** LUTE MATTING-ITEM 623**

N.B. Sta. 584+80 - 583+00, Lt.
 N.B. Sta. 578+40 - 585+90, Rt.
 S.B. Sta. 574+78 - 580+50, Lt.

STONE FILL FOR SLOPE PROTECTION (Light Type)-ITEM 512


N.B. Sta. 582+50, Lt.
 N.B. Sta. 574+00 - 578+40, Rt.
 N.B. Sta. 585+30 - 589+00, Rt.
 S.B. Sta. 574+78 - 585+90, Rt.
 S.B. Sta. 580+00, Lt.
 S.B. Sta. 580+00, Rt.
 S.B. Sta. 588+50, Lt.

*** THREE CABLE GUARD RAIL W/LIGHT STEEL POSTS ITEM 538**

S.B. Sta. 586+69 - 590+27, Lt.
 S.B. Sta. 587+00 - 590+27, Rt.
 N.B. Sta. 586+50 - 589+00, Rt.
 N.B. Sta. 585+50 - 589+00, Lt.
 N.B. Sta. 574+00 - 580+97, Lt.
 S.B. Sta. 571+78 - 582+46, Lt.
 S.B. Sta. 574+78 - 579+49, Lt.
 Ramp M Sta. 10+00 - 22+10, Rt.

DRILLING AND BLASTING OF SOLID ROCK SUBGRADE-ITEM 115

N.B. Sta. 579+25 - 580+75

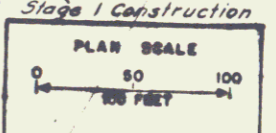

BENNINGTON
 F 019-(6)

PLAN STA. 574+00 TO 589+00 NB
 RAMP M.

Sheet 34 of 67 DATE 1/14/69
 GOODKIND & O'NEAL CONSULTING ENGINEERS

In Charge of A.J.P.
 Made by C.W.S.L.
 Checked by S.T.E.W.P.