

* DRILLING AND BLASTING OF SOLID ROCK
SUBGRADE - ITEM 115
N.B. Sta. 597+75 - 604+00
S.B. Sta. 600+25 - 605+75

411 U.S. S.B. Sta. 591+00
Begin Speed Change Lane
Total Length 230.64'

SHEET 34

MATCH

37A

* THREE CABLE GUARD RAIL W/LIGHT STEEL POSTS
ITEM - 538

S.B. Sta. 590+27 - 596+05, L.I.
S.B. Sta. 590+27 - 592+60, R.I.
N.B. Sta. 589+00 - 589+54, R.I.
N.B. Sta. 589+00 - 590+30, L.I.

DRILLING & BLASTING OF SOLID ROCK SUBGRADE
ITEM 115

S.B. Sta. 600+25 - 605+75
N.B. Sta. 597+75 - 604+00

* CUTE MATTING - ITEM 623

N.B. Sta. 589+40 - 604+00, R.I.
N.B. Sta. 590+22 - 591+80, L.I.
N.B. Sta. 589+00 - 604+00, L.I.
N.B. Sta. 589+40 - 589+40, L.I.
S.B. Sta. 595+30 - 605+75, R.I.
S.B. Sta. 596+25 - 605+75, L.I.

STONE FILL FOR SLOPE PROTECTION
(Light Type) - ITEM 512

N.B. Sta. 592+25, L.I. - S.B. 593+75, R.I.
N.B. Sta. 589+40 - 590+20, L.I.
N.B. Sta. 589+40 - 589+60, R.I.
S.B. Sta. 590+60 - 592+60, R.I.
S.B. Sta. 593+75, L.I.
S.B. Sta. 593+75 - 593+90, R.I.
S.B. Sta. 595+20 - 596+25, L.I.
N.B. Sta. 591+50 - 593+00, R.I.

* TREATED TIMBER CURB - ITEM 558

S.B. Sta. 590+27 - 591+50, R.I.

In Charge of
Checked by

Checked by


Checked by

Checked by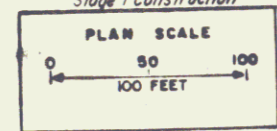

Sheet 35 of 67 1/14/69

GOODYER & GOODYER CONSULTING ENGINEERS